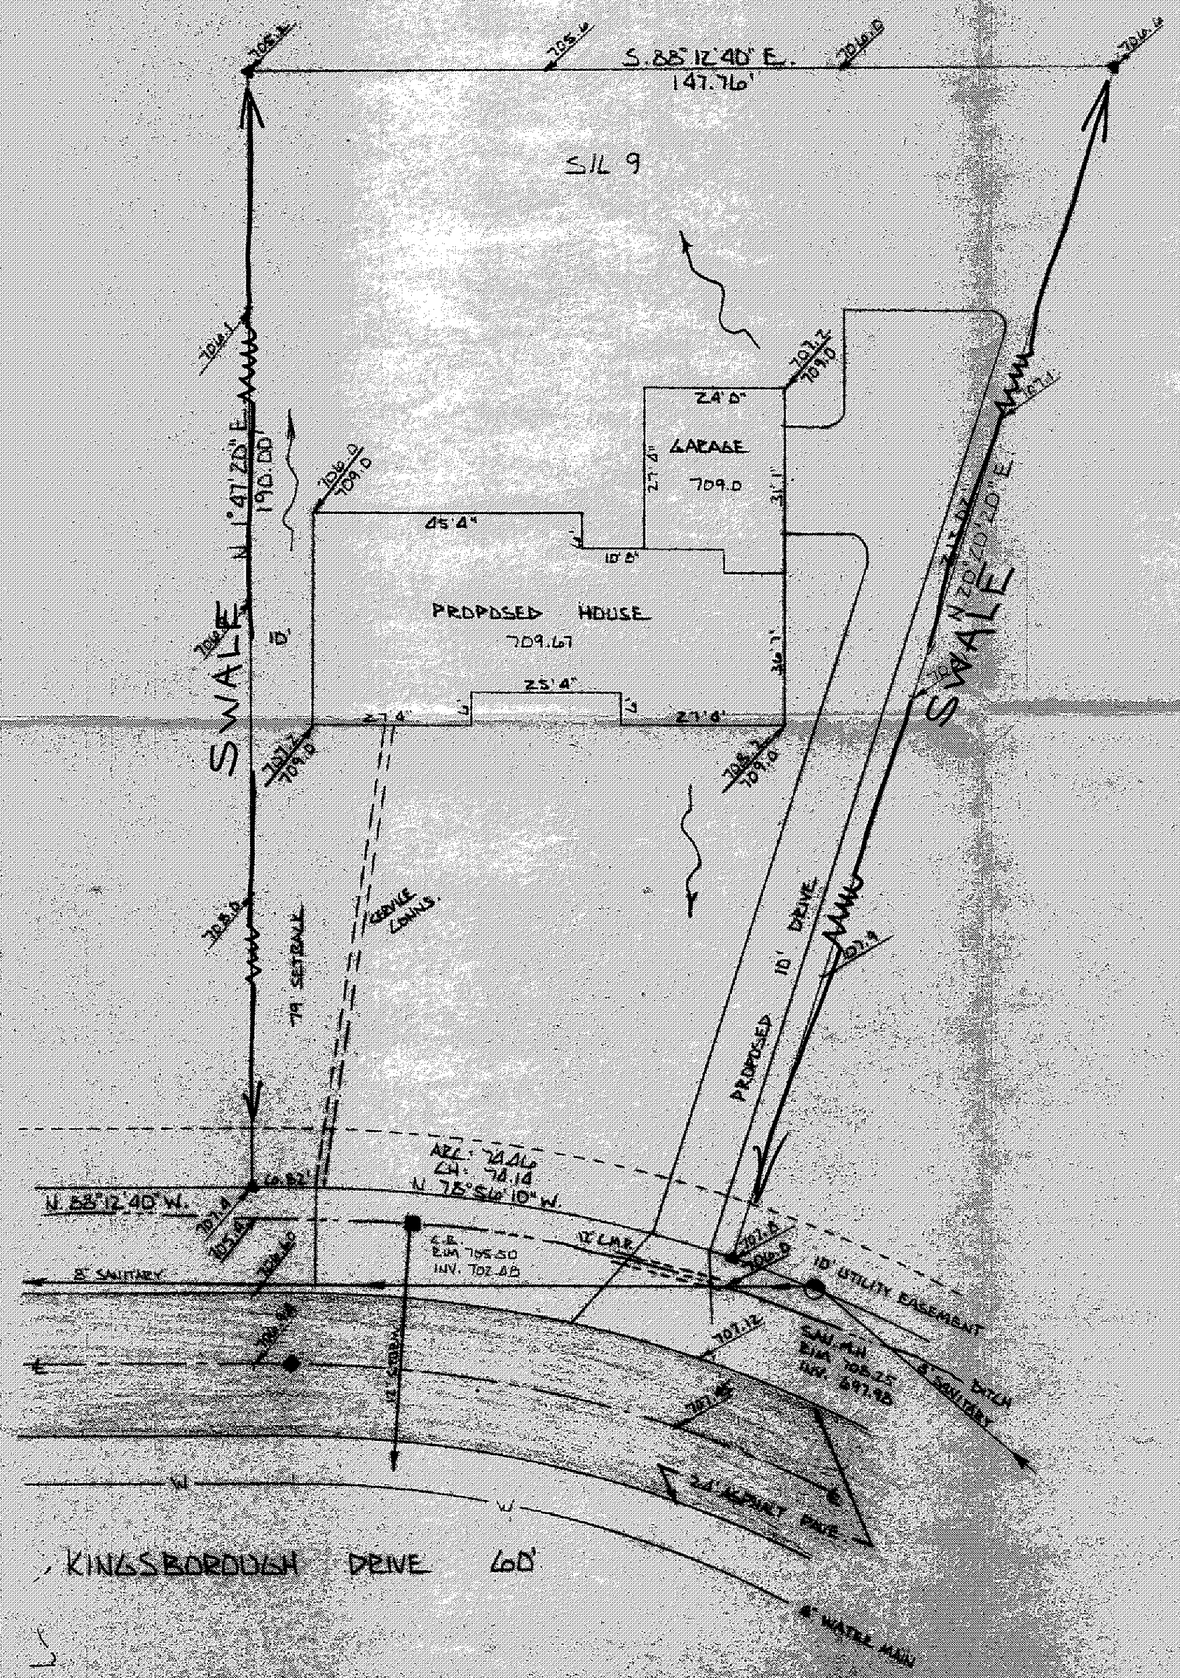

PAINESVILLE TOWNSHIP
ZONING O.K.
PENDING DRAINAGE
R. M. Hall
Zoning Inspector

Grading Plan Approved
as shown and/or noted
THOMAS P. GILLES, P.E.
Lake County Eng.
By [illegible] 11-28-78

I CERTIFY THAT THIS PLAN WAS PREPARED BY ME AND IS CORRECT TO THE BEST OF MY KNOWLEDGE AND BELIEF.

REG. SURVEYOR S-6356

JOHN L. SLONIECZNY
7739 VIEWMOUNT DRIVE
CONCORD OHIO 44077
352-7742

● IRON PIN SET

SITE PLAN FOR
ROY SLAYTON : SON CONST.

SCALE 1"=20'	APPROVED BY JLS	DRAWN BY S
DATE 13 NOV 78		
OF SIL 9 KINGSBOROUGH SUBD.		X-36
TOWNSHIP OF PAINESVILLE LAKE COUNTY		SH
		DRAWING NUMBER 78-2