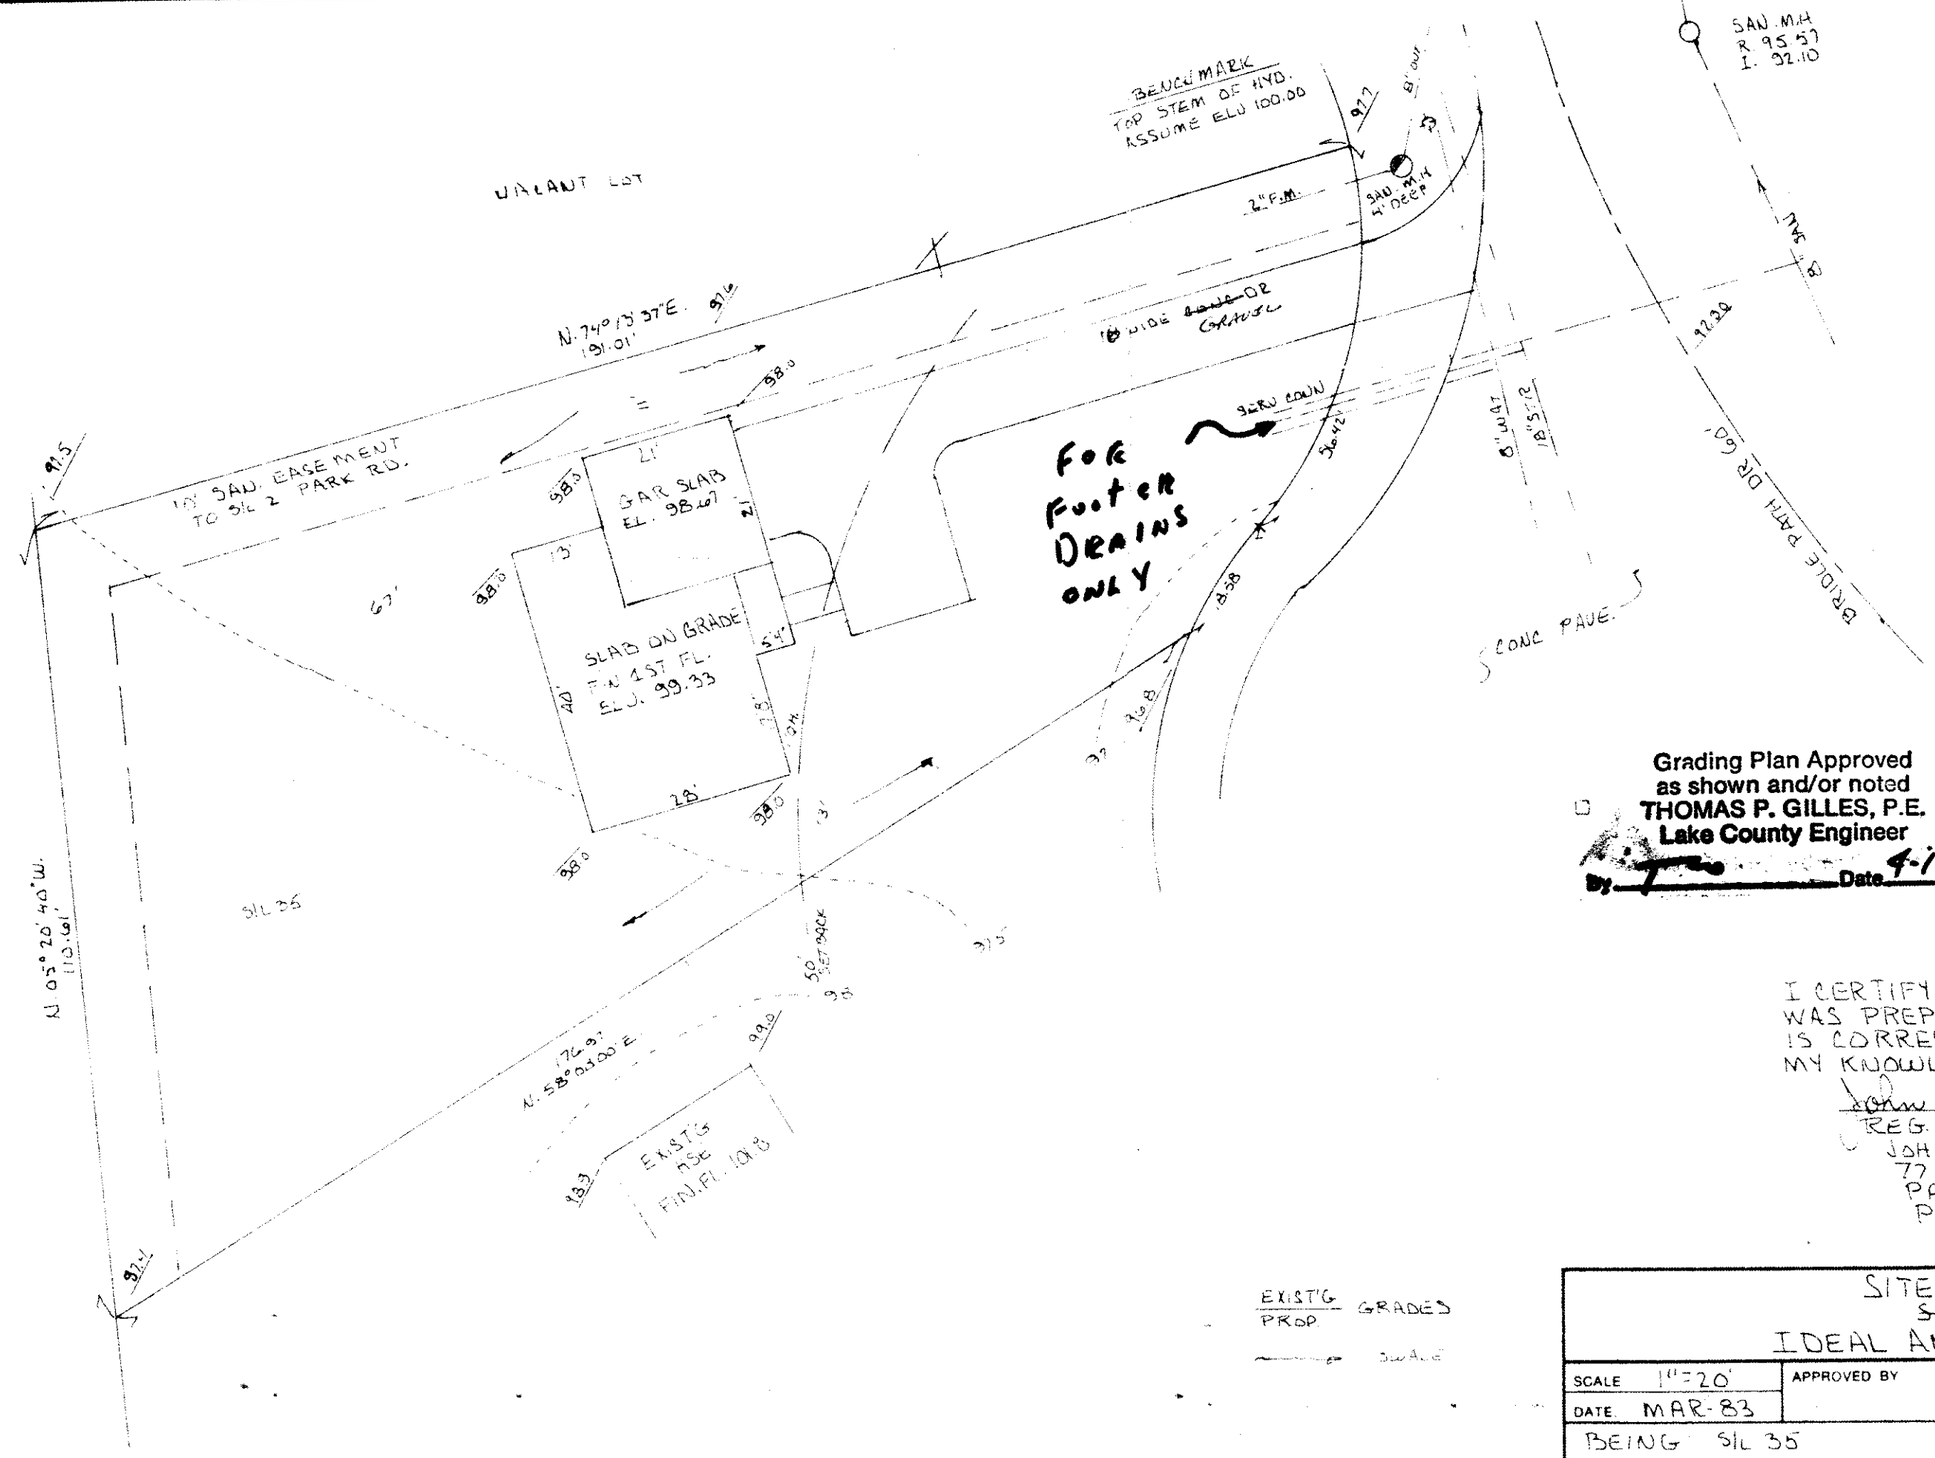

EXIST'G / PROP. GRADES

This Permit Expires
MAR 2 6 1984

PAINESVILLE TOWNSHIP
ZONING APPROVED
5687
R. M. Hale
Zoning Inspector 3/26/83

Grading Plan Approved
as shown and/or noted
THOMAS P. GILLES, P.E.
Lake County Engineer
By: _____ Date 4-1-83

I CERTIFY THAT THIS PLAN WAS PREPARED BY ME AND IS CORRECT TO THE BEST OF MY KNOWLEDGE AND BELIEF.

John C. Skowieczny
REG. SURVEYOR # 6356
JOHN C. SKOWIECZNY
7739 VIEWMOUNT DR
PAINESVILLE OHIO
PH 352-7742

SITE PLAN
for
IDEAL AMERICAN HOMES

SCALE 1" = 20'	APPROVED BY	DRAWN BY J.C.S.
DATE MAR-83		PLAT Y-4
BEING SIL 35	SIERRA PARK SUBDIVISION	
TOWNSHIP OF PAINESVILLE	COUNTY OF LAKE	STATE OF OHIO
		DRAWING NUMBER 83-386

TELEDYNE POST 18AB-01E