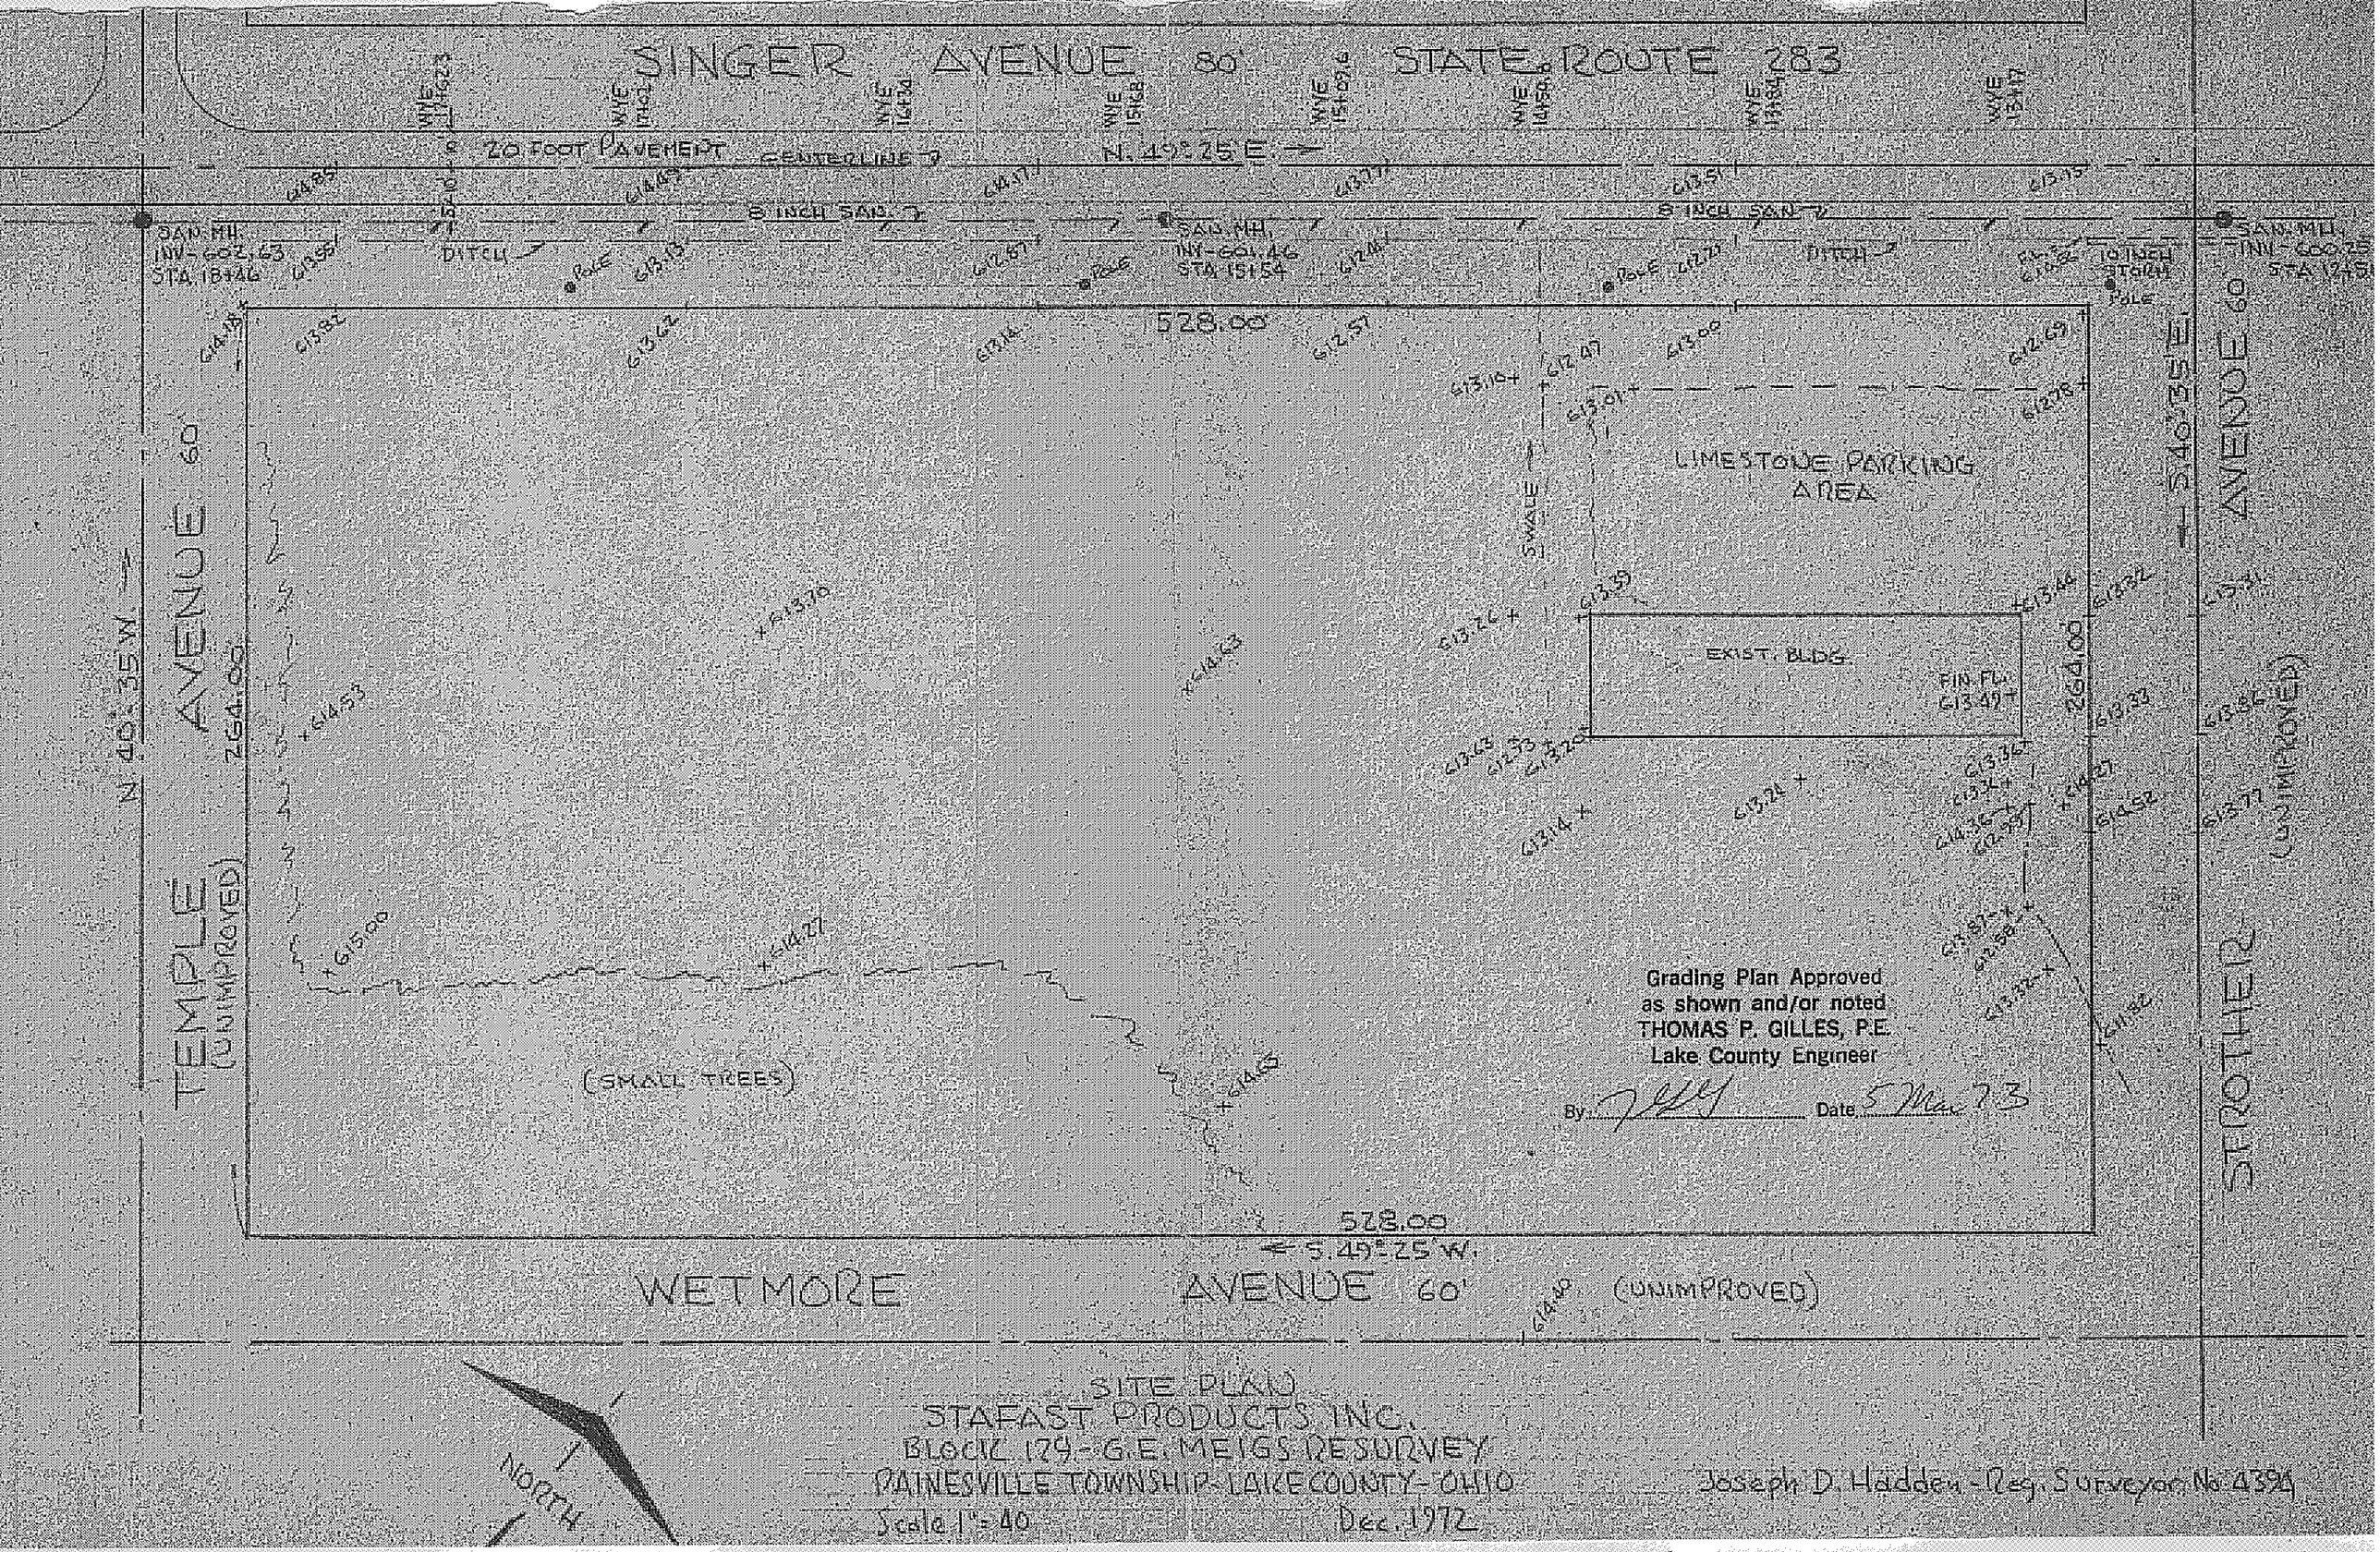
SINGER AVENUE 80' STATE ROUTE 283
20 FOOT PAVEMENT
CENTERLINE
N. 49°25' E.
8 INCH SAN.
SAN. MH. INV-602.63 STA. 18+46
SAN. MH. INV-601.46 STA. 15+54
SAN. MH. INV-600.25 STA. 12+51
DITCH
POLE
10 INCH STORM
528.00
LIMESTONE PARKING AREA
SWALE
EXIST. BLDG.
FIN. FL. 613.49
264.00
N. 40°35' W.
AVENUE 60'
TEMPLE (UNIMPROVED)
STROTHER (UNIMPROVED)
S. 40°35' E.
(SMALL TREES)
Grading Plan Approved as shown and/or noted THOMAS P. GILLES, P.E. Lake County Engineer
By
Date 5 Mar 73
528.00
S. 49°25' W.
WETMORE AVENUE 60' (UNIMPROVED)
NORTH
SITE PLAN
STAFAST PRODUCTS INC.
BLOCK 179 - G.E. MEIGS RESURVEY
PAINESVILLE TOWNSHIP - LAKE COUNTY - OHIO
Scale 1" = 40
Dec. 1972
Joseph D. Hadden - Reg. Surveyor No. 4394