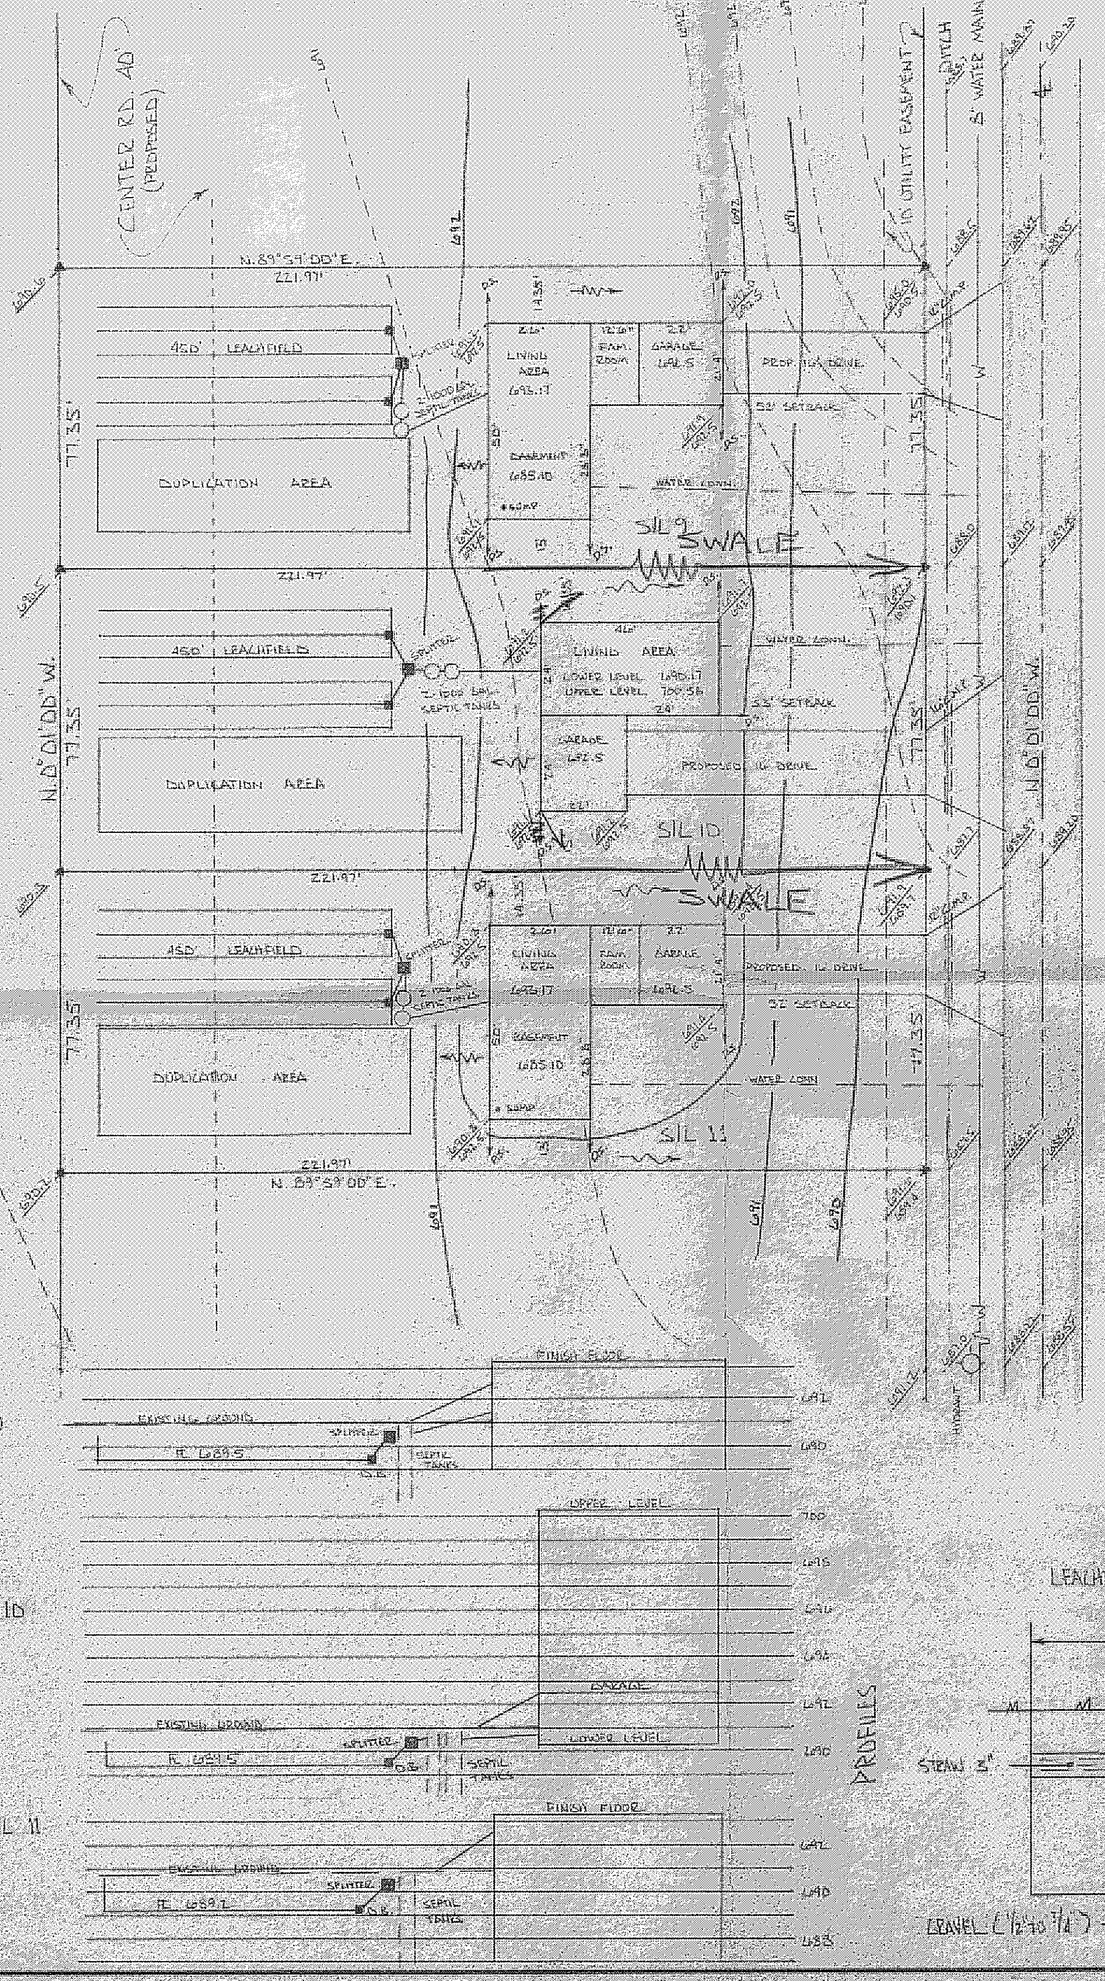

PAINESVILLE TOWNSHIP
ZONING APPROVED
4709
K. M. Hall
Zoning Inspector
3/9/79

▲ IRON PIN SET

EXIST. GRADES
PROP.

SWALE

*BENCHMARK: TOP STEM HYDRANT
CORNER THOLEN & SOUTHWOOD RD.
692.92

Grading Plan Approved
as shown and/or noted
THOMAS P. GILLES, P.E.
Lake County Engineer
By _____ Date 3-14-79

I CERTIFY THAT THIS PLAN WAS PREPARED BY ME AND IS CORRECT TO THE BEST OF MY KNOWLEDGE AND BELIEF.

[signature] REG. SURVEYOR S-6556

JOHN C. SKONIECZNY
7159 VIEWMOOR DRIVE
CONCORD, OHIO 44077
352-7742

SL 10 LARCHVIEW

SITE PLAN FOR
ROY SLAYTON & SON CONST.

SCALE: 1" = 30'	APPROVED BY JCS	DRAWN BY
DATE: 15 JAN 79		
OF S/L 9,10,11 SPRING LAKES SUBD #2		
TWP OF PAINESVILLE LAKE COUNTY OHIO		
ZONING: PVILLE TWP R-1		DRAWING NUM 79-2

ONE POST 18AB-15E