S 9

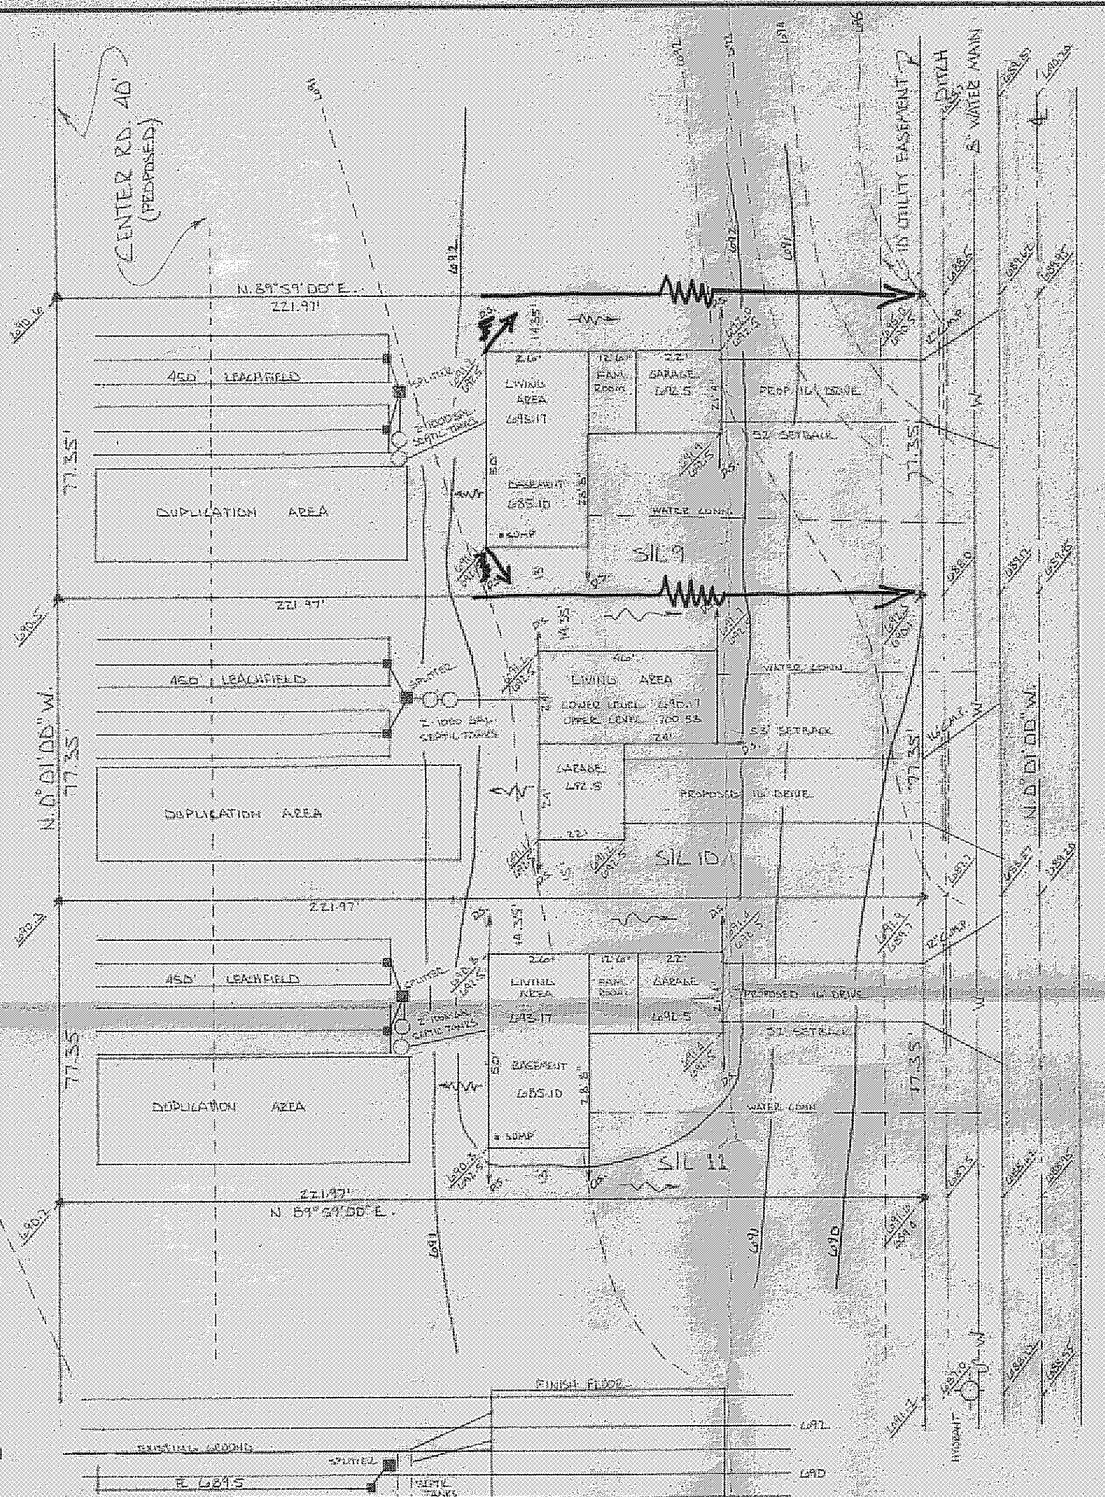

Grading Plan Approved
as shown and/or noted
THOMAS P. GILLES, P.E.
Lake County Engineer
By _____ Date 3-26-79

PAINESVILLE TOWNSHIP
ZONING APPROVED
4698
R. M. Hauk
Zoning Inspector
3/16/79

▲ IRON PIN SET

EXIST. / PROP. GRADES

SWALE

I CERTIFY THAT THIS PLAN WAS PREPARED BY ME AND IS CORRECT TO THE BEST OF MY KNOWLEDGE AND BELIEF.

JOHN C. SKONIECZNY
REG. SURVEYOR No. S-6556

JOHN C. SKONIECZNY
7289 VIEWMOUNT DRIVE
CONCORD, OHIO 44077
352-7742

* BENCHMARK: TOP STEM, HYDRANT CORNER, 7408 CT. & SOUTHWOOD RD. 692.92

LEACHING TRENCH

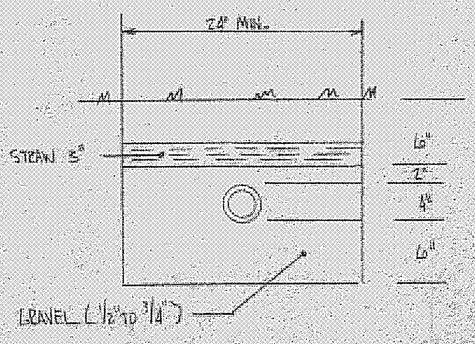

SITE PLAN FOR
ROY SLAYTON & SON CONST.

SCALE: 1" = 30'	APPROVED BY JCS	DRAWN BY SJC
DATE: 15 JAN 79		

OF SIL 9,10,11 SPRING LAKES SUBD. #2
TWP. OF PAINESVILLE LAKE COUNTY OHIO
ZONING: P'VILLE TWP. R-1

DRAWING NUMBER 79-268

COST 18AB-15E