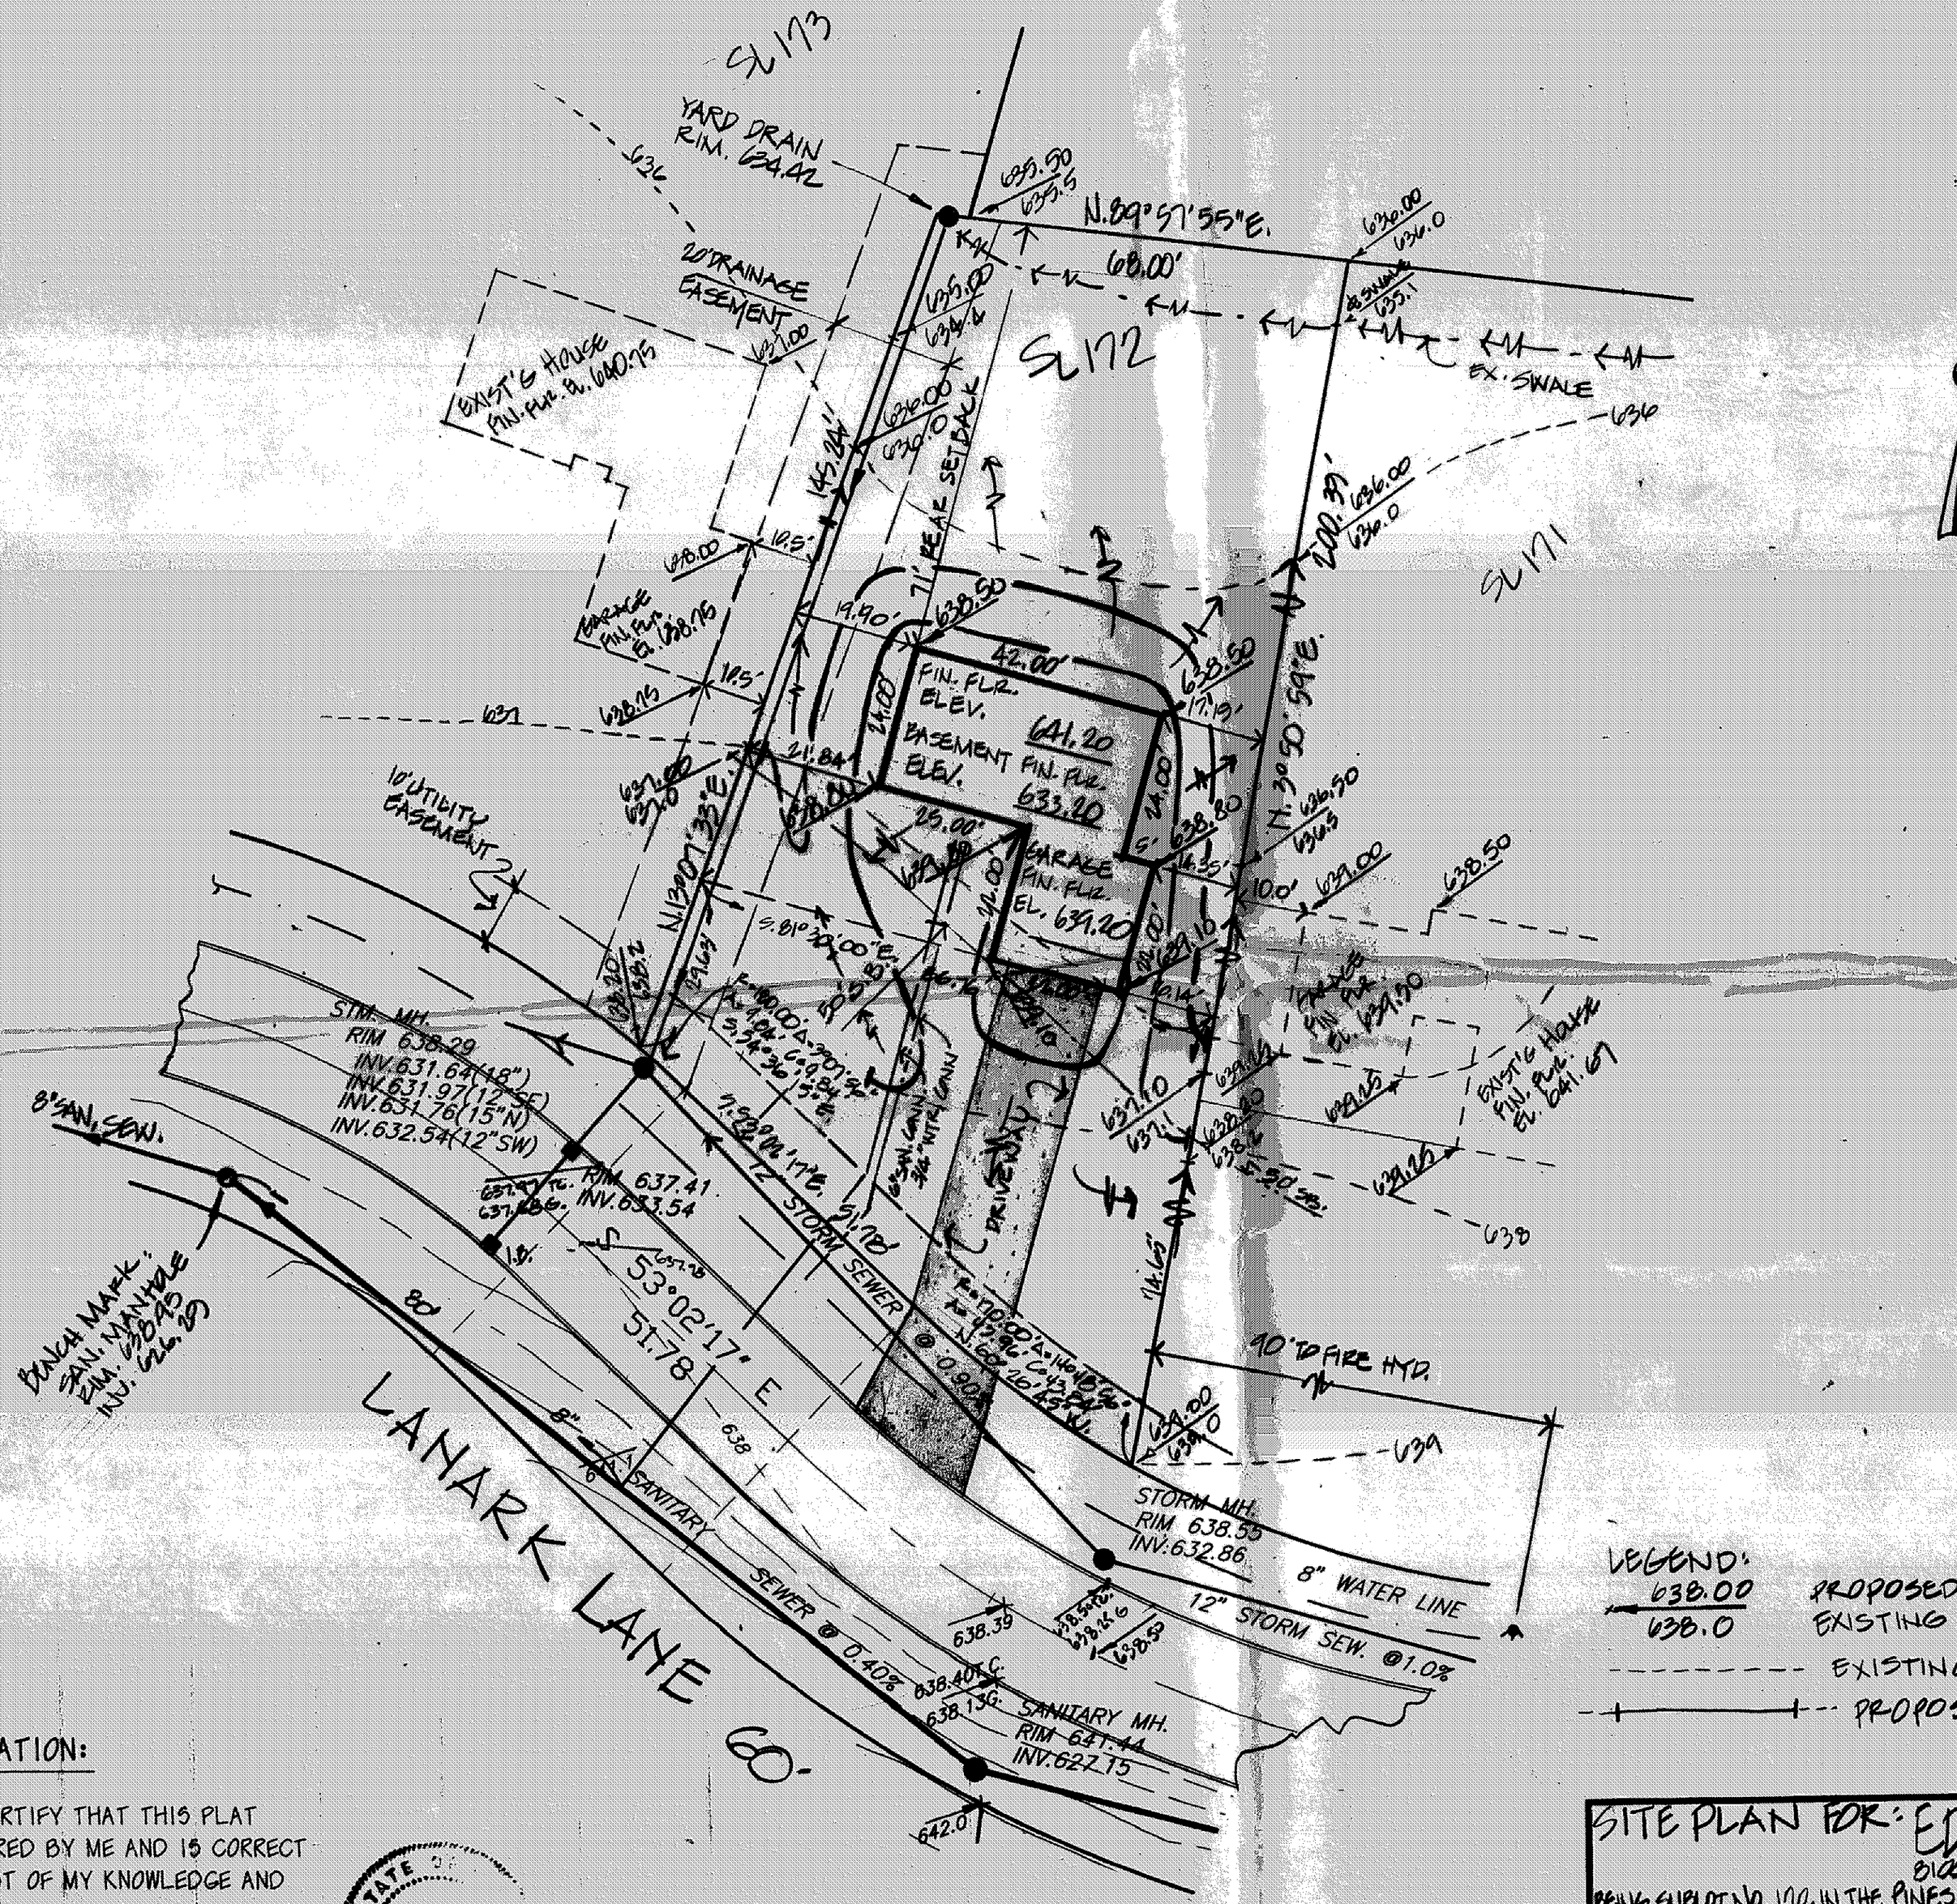

Grading Plan Approved
as shown and/or noted
THOMAS P. GILLES, P.E.
Lake County Engineer
By GJH Date 7.22.93

ROOF DRAINS SHALL DISCHARGE TO SPLASH BLOCKS.

APPROVED
PAINESVILLE TOWNSHIP
ZONING DEPARTMENT
#8510 7/20/93
DRust

LEGEND:
638.00 PROPOSED GRADES
638.0 EXISTING ELEVATIONS
EXISTING CONTOURS
PROPOSED CONTOURS

CERTIFICATION:

I HEREBY CERTIFY THAT THIS PLAT WAS PREPARED BY ME AND IS CORRECT TO THE BEST OF MY KNOWLEDGE AND BELIEF.

BY: Richard J Bilski

RICHARD J. BILSKI, P.S. NO. 5244

STATE OF OHIO
RICHARD BILSKI 5244
REGISTERED SURVEYOR

SITE PLAN FOR: EDWARD H. TRESGER, INC.
8100 DEEPWOOD BLVD., MENTOR, OHIO. 44060
BEING SUBLOT NO. 172 IN THE PINES SUBDIVISION NO. 3C IN PAINESVILLE TOWNSHIP, OHIO.

DATE July 9, 1993
SCALE 1" = 20'
DRAWN BY GD.B.
CH'K'D BY

CT Consultants, Inc.
Engineers • Architects • Planners
Willoughby • Mentor • Columbus • Lorain • North Canton • Steubenville

SHEET 1 OF 1
CONTRACT NO. 89.479