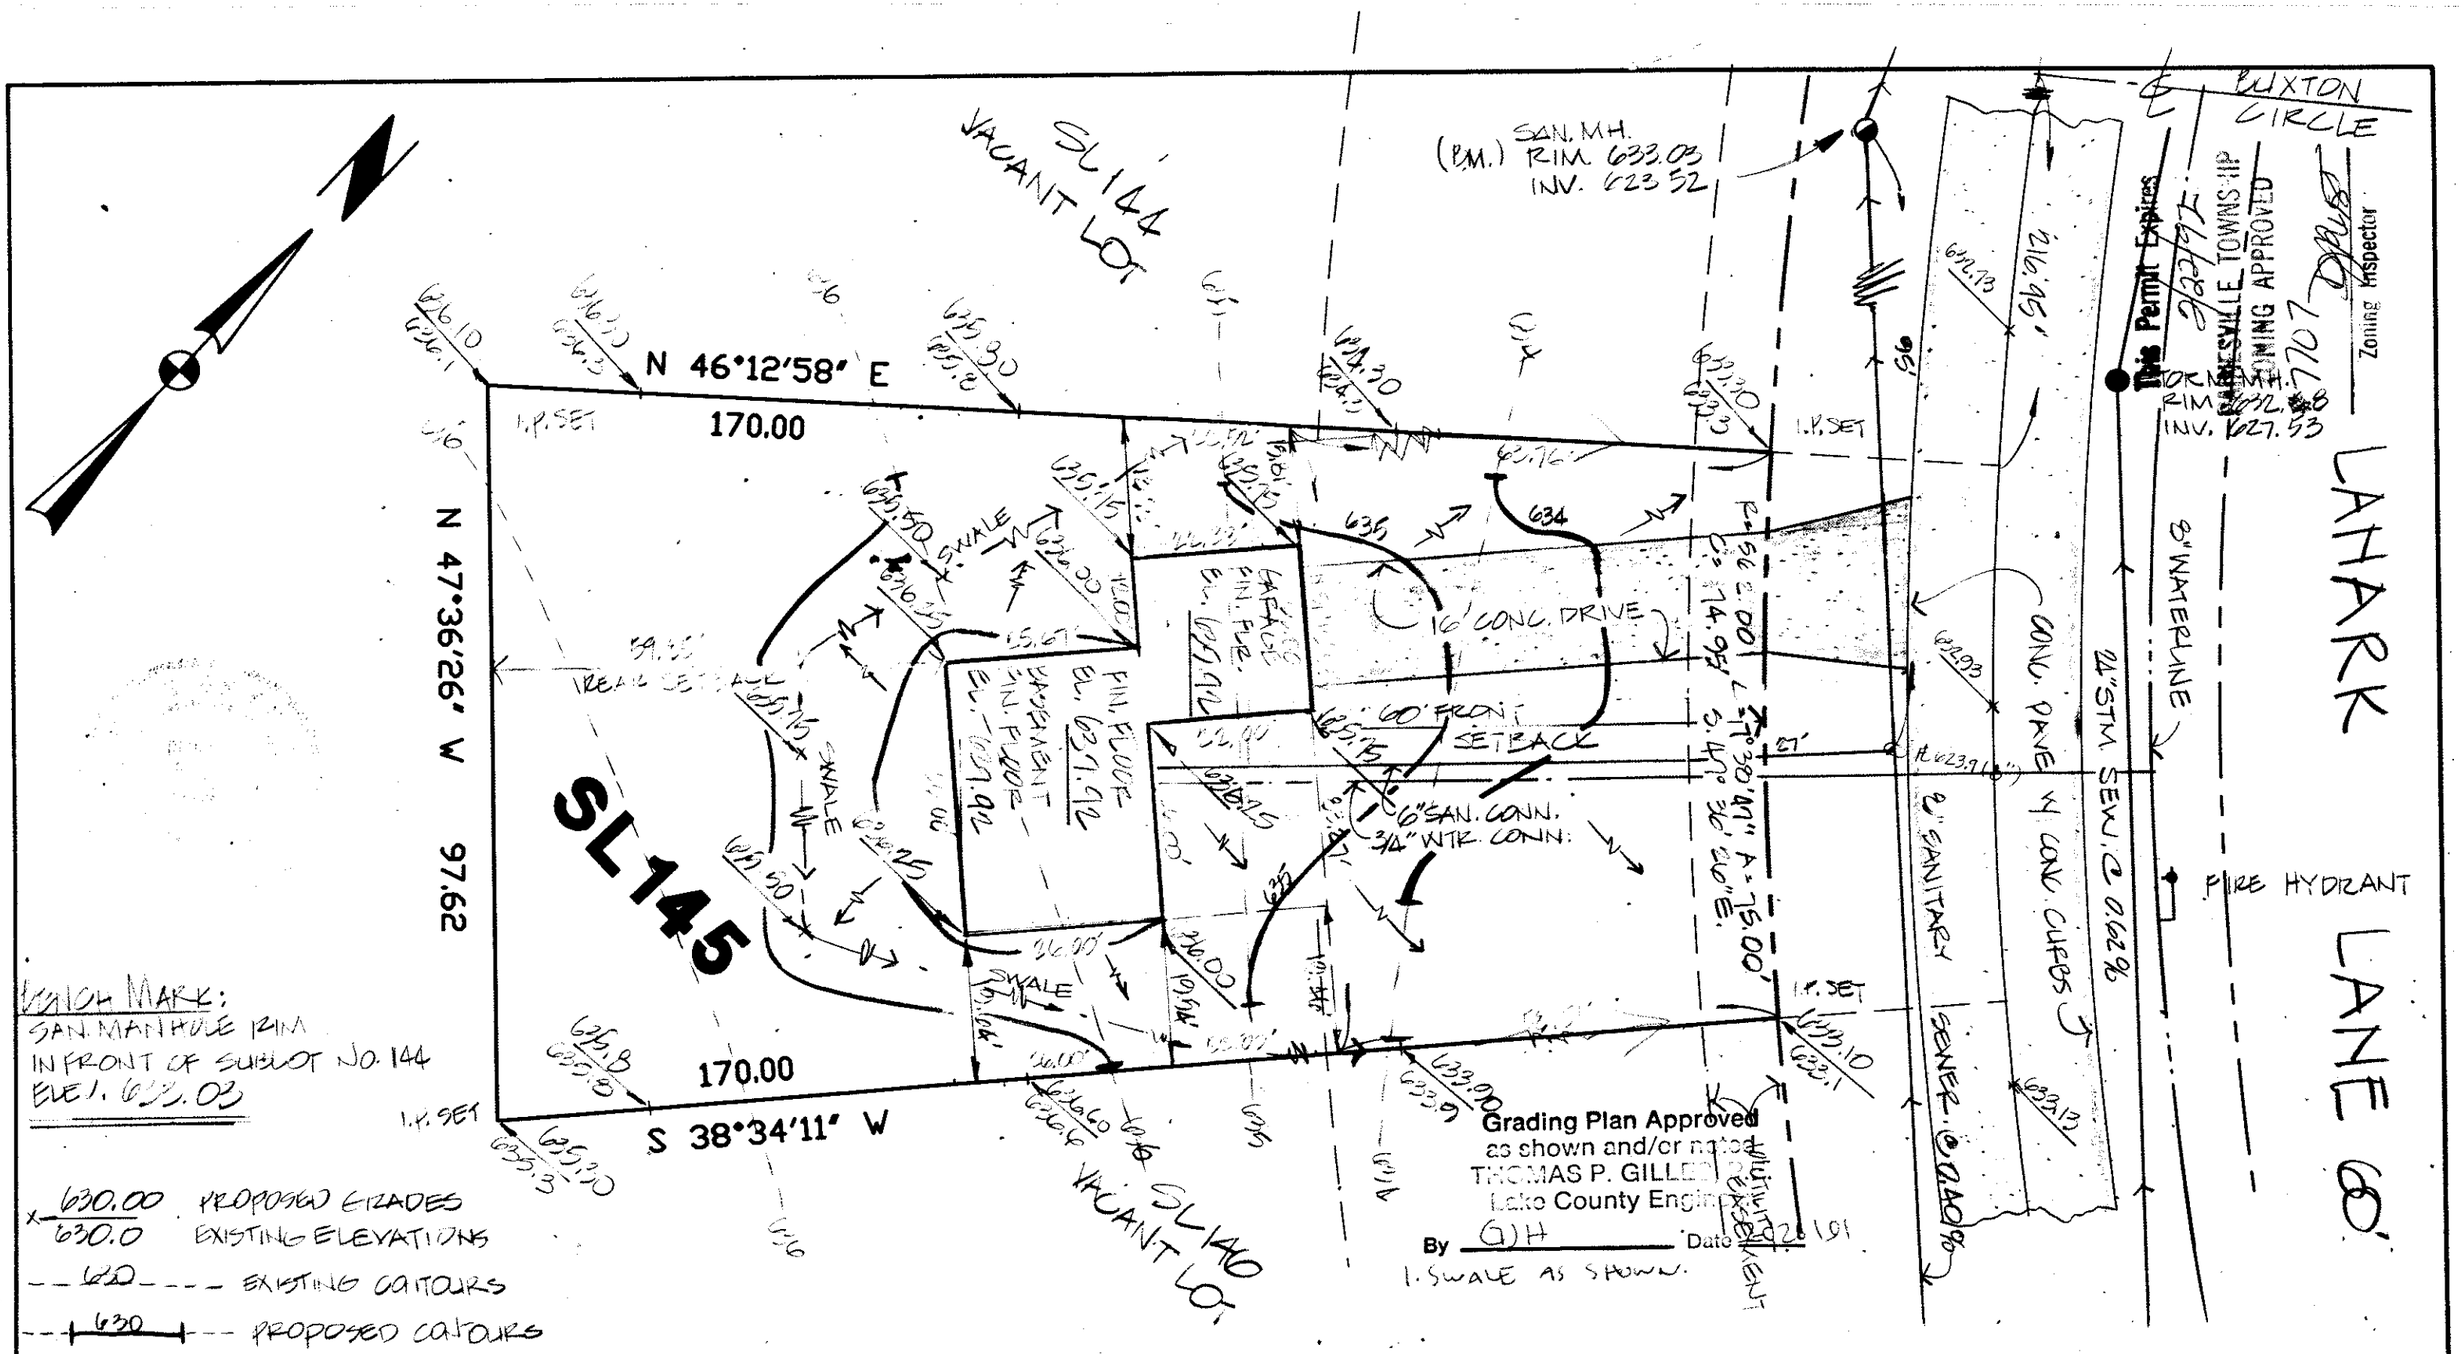

DESIGN CERTIFICATION	AS BUILT CERTIFICATION			
THIS PLAT WAS PREPARED BY ME, AND IS CORRECT TO THE BEST OF MY KNOWLEDGE AND BELIEF.	I HEREBY CERTIFY THAT THE CIRCLED GRADES ARE EXISTING FINISH GRADES CHECKED IN THE FIELD ON _____ AND THAT SURVEY IS CORRECT TO THE BEST OF MY KNOWLEDGE AND BELIEF.	**CT Consultants, Inc.** *Engineers • Architects • Planners* Willoughby • Mentor • Columbus • Lorain • North Canton • Steubenville	DATE FEB. 18, 1991 SCALE 1" = 20' DRWN BY O.D.R. CHKD BY JOB NO 89-478 FB 707 PG 98-99	SITE PLAN FOR: EDWARD H. TRESGER, INC. 8100 DEEPWOOD BLVD., MENTOR, OH. 44060 BEING SUBLOT NO. 145 IN THE PINES SUBDIVISION PHASE III-B IN PAINESVILLE TOWNSHIP, OHIO
REG SURVEYOR NO 5244	REG SURVEYOR NO _____			