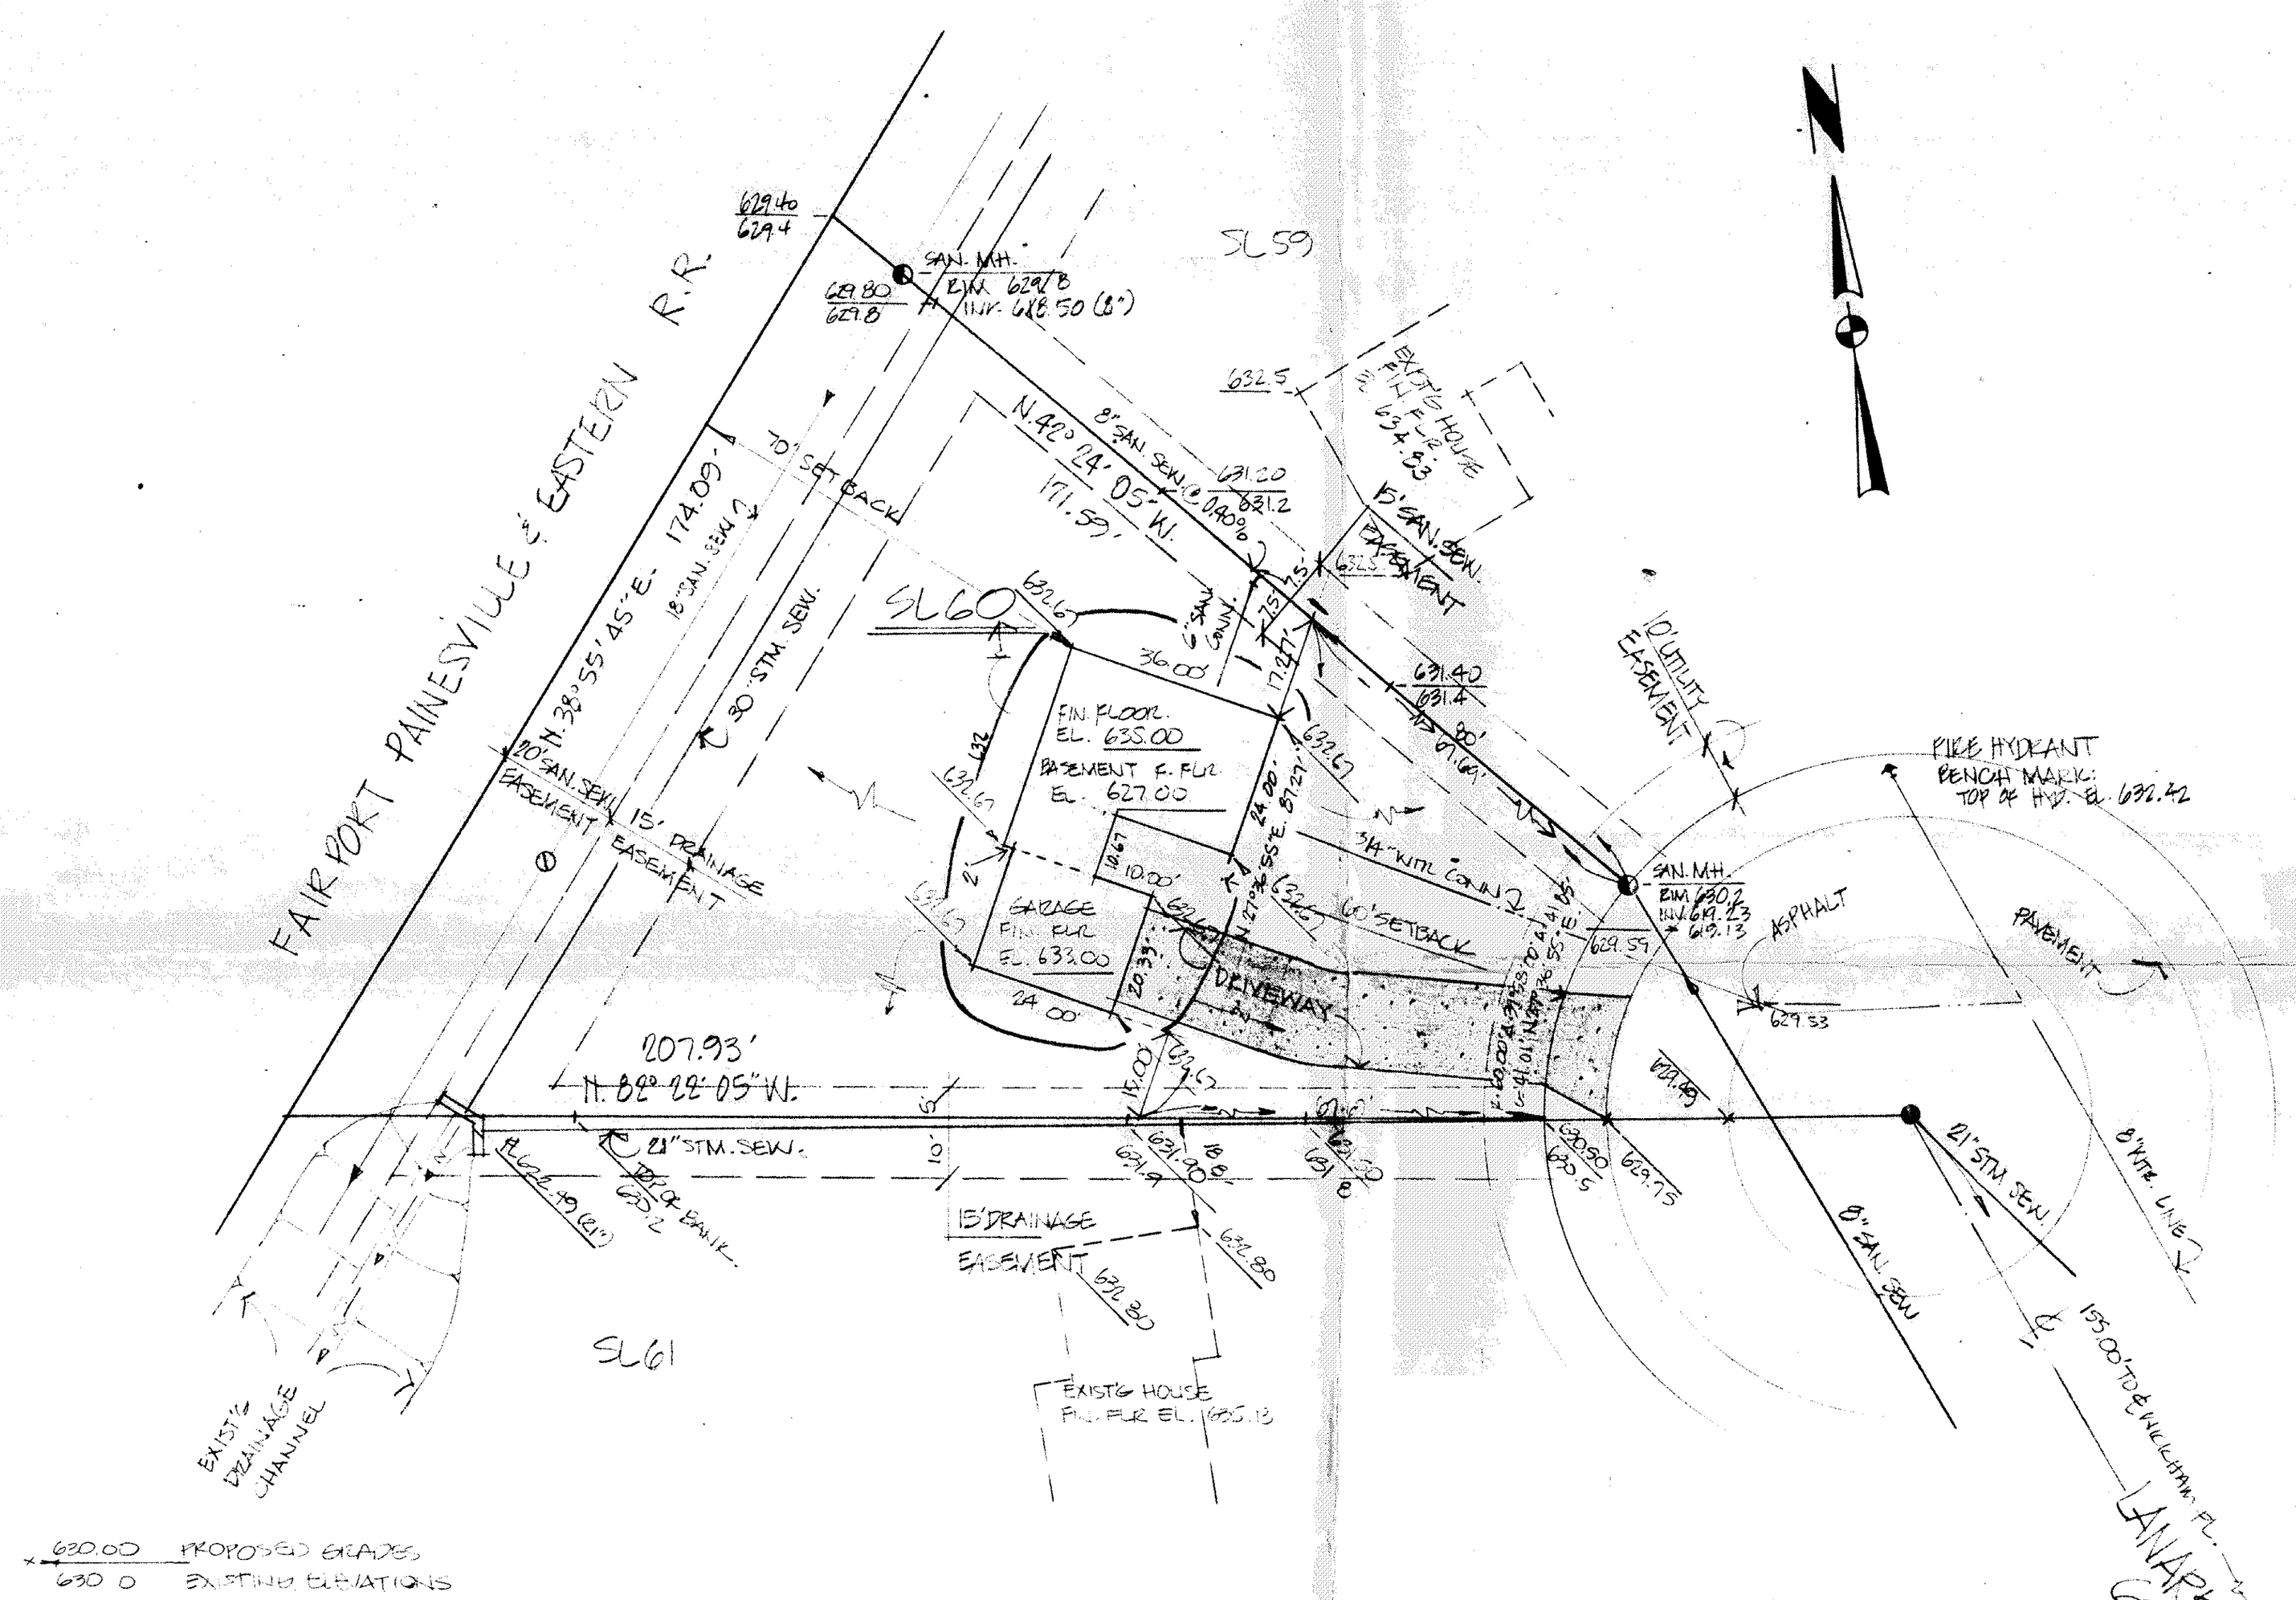

Grading Plan Approved
as shown and/or noted
THOMAS P. GILLES, P.E.
Lake County Engineer
By [signature] Date 8/4/88

This Permit Expires
8-9-89
PAINESVILLE TOWNSHIP
ZONING APPROVED
7053
[signature]
Zoning Inspector 8/1/88

STATE OF OHIO
RICHARD BILSKI
5244
REGISTERED SURVEYOR

DESIGN CERTIFICATION
I HEREBY CERTIFY THAT THIS PLAT WAS PREPARED BY ME, AND IS CORRECT TO THE BEST OF MY KNOWLEDGE AND BELIEF.
BY: [signature]
REG. SURVEYOR, No. 5244

SITE PLAN FOR:
EDWARD H. TRESGER, INC.
3100 DEEPWOOD BLVD., MENTOR, OHIO 44060

SCALE: 1" = 20'	APPROVED BY	DRAWN BY CDB
DATE: AUG. 2, 1988		

BEING SUBLOT NO. 60 IN THE PINES SUBDIVISION NO. 2 IN PAINESVILLE TOWNSHIP, OHIO

CT CONSULTANTS, INC.
35000 KAISER CT., WILLOUGHBY, OH. 44094

DRAWING NUMBER