Grading Plan Approved
as shown and/or noted
THOMAS P. GILLES, P.E.
Lake County Engineer

By J W K Date 6-23-75

PAINESVILLE TOWNSHIP
ZONING APPROVED
3687 6-23-75
changes noted
Jerry Van Nederan
Zoning Inspector

OWNER: Wm. & Ruth A Gardner

LEGEND
○ I.P. SET
● I.P. FOUND

DATE: JUNE, 1975

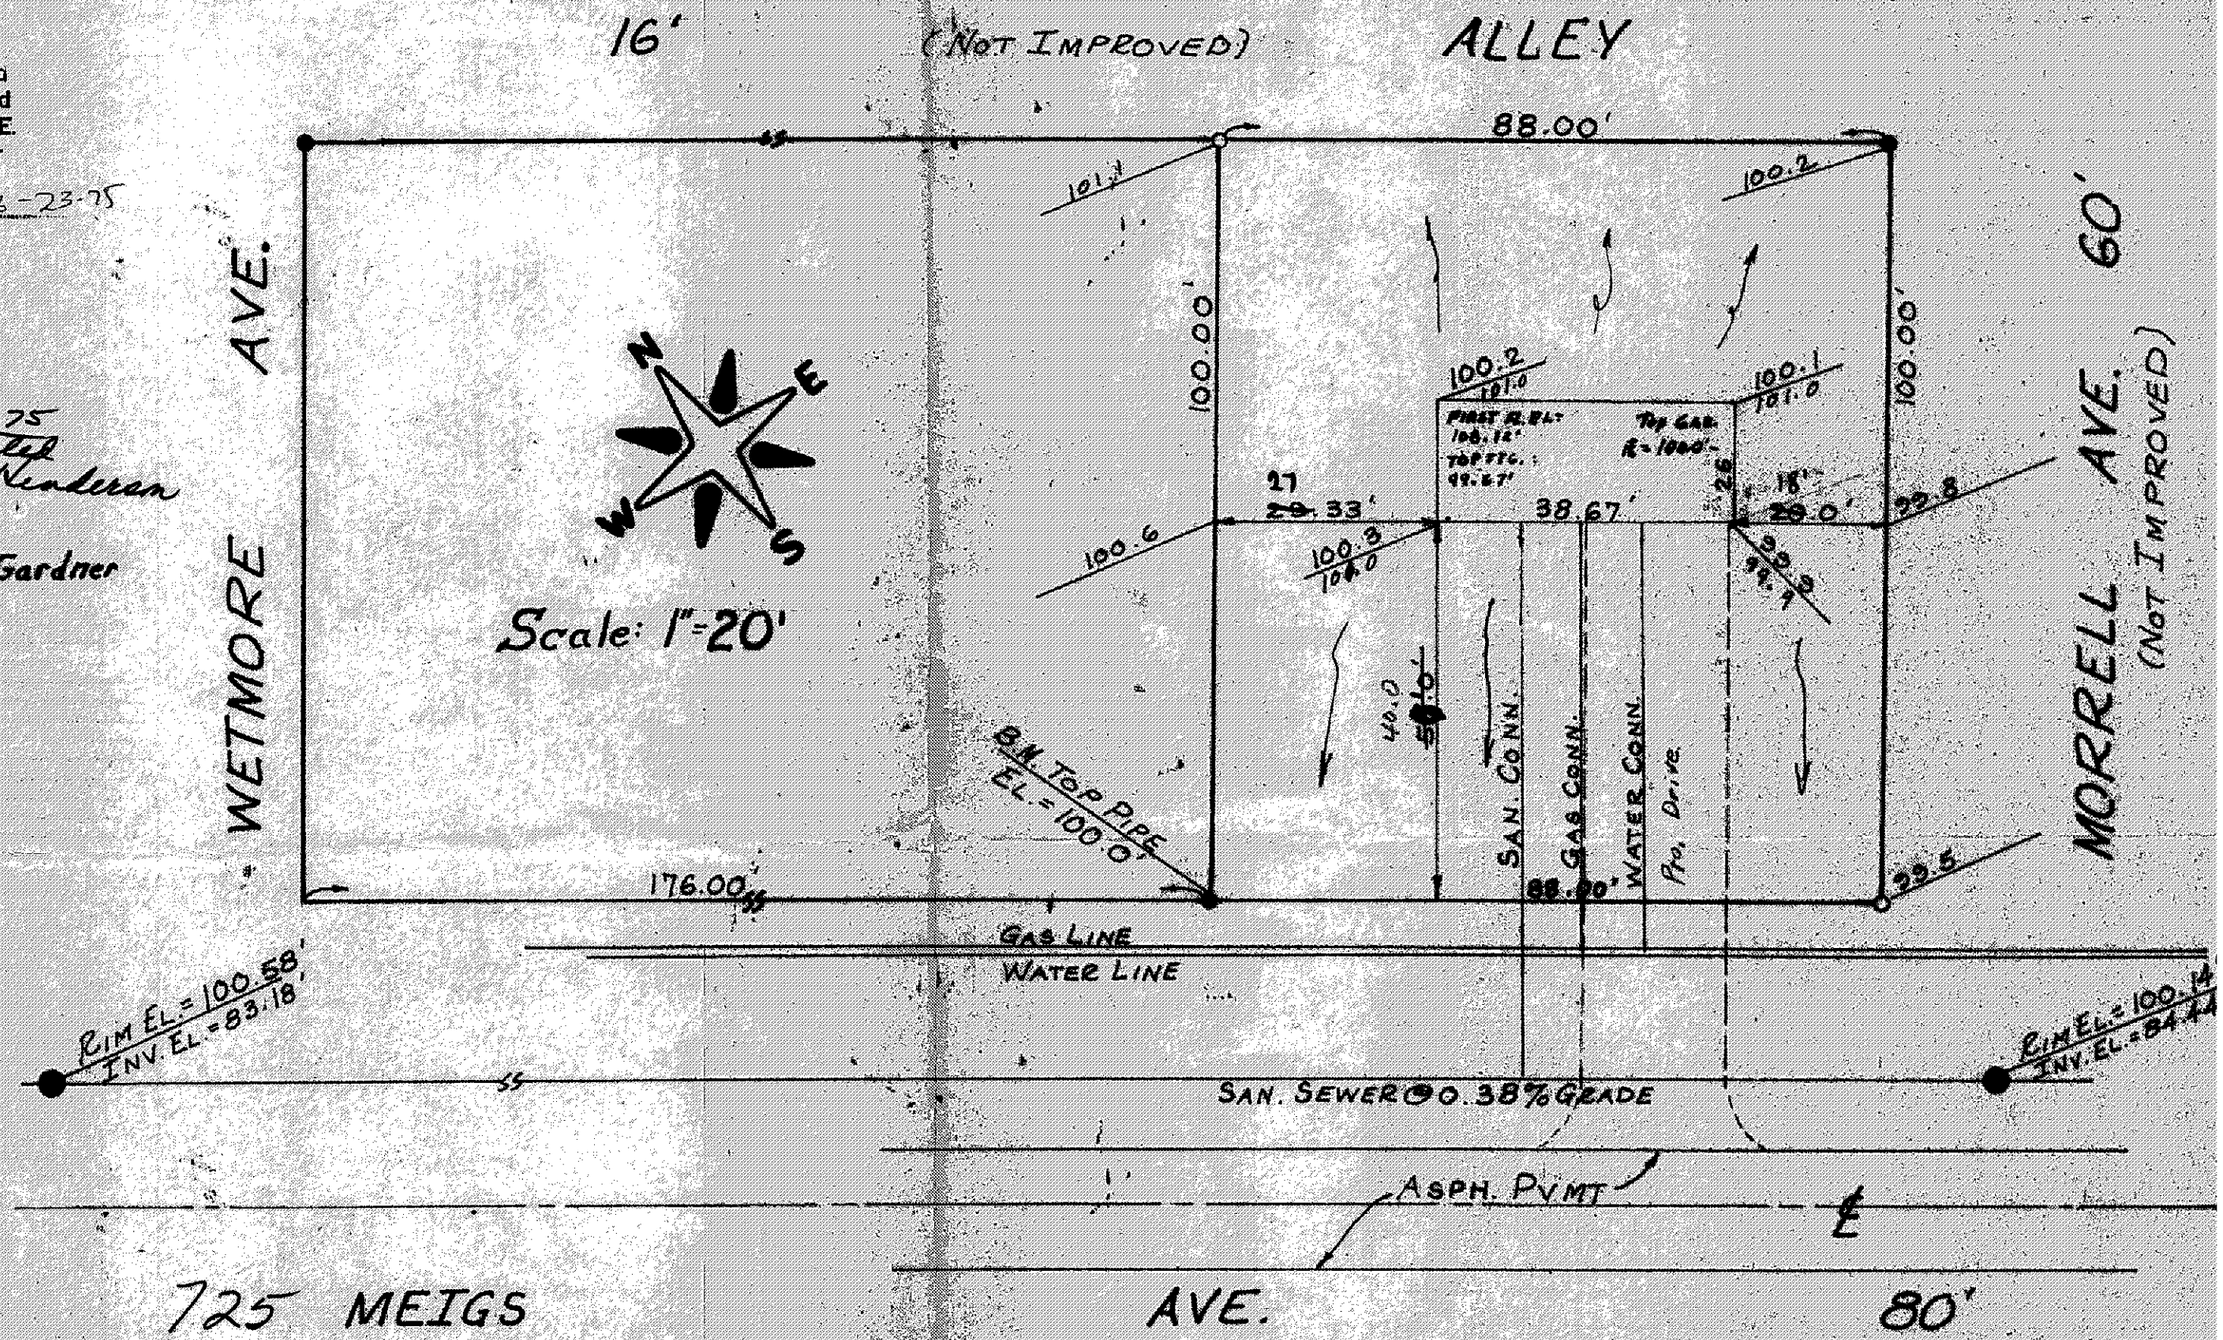

TOPOGRAPHIC SURVEY & IMPROVEMENT PLAN

STATE OF OHIO
JOHN A. BAMBECK
5141
REGISTERED SURVEYOR

S/L'S 9, 10, 11; BLOCK No. 109; IN G.E. MEIG'S RESURVEY AND OF THE ORIGINAL TOWN OF RICHMOND IN ORIGINAL PAINESVILLE TOWNSHIP LOT'S NO'S 19 to 23, TRACT 4, VOL. A, Pg. 37 LAKE COUNTY, OHIO.

JOHN A. BAMBECK
& ASSOCIATES, INC.
991 MEDINA ROAD
MEDINA, OHIO 44256

239-1001

75-245