REVISED
Grading Plan Approved
as shown and/or noted
THOMAS P. GILLES, P.E.
Lake County Engineer
By _____ Date 7-16-75

SITE & GRADING PLAN
for
LAKE COUNTY NATIONAL BANK

of a 2.109 ACRE PARCEL OF LAND
BEING PART OF LOT 45 IN TRACT 4
LOCATED IN
PAINESVILLE TOWNSHIP, LAKE COUNTY, OHIO
SCALE: 1" = 20' JUNE, 1975

PREPARED BY
DEBEVEC · SALO & ASSOCIATES, INC.
CIVIL ENGINEERS · SURVEYORS

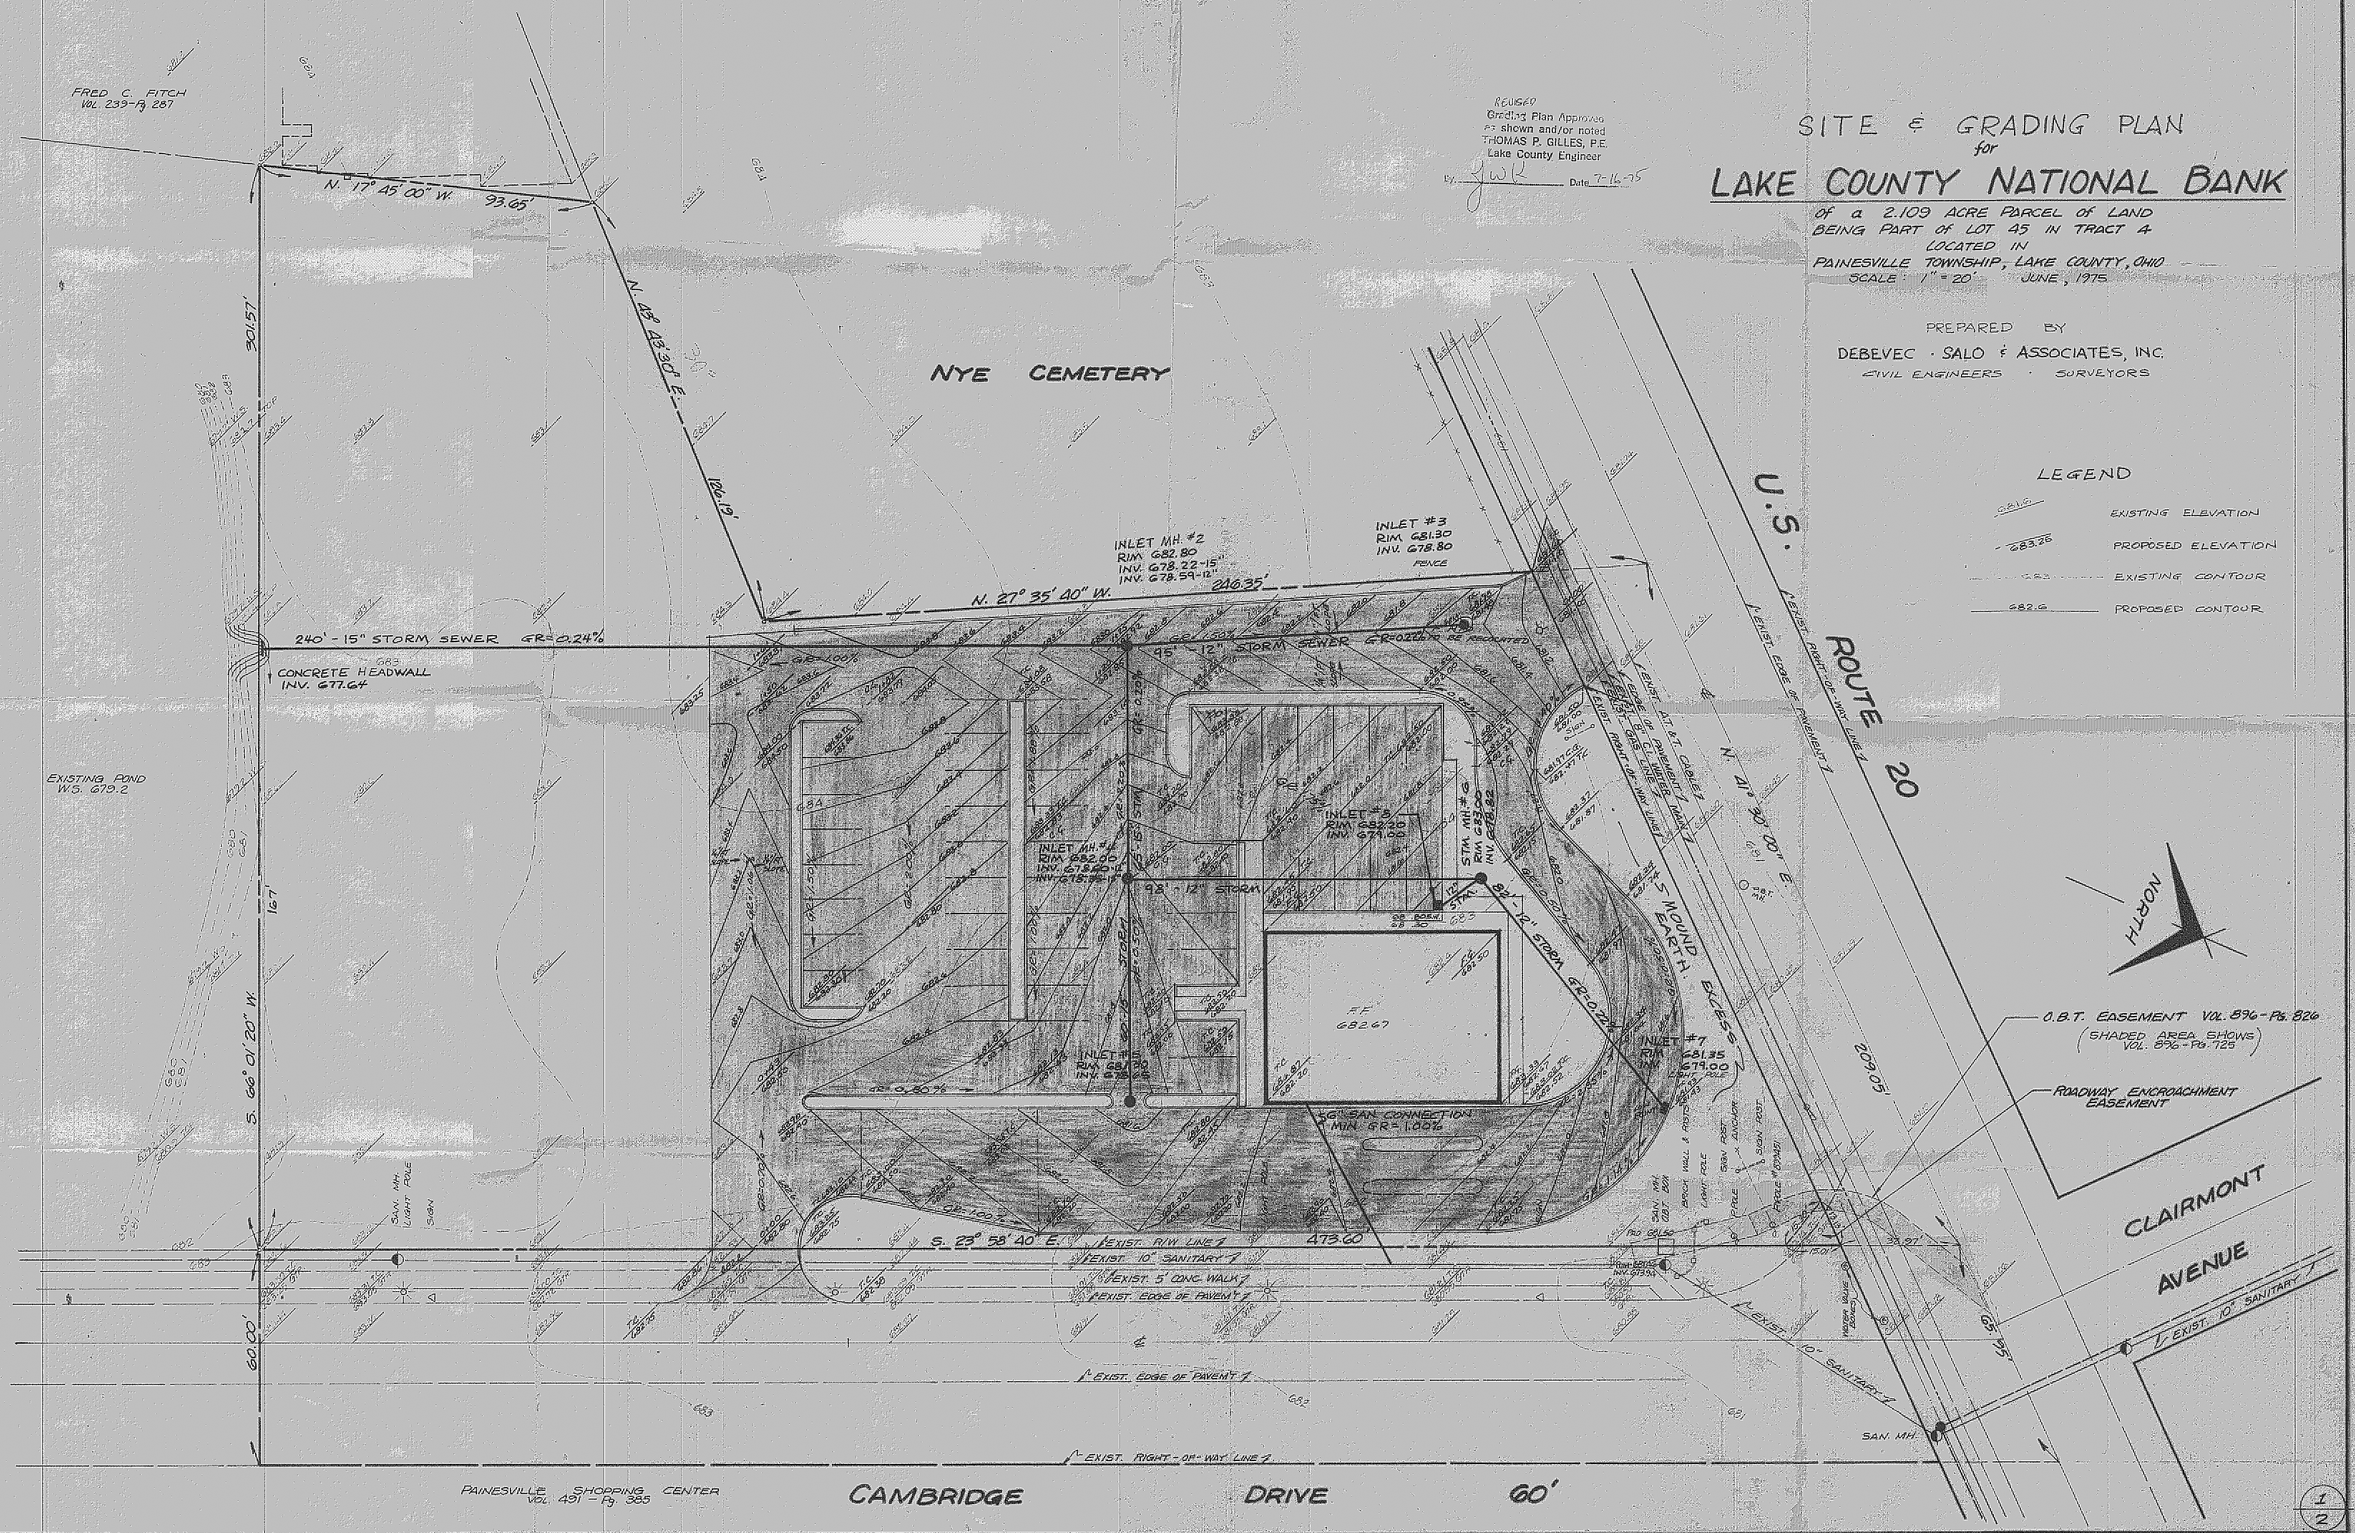

LEGEND

683.0	EXISTING ELEVATION
683.26	PROPOSED ELEVATION
683	EXISTING CONTOUR
682.6	PROPOSED CONTOUR

1 / 2

1655 Mentor Ave