PREPARED BY:
Wilson and Associates
Registered Surveyors
11005 Wilson Mills Road
Chardon, Ohio 44024
Date: June 12, 1974
Scale: 1" = 30'

SITE PLAN

NURSERY SUBDIVISION

PART OF SUBLOT NO. 33 & 34
VOLUME G PAGE 144

PAINESVILLE TOWNSHIP
LAKE COUNTY OHIO
for
CASEMENT HOMES
1251 MADISON AVE.
PAINESVILLE, OHIO

CERTIFICATION:
I certify that this plat was prepared by me, and is correct to the best of my knowledge.
By: Lawrence Wilson
Lawrence Wilson, Reg. Surveyor No. 5807

"AS BUILT" CERTIFICATION:
I certify that on _____ 1974, the finished grades were checked in the field, shown encircled, and are correct to the best of my knowledge.
By: _____
Lawrence Wilson, Reg. Surveyor No. 5807

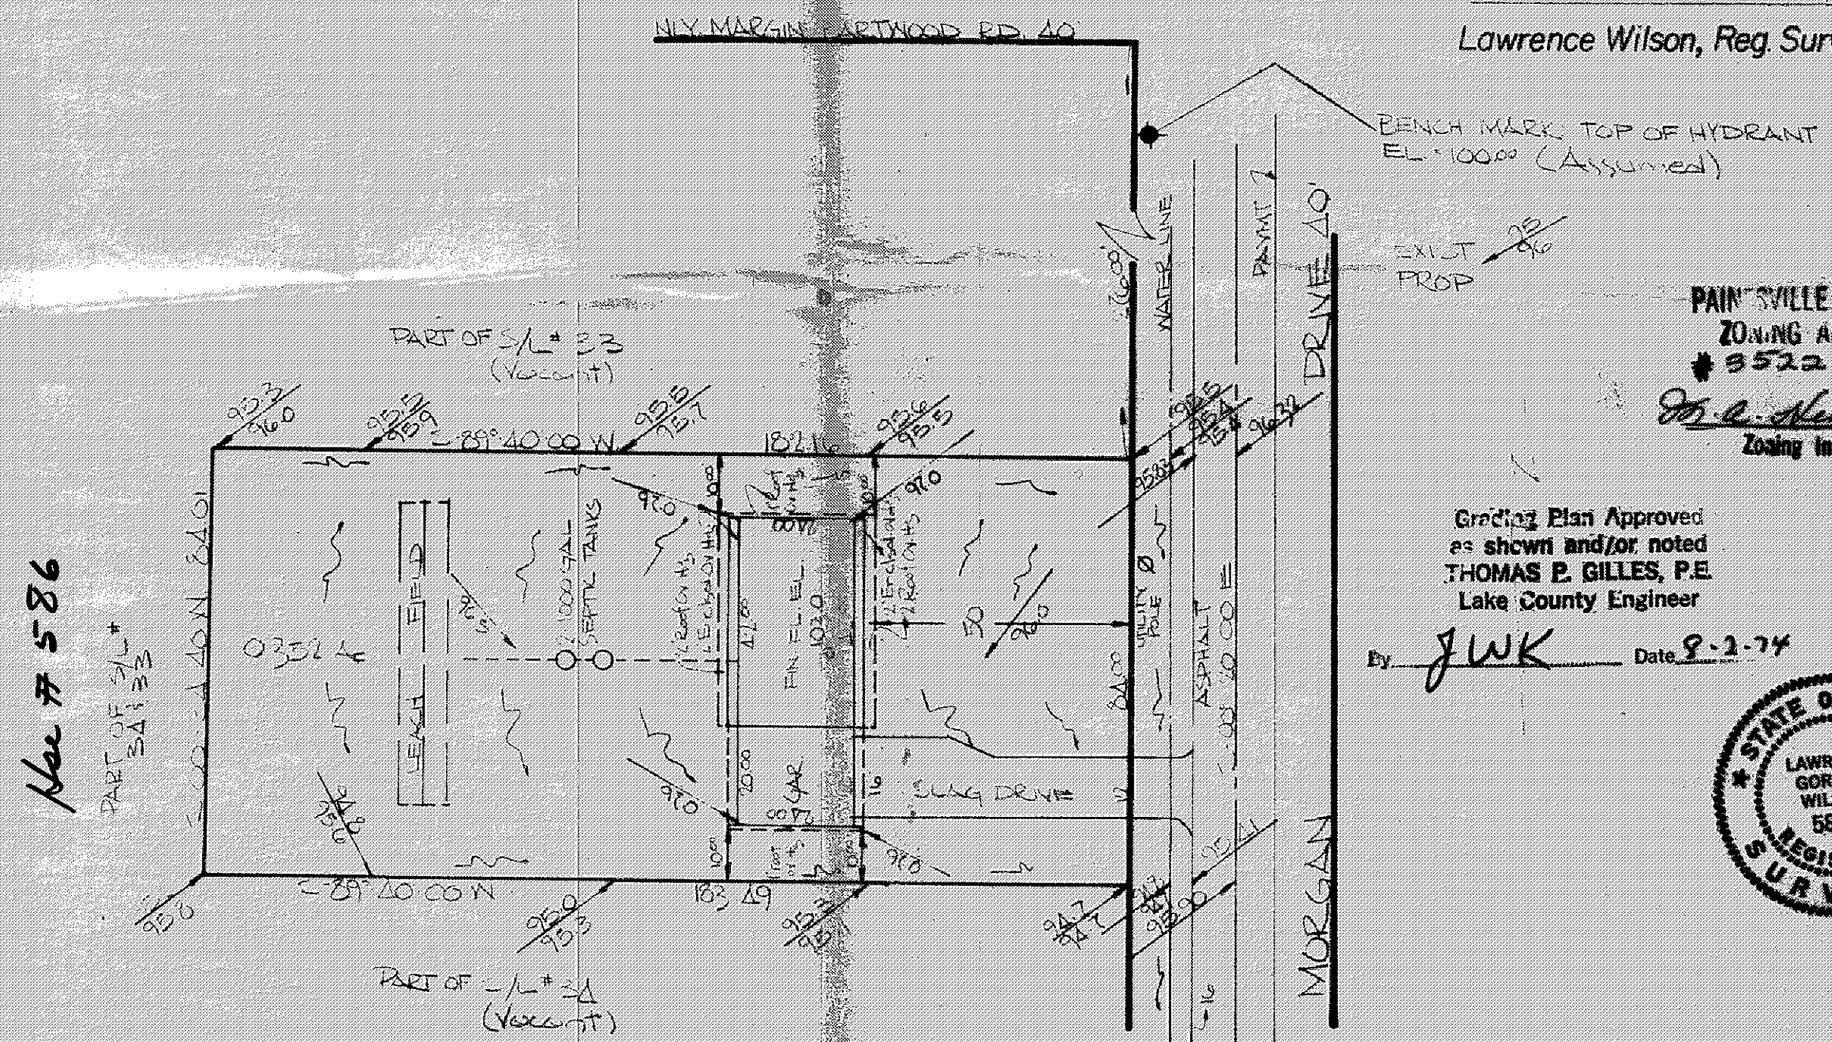

Map # 586

PAINESVILLE TOWNSHIP
ZONING APPROVED
3522 8-7-74
Zoning Inspector

Grading Plan Approved
as shown and/or noted
THOMAS P. GILLES, P.E.
Lake County Engineer
By JWK Date 8-2-74

STATE OF OHIO
LAWRENCE GORDON WILSON
5807
REGISTERED SURVEYOR