SITE PLAN FOR:


BEING SUBLOT NO. 23 IN LOT 20 TRACT 4 IN GRAND RIVER VILLAGE, OHIO.

PREPARED BY:

WM R GRAY ASSOC INC
7547 MENTOR AVE.
MENTOR, OH. 44060

SCALE: 1" = 20' DATE: NOV. 6, 1975

CERTIFICATION

I HEREBY CERTIFY THAT THIS PLAT IS CORRECT TO THE BEST OF MY KNOWLEDGE.

BY: Wm. R. Gray

WM. R. GRAY REG. SURV. # 2752

STATE OF OHIO
WM. R. GRAY
2752
REGISTERED
PROFESSIONAL SURVEYOR

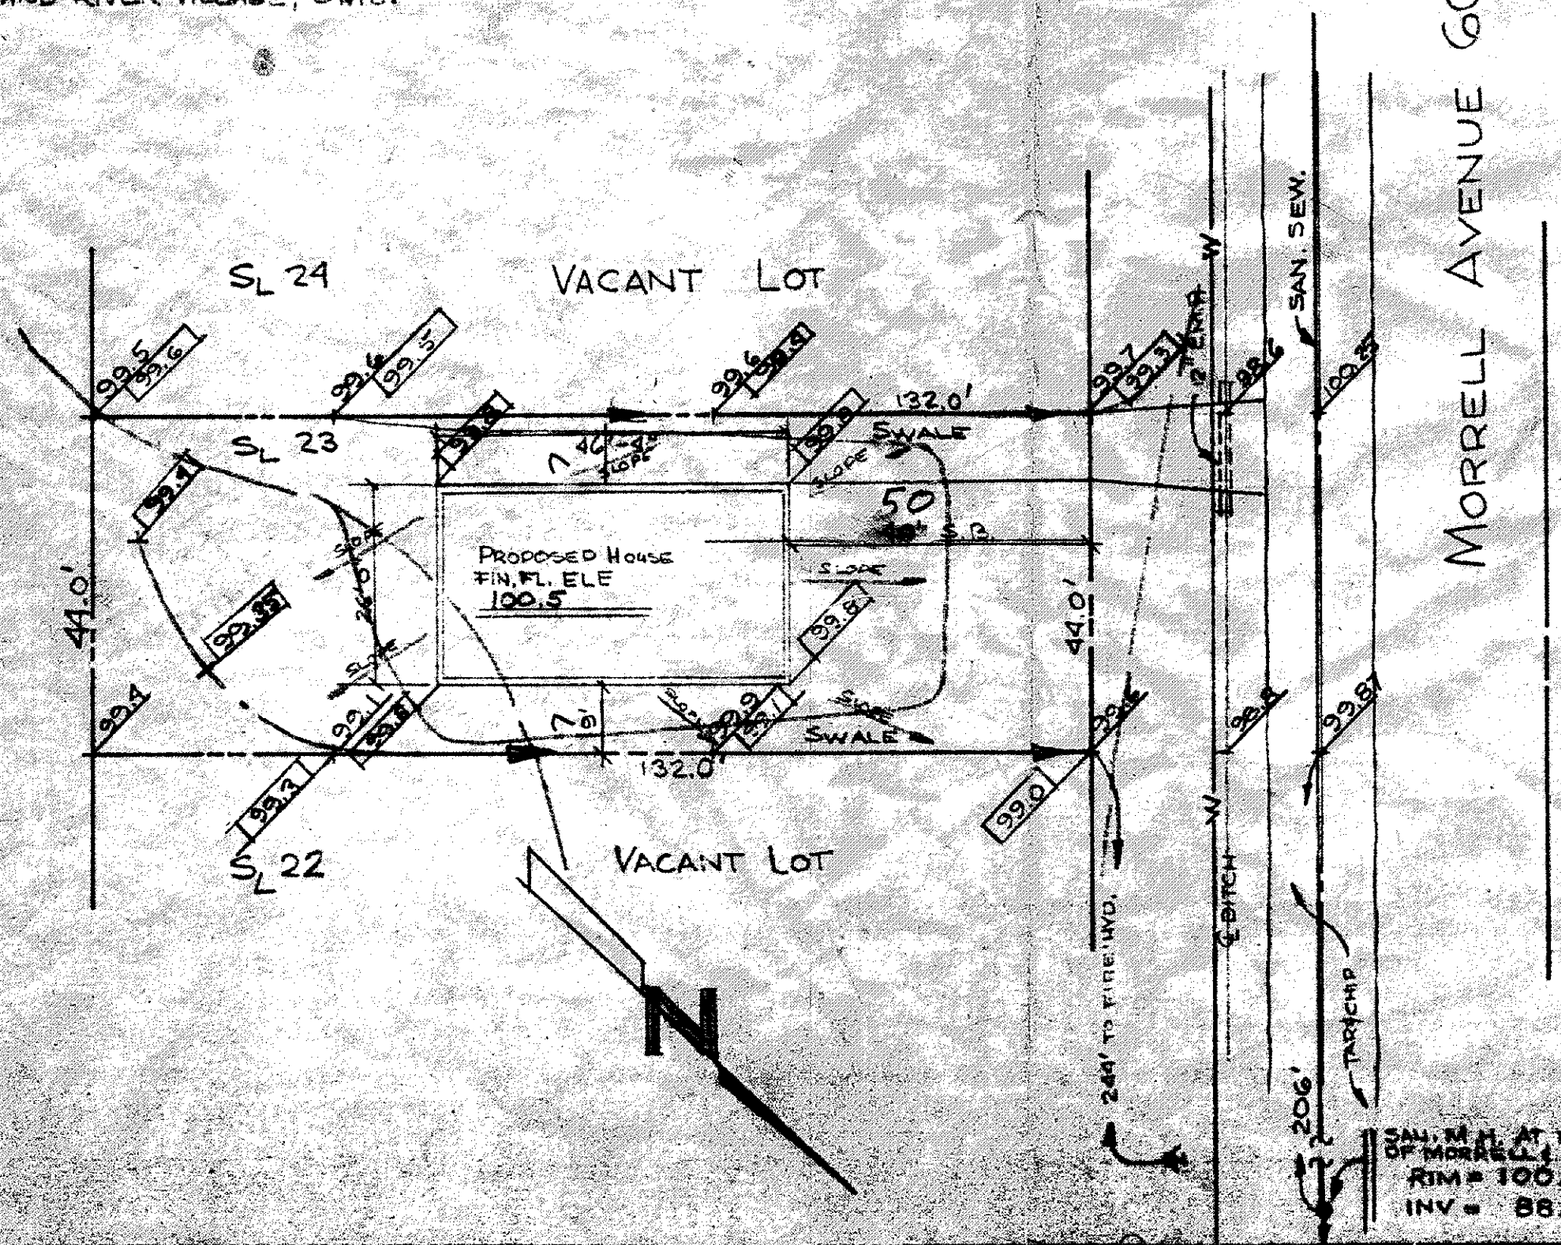

PAINESVILLE TOWNSHIP
ZONING APPROVED
3821 12-30-75
Changes noted
Merryann Henderson
Zoning Inspector

Grading Plan Approved
as shown and/or noted
THOMAS P. GILLES, P.E.
Lake County Engineer
By JWK Date 12-30-75