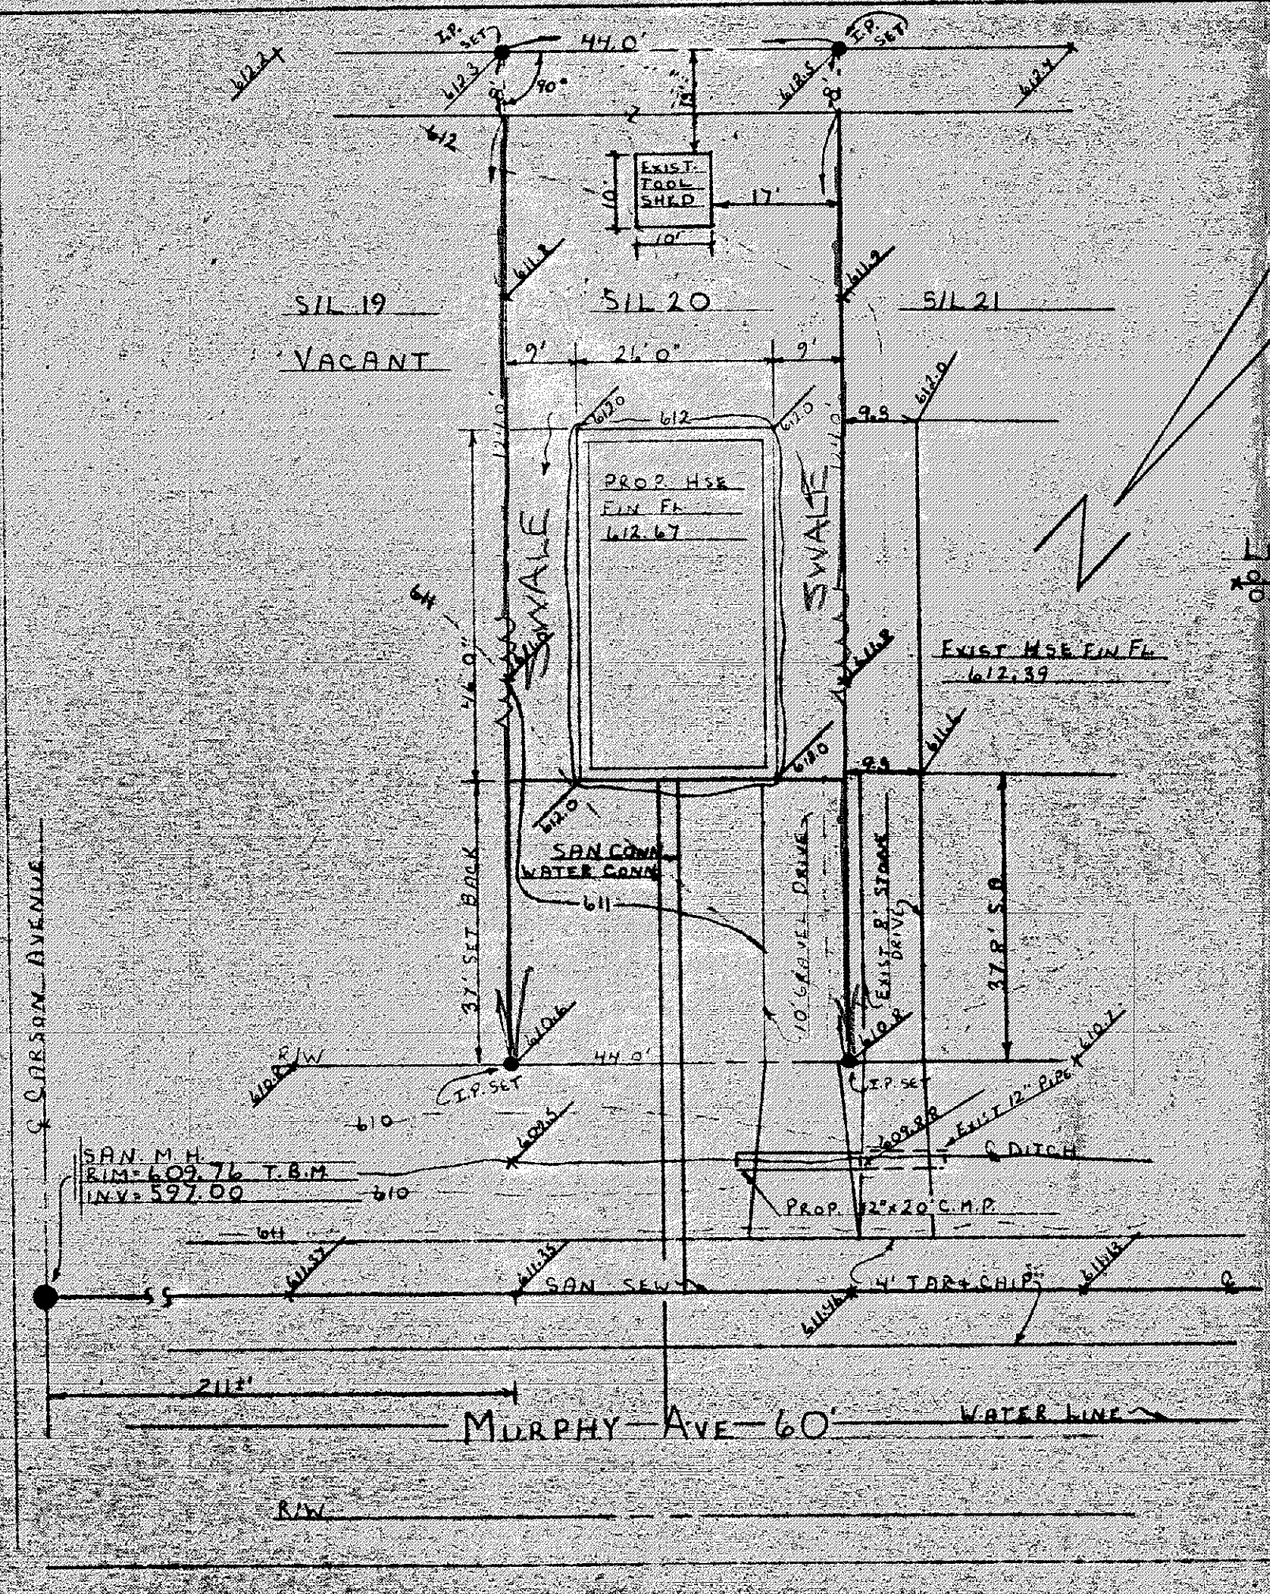

PAINESVILLE TOWNSHIP
ZONING O.K.
PENDING DRAINAGE

Zoning Inspector

LEGEND
000 EXIST ELEV
000 PROP ELEV

SITE PLAN FOR:

WAYNE HAWKINS
P.O. BOX 164
MENTOR, OHIO

BEING SUBLOT NO 20 IN BLOCK 120 ON MURPHY ROAD IN PAINESVILLE TWP., OHIO

PREPARED BY:

WM. R. GRAY ASSOC INC
7547 MENTOR AVE
MENTOR, OHIO

SCALE: 1"=20'

DATE: JULY 26, 1978

Grading Plan Approved as shown and/or noted
THOMAS P. GILLES, P.E.
Lake County Engineer
By [illegible] Date 9-26-78

CERTIFICATION:

I HEREBY CERTIFY THAT THIS PLAT IS CORRECT TO THE BEST OF MY KNOWLEDGE

BY: Wm. R. Gray

WM. R. GRAY ASSOC. INC.

STATE OF OHIO
WM. R. GRAY
2752
REGISTERED
PROFESSIONAL SURVEYOR