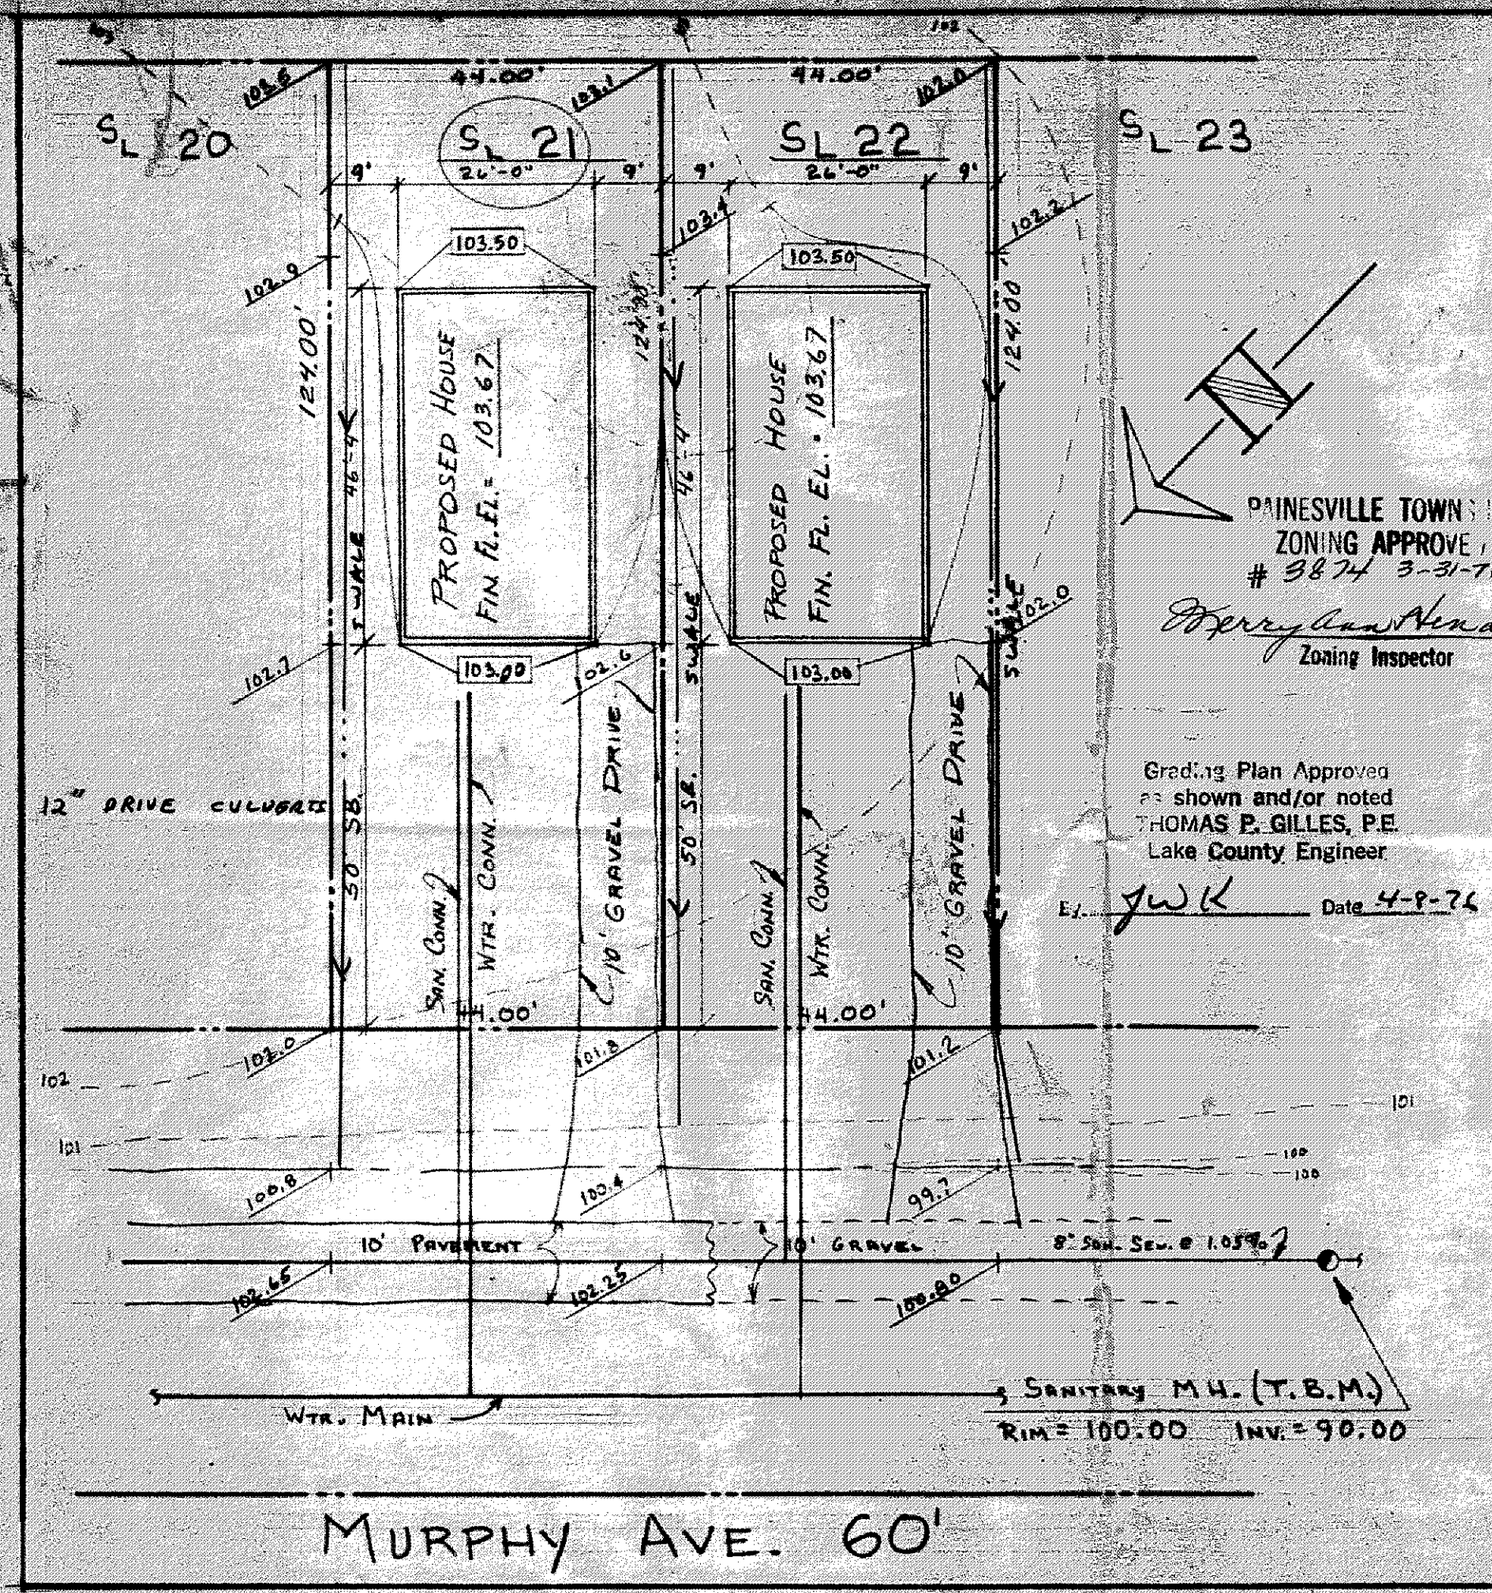

PAINESVILLE TOWNSHIP
ZONING APPROVE,
3874 3-31-76
Merry Ann Henderson
Zoning Inspector

Grading Plan Approved
as shown and/or noted
THOMAS P. GILLES, P.E.
Lake County Engineer
By JWK Date 4-8-76

SITE PLAN FOR:

WAYNE HAWKINS
~~6587 ELMWOOD AVE.~~ PO Box 164
~~MENTOR, OHIO~~ Mentor

BEING SUBLOT NOS. 21 & 22 IN BLOCK 120 ON MURPHY AVE. IN PAINESVILLE TWP., OHIO.

PREPARED BY:

WM. R. GRAY ASSOC. INC.
7547 MENTOR AVE.
MENTOR, OHIO

DATE: MAR. 30, 1976 SCALE: 1" = 20'

CERTIFICATION:

I HEREBY CERTIFY THAT THIS PLAT IS CORRECT TO THE BEST OF MY KNOWLEDGE.

By: Wm. R. Gray
WM. R. GRAY R.S. # 2752

STATE OF OHIO
WM. R. GRAY
2752
REGISTERED
PROFESSIONAL SURVEYOR