# SITE PLAN
FOR
# JOHN CHESNIC
BEING S/L 10 IN THE MISTY MEADOWS
SUB'D PAINESVILLE TOWNSHIP,
LAKE COUNTY, OHIO.

This Permit Expires
5/6/93
PAINESVILLE TOWNSHIP
ZONING APPROVED
#8106
Zoning Inspector

SCALE:
1" = 30'

N

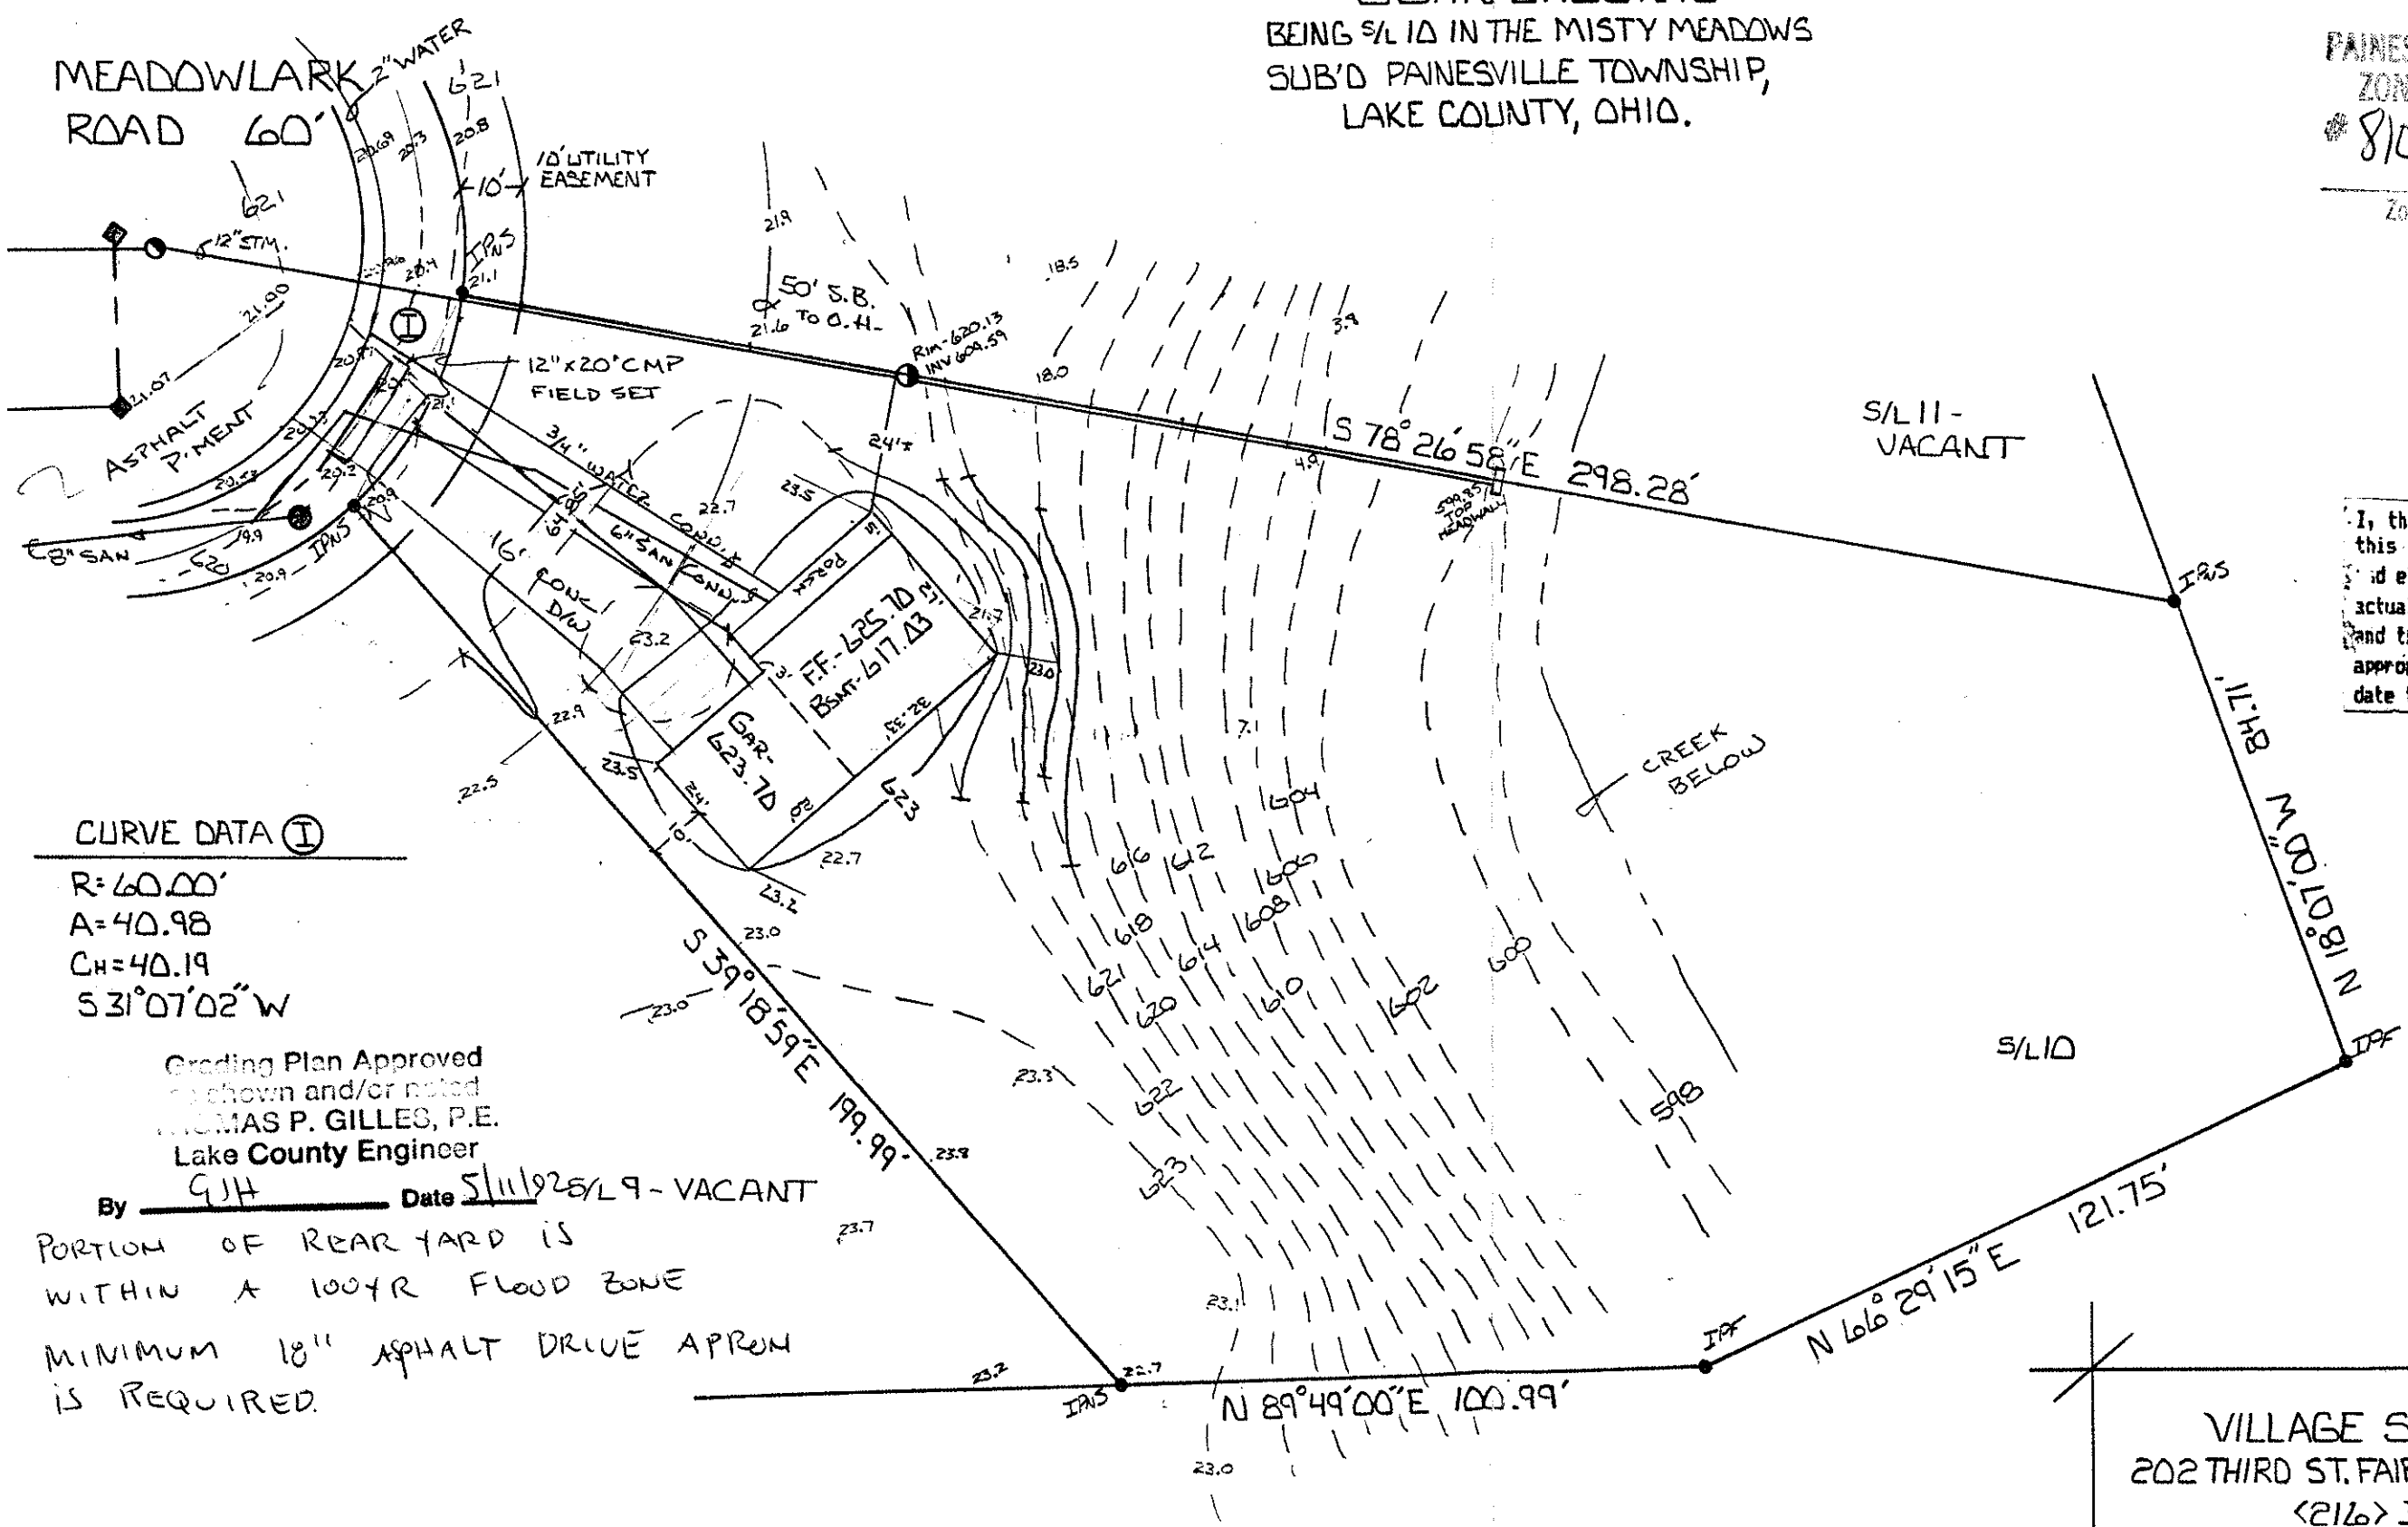


CURVE DATA (I)

R=60.00'
A=40.98
CH=40.19
S 31°07'02"W

Grading Plan Approved
as shown and/or noted
THOMAS P. GILLES, P.E.
Lake County Engineer
By GJH Date 5/11/92

PORTION OF REAR YARD IS WITHIN A 100YR FLOOD ZONE

MINIMUM 18" ASPHALT DRIVE APRON IS REQUIRED.

I, the undersigned hereby certify that this topography, indicated by 1' contour and elevations shown hereon represent an actual field survey made by me on MAY 2, 1992 and that the elevations were taken at appropriate intervals and that as of that date they existed as indicated hereon.

T. M. Coffman PS No 6857

STATE OF OHIO
THOMAS MARC COFFMAN
6857
REGISTERED SURVEYOR

MAY 6, 1992

VILLAGE SURVEYING CO.
202 THIRD ST. FAIRPORT HBR., OHIO 44077
(216) 357-1359