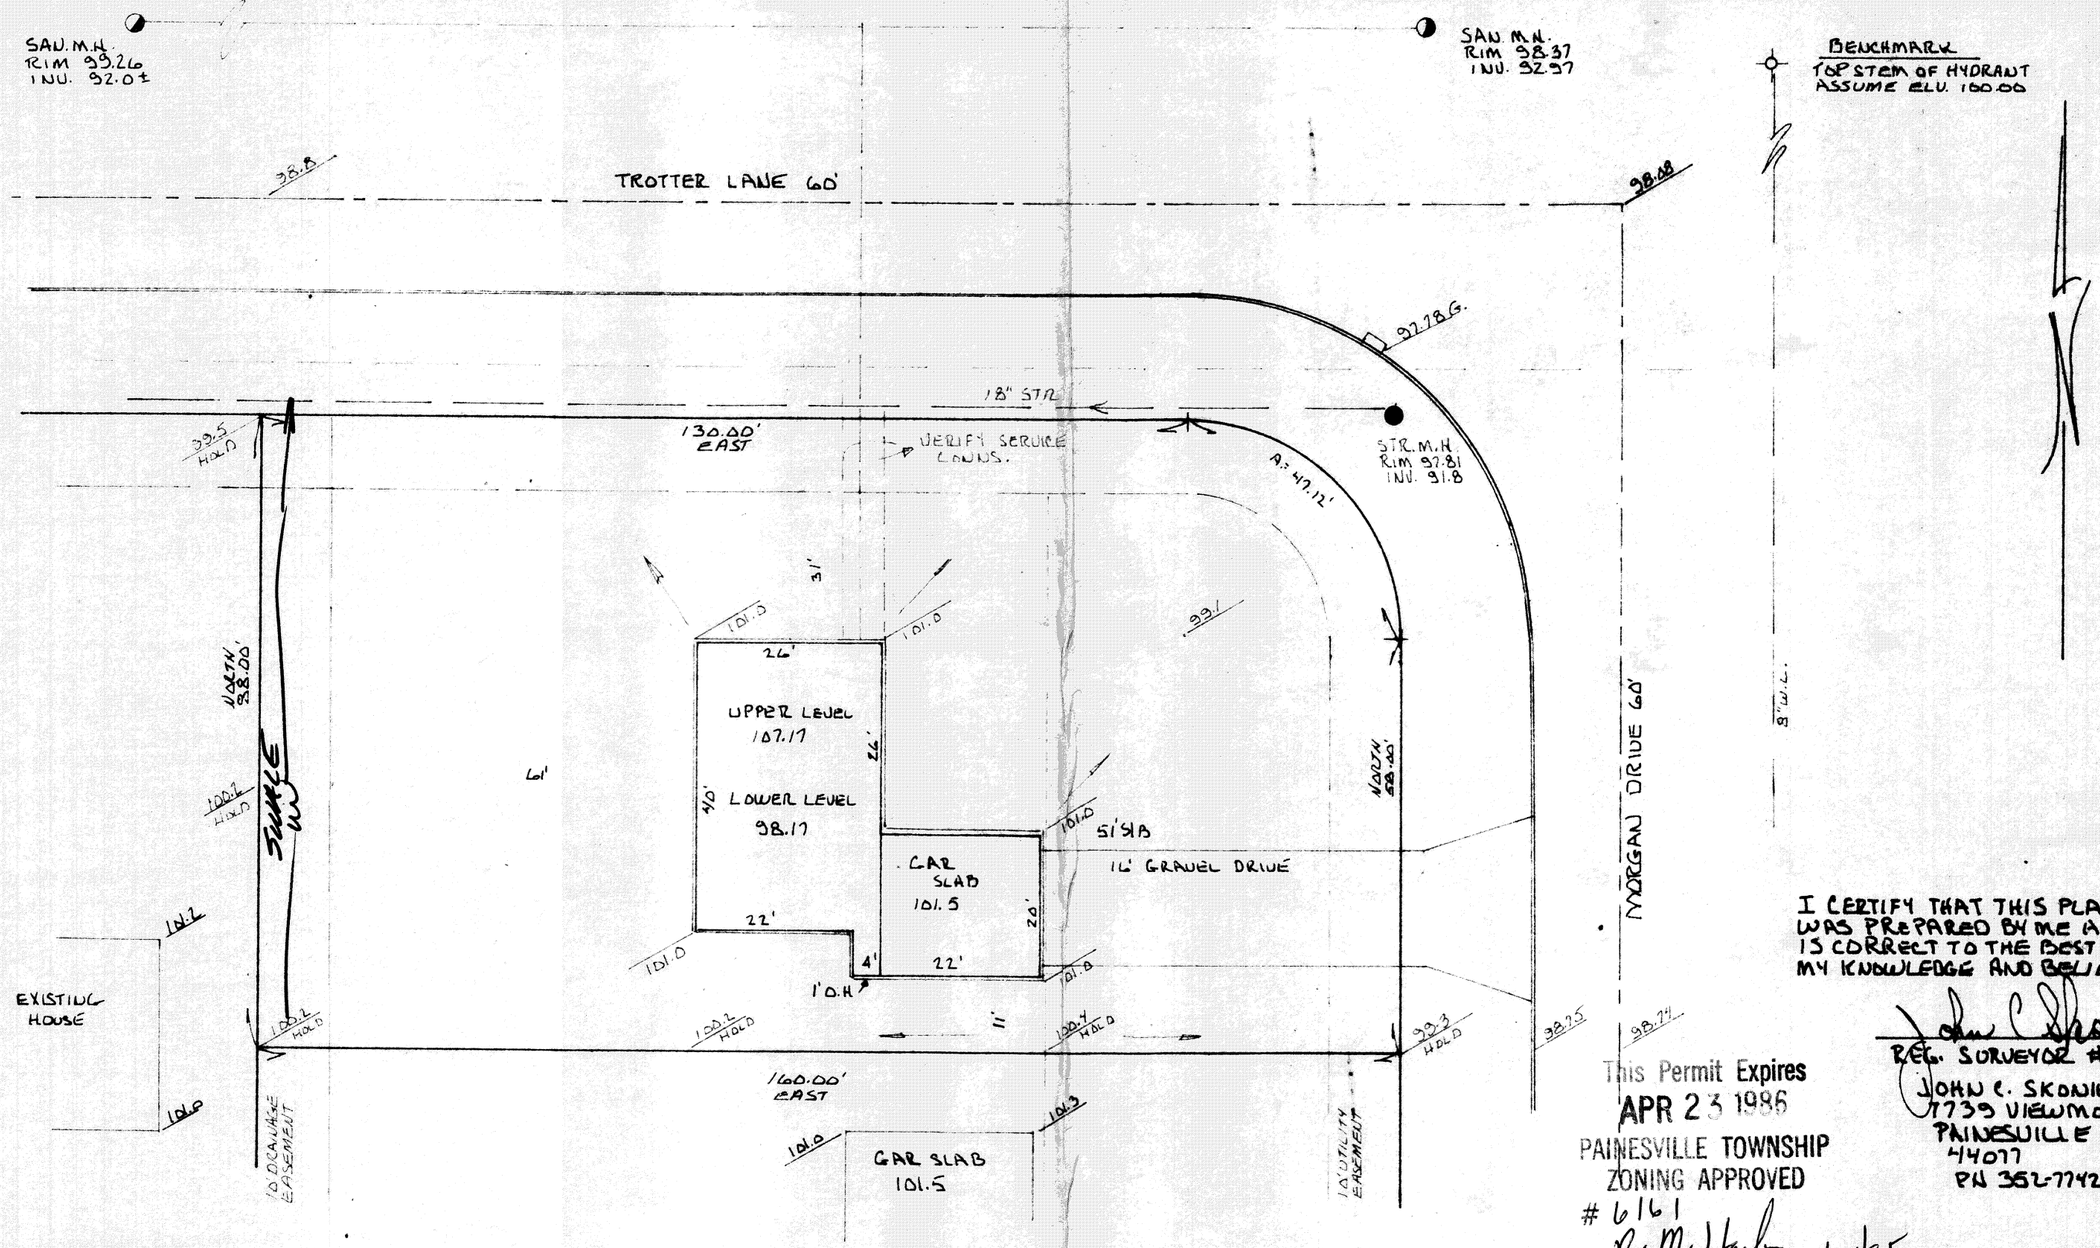

I CERTIFY THAT THIS PLAN WAS PREPARED BY ME AND IS CORRECT TO THE BEST OF MY KNOWLEDGE AND BELIEF.

John C. Skonieczny
REG. SURVEYOR #6356
JOHN C. SKONIECZNY
7739 VIEWMOUNT DR.
PAINESVILLE OHIO
44077
PH 352-7742

This Permit Expires
APR 23 1986
PAINESVILLE TOWNSHIP
ZONING APPROVED
#6161
R. M. Hark 4/24/85
Zoning Inspector

EXISTING / PROPOSED GRADES
→ SWALE

Grading Plan Approved
as shown and/or noted
THOMAS P. GILLES, P.E.
Lake County Engineer
By DMP Date 4-30-85

SITE PLAN
for
IDEAL AMERICAN HOMES

SCALE: 1"=20'	APPROVED BY	DRAWN BY J.C.S.
DATE: APR. 85		
BEING S/L 48 MORGAN DR. ADDRESS: 225 MORGAN		PLAT Y-4-1
PAINESVILLE TOWNSHIP		LAKE COUNTY, OHIO
JOB# 85-373		DRAWING NUMBER 85-502

TELEDYNE POST 18AB-10