SITE PLAN
FOR MR. AND MRS. SCHEUER
OF SUBLOT NO 35 THE NURSERY SUBDIVISION AS SHOWN BY THE PLAT RECORDED IN VOLUME G, PAGE 144 OF LAKE COUNTY MAP RECORD'S SAID LOT LOCATED IN THE TOWNSHIPS OF PERRY AND PAINESVILLE, OHIO
PREPARED BY RALPH W KEMPKE REG. SURVEYOR NO. 6257 IN JAN, 1995
PHONE # 289-9388

FINISH FLOOR GRADES
GARAGE 688.12
1ST FLR 689.3.3

STATE OF OHIO
RALPH W. KEMPKE
6257
REGISTERED SURVEYOR

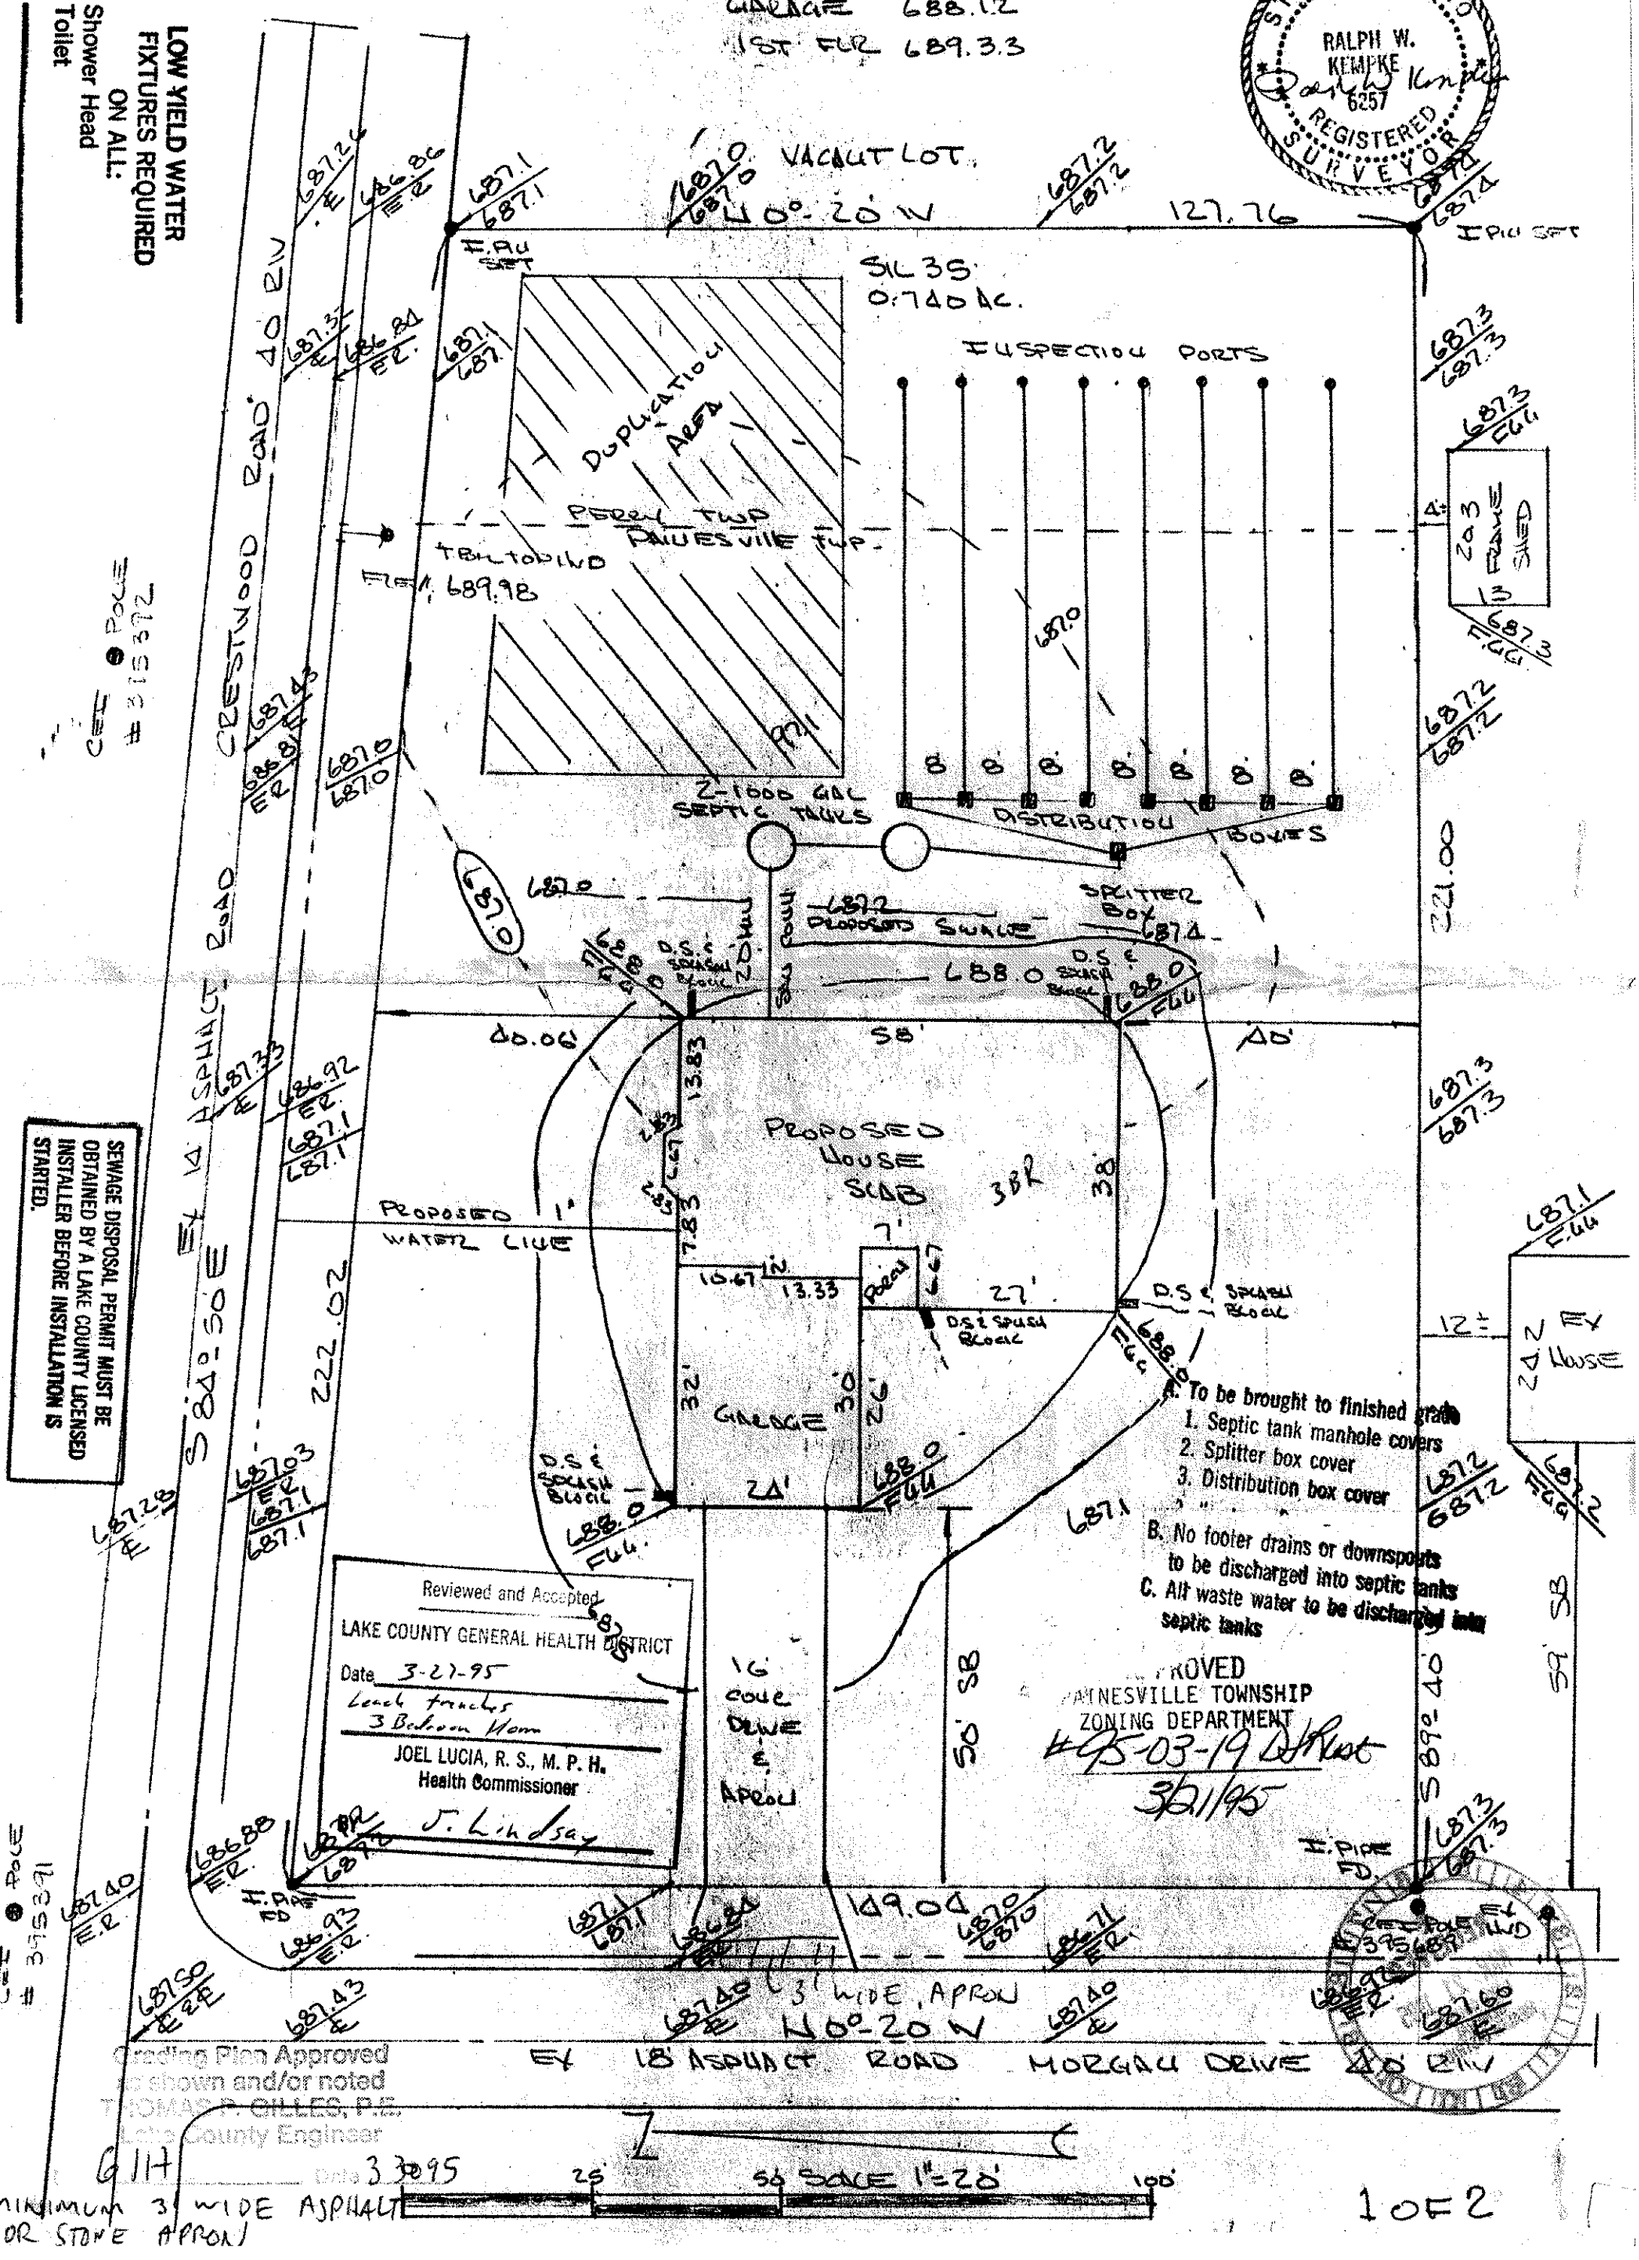

SEWAGE DISPOSAL PERMIT MUST BE OBTAINED BY A LAKE COUNTY LICENSED INSTALLER BEFORE INSTALLATION IS STARTED.

Reviewed and Accepted
LAKE COUNTY GENERAL HEALTH DISTRICT
Date 3-27-95
Leach trenches
3 Bedroom Home
JOEL LUCIA, R. S., M. P. H.
Health Commissioner
J. Lindsay

APPROVED
PAINESVILLE TOWNSHIP
ZONING DEPARTMENT
#95-03-19 D.H. Rust
3/21/95

Grading Plan Approved as shown and/or noted
THOMAS P. GILLES, P.E.
Lake County Engineer
G.H. Date 3-30-95

MINIMUM 3' WIDE ASPHALT OR STONE APRON

SCALE 1"=20'

1 OF 2