S/L 52

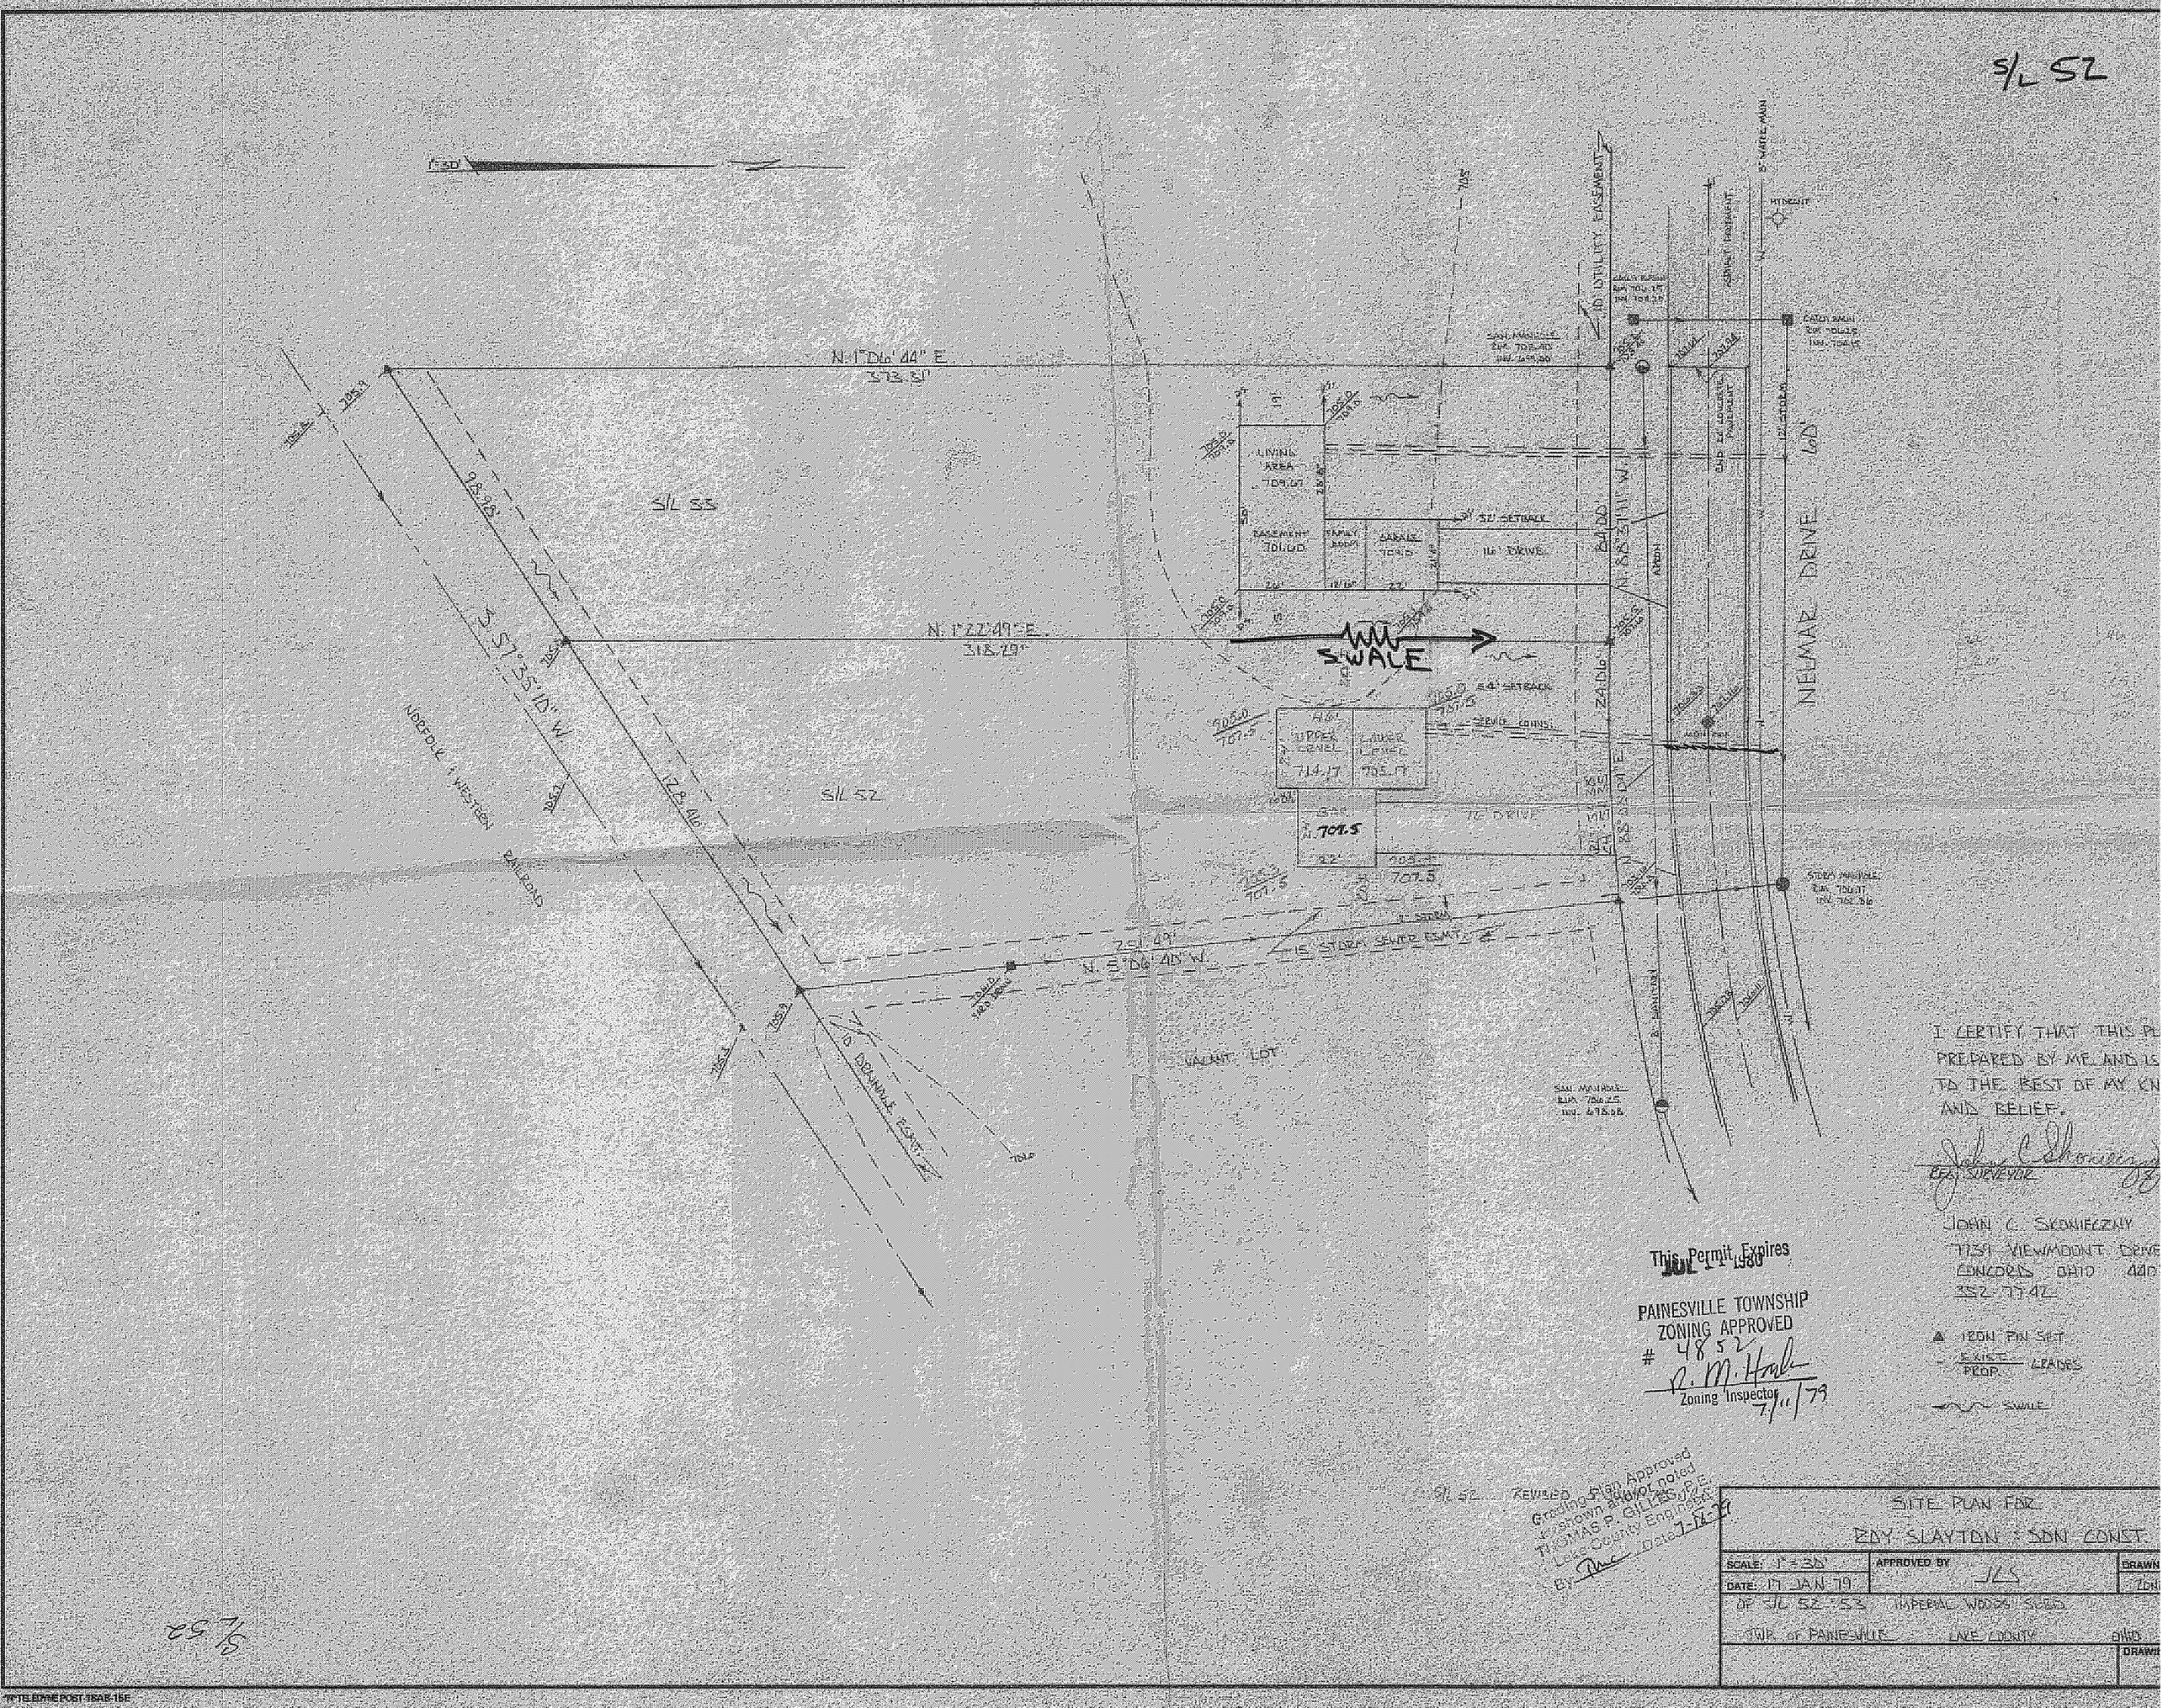


I CERTIFY THAT THIS PL
PREPARED BY ME AND IS
TO THE BEST OF MY KN
AND BELIEF.

REG. SURVEYOR

JOHN C. SKONIECZNY
7739 VIEWMOUNT DRIVE
CONCORD OHIO 440
352-7742

▲ IRON PIN SET
EXIST. / PROP. GRADES
SWALE

This Permit Expires
JUL 1 1980

PAINESVILLE TOWNSHIP
ZONING APPROVED
# 4852
R. M. Hoyle
Zoning Inspector
7/11/79

S/L 52 REVISED
Grading Plan Approved
as shown and/or noted
THOMAS P. GILLES, P.E.
Lake County Engineer
By [signature] Date 7-18-79

SITE PLAN FOR
ROY SLAYTON : SDN CONST.

| | | |
|---|---|---|
| SCALE: 1" = 30' | APPROVED BY JLS | DRAWN |
| DATE: 17 JAN 79 | | ZON |
| OF S/L 52-53 IMPERIAL WOODS SUBD. | | |
| TWP. OF PAINESVILLE LAKE COUNTY OHIO | | DRAWN |

S/L 52

TELEDYNE POST 15AB-15E