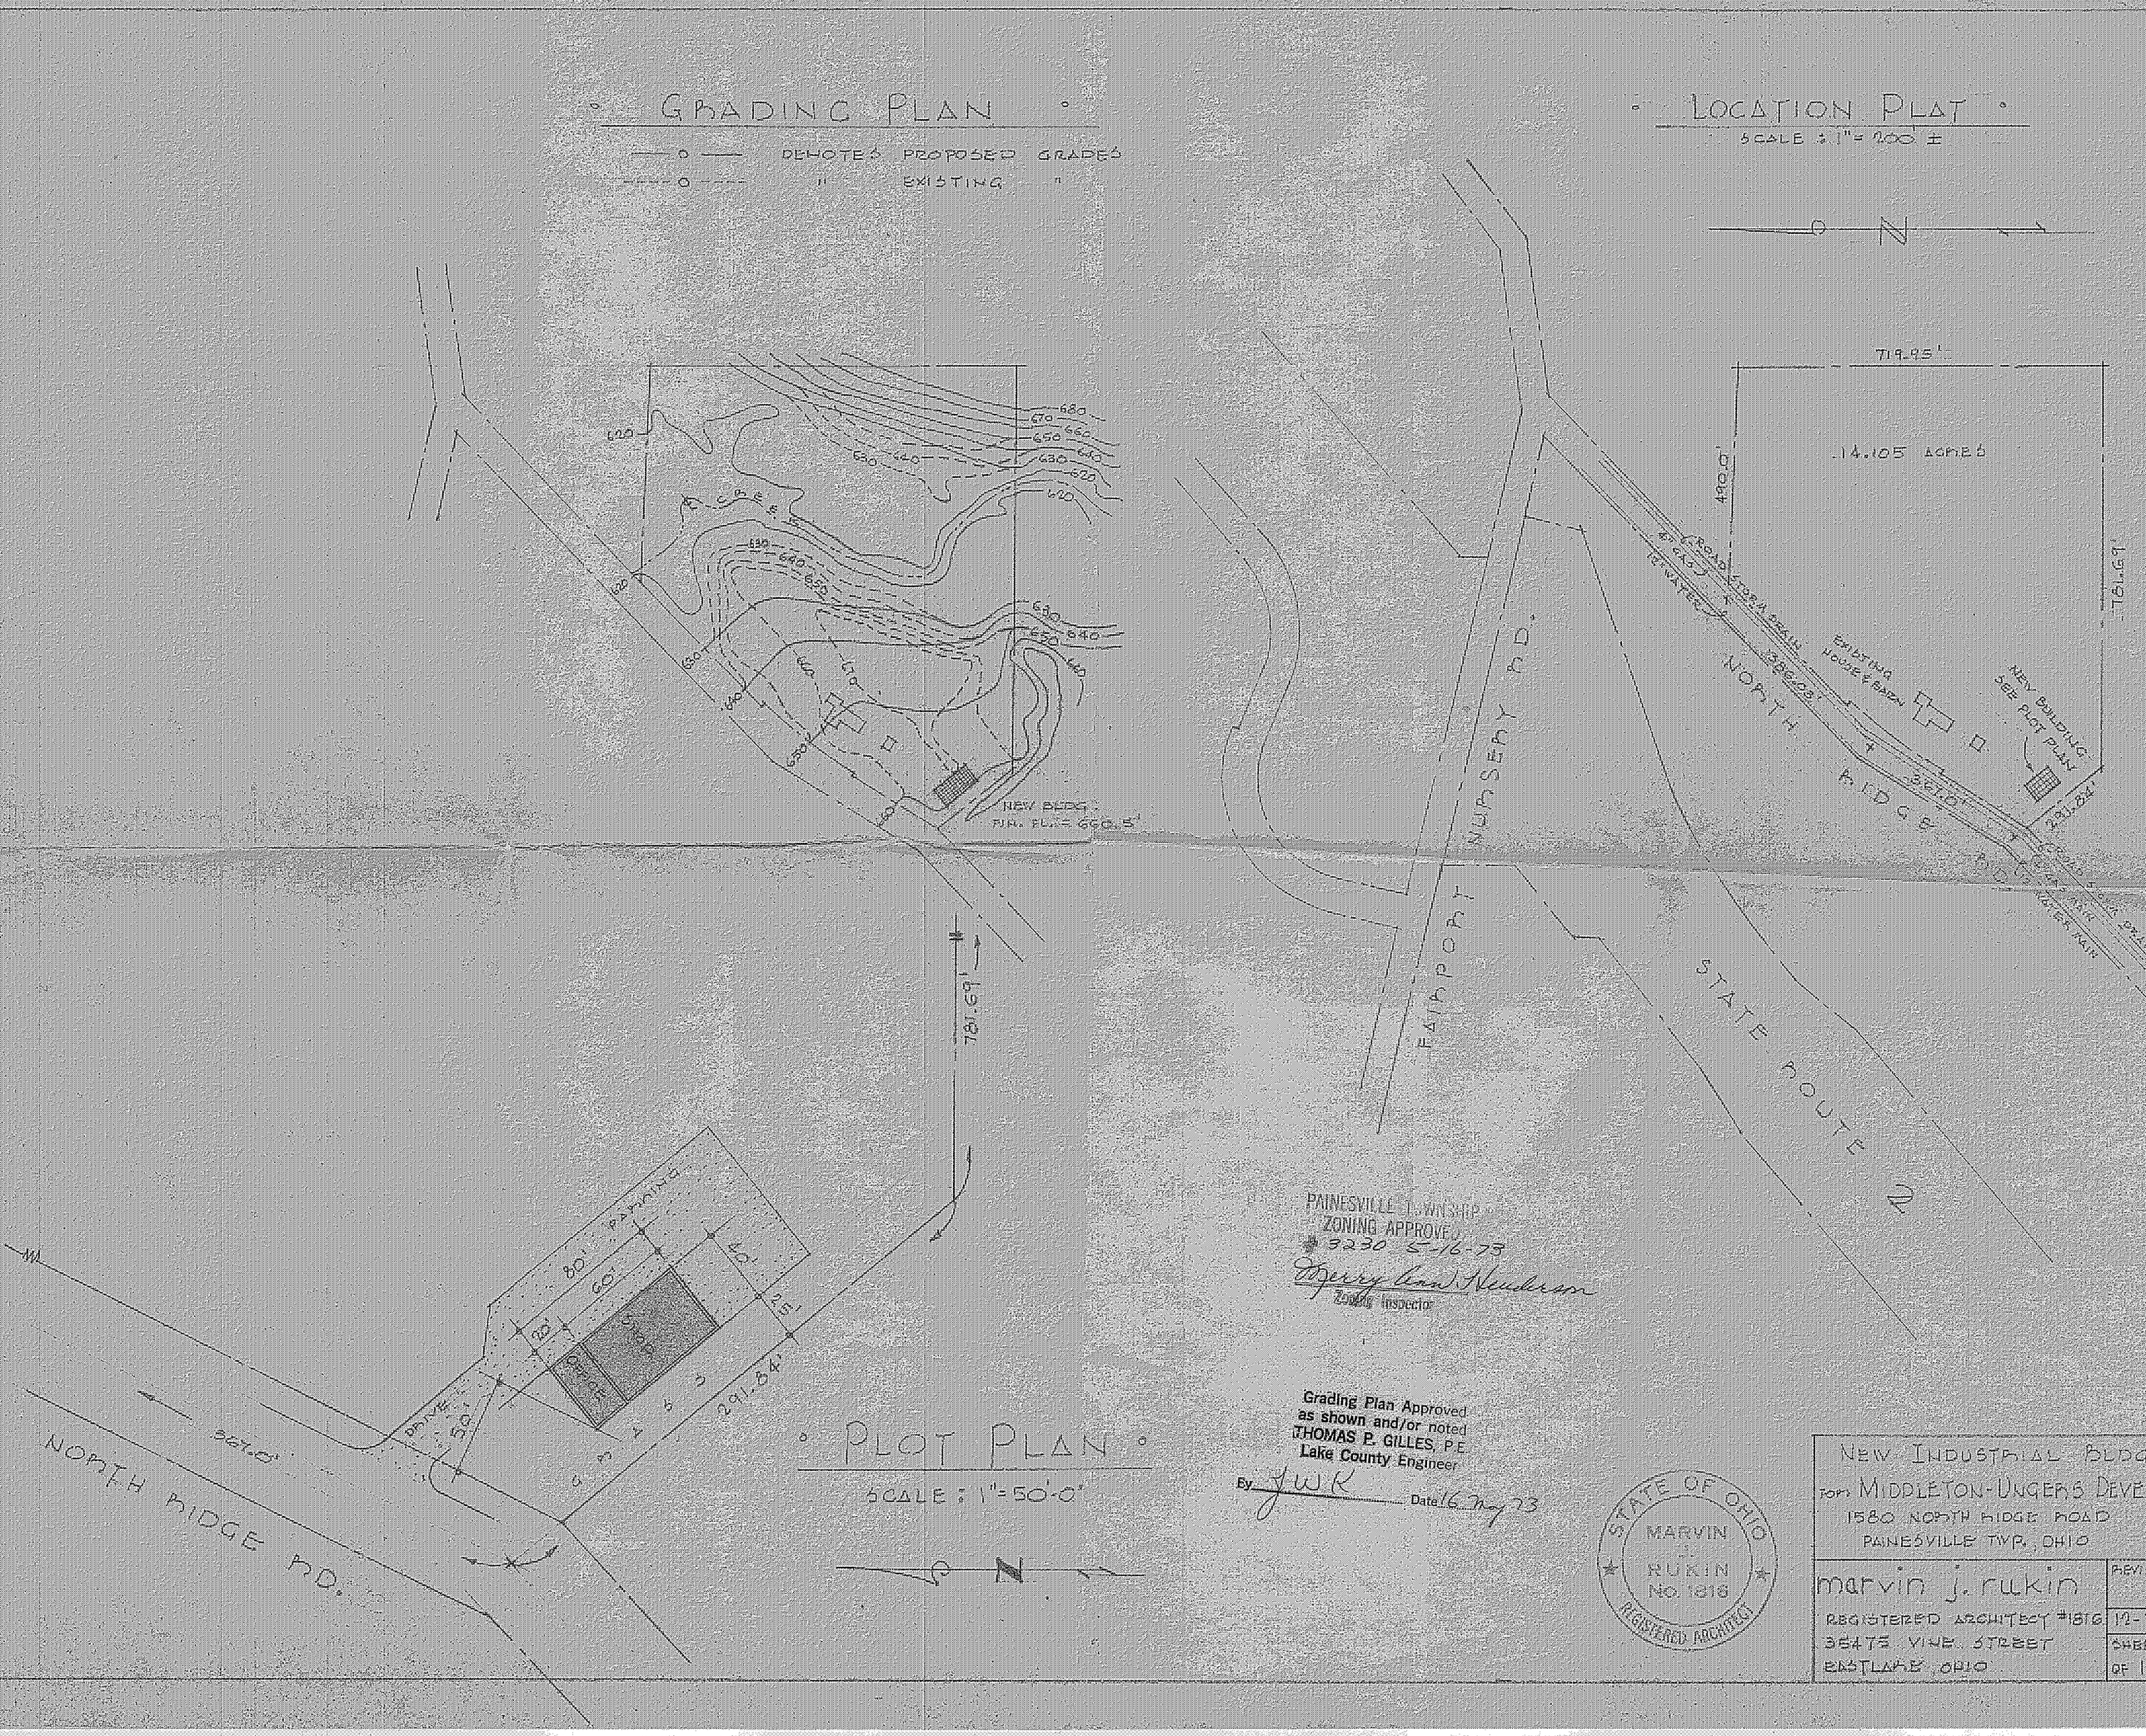
GRADING PLAN
DENOTES PROPOSED GRADES
" EXISTING "
LOCATION PLAT
SCALE : 1" = 200' ±
N
719.95'
14.105 ACRES
490.0'
781.69'
ROAD STORM DRAIN
EXISTING HOUSE & BARN
NEW BUILDING SEE PLOT PLAN
NORTH RIDGE RD.
FAIRPORT NURSERY RD.
STATE ROUTE 2
NEW BLDG. FIN. FL. = 660.5'
781.69'
PARKING
80'
60'
40'
25'
20'
50'
DRIVE
291.84'
367.0'
NORTH RIDGE RD.
PLOT PLAN
SCALE : 1" = 50'-0"
N
PAINESVILLE TOWNSHIP
ZONING APPROVED
3230 5-16-73
Merry Ann Henderson
Zoning Inspector
Grading Plan Approved
as shown and/or noted
THOMAS P. GILLES, P.E.
Lake County Engineer
By JWK Date 16 May 73
STATE OF OHIO
MARVIN J. RUKIN
No. 1816
REGISTERED ARCHITECT
NEW INDUSTRIAL BLDG
FOR MIDDLETON-UNGERS DEVE
1580 NORTH RIDGE ROAD
PAINESVILLE TWP., OHIO
marvin j. rukin
REGISTERED ARCHITECT #1816
35475 VINE STREET
EASTLAKE, OHIO
REV
12-
SHE
OF