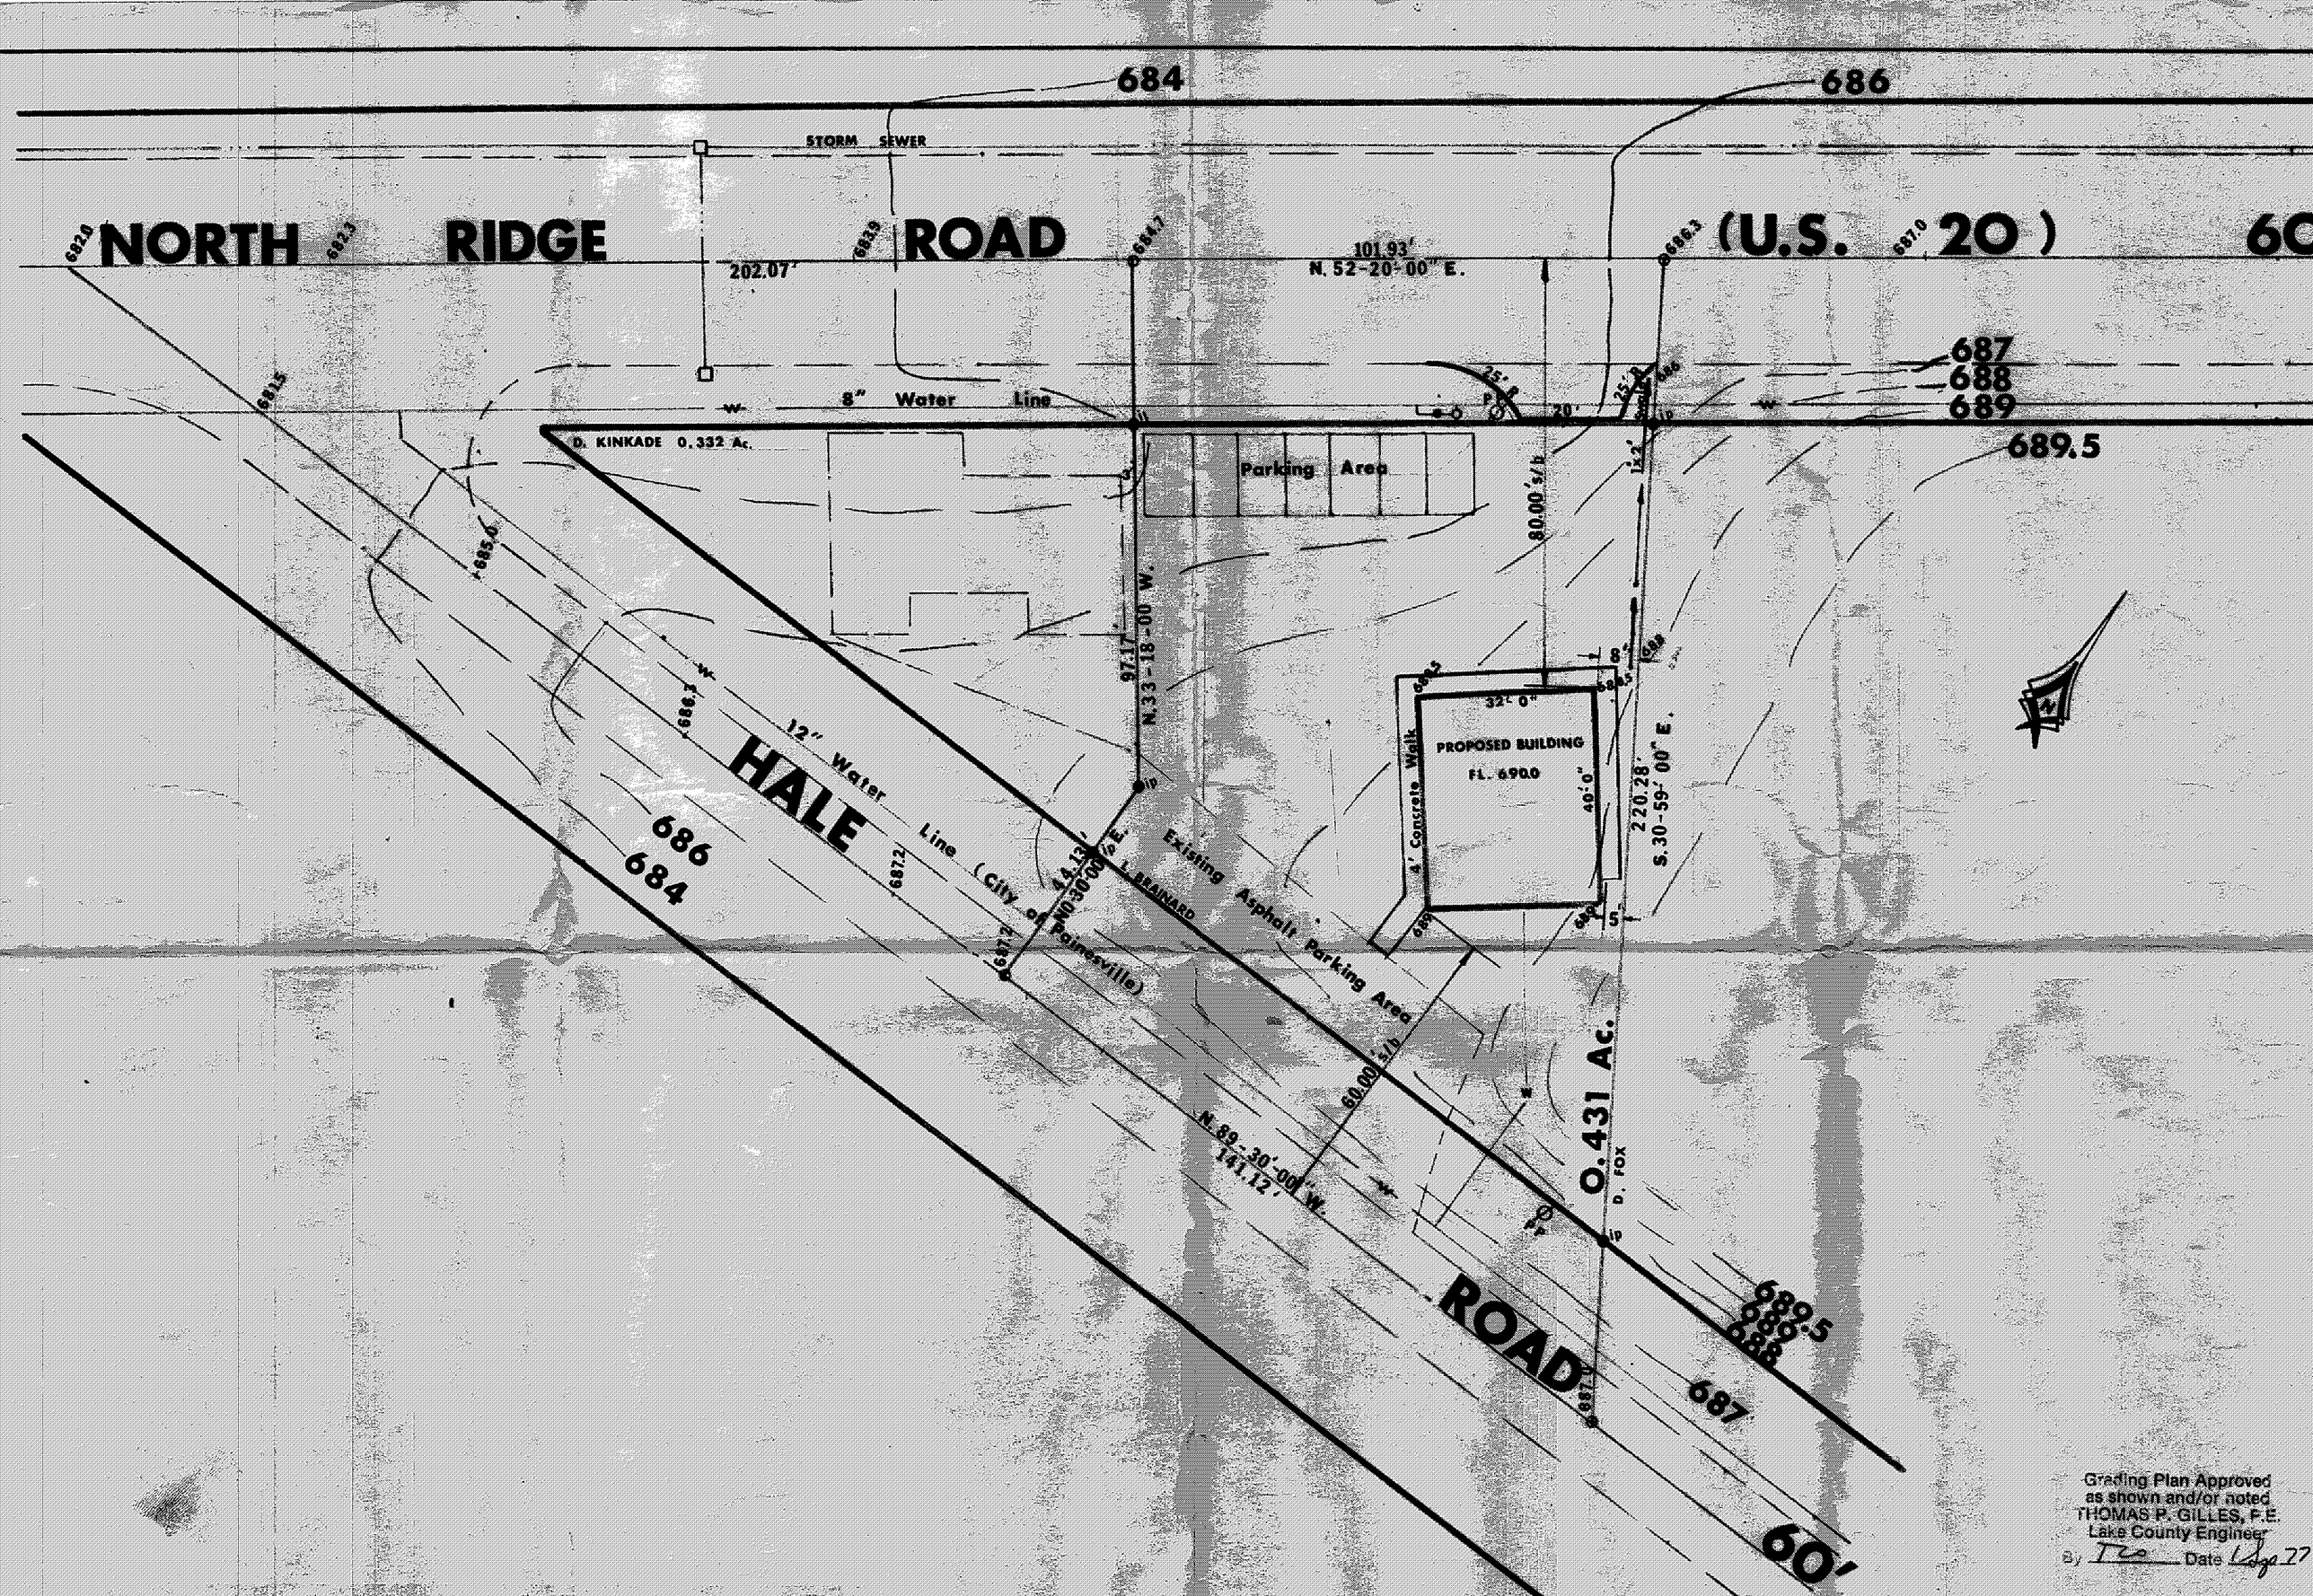

Grading Plan Approved
as shown and/or noted
THOMAS P. GILLES, P.E.
Lake County Engineer
By TPG Date 8/29/77

I HEREBY CERTIFY THAT I HAVE PREPARED THIS SITE PLAN, AND THAT THE BEARINGS, DISTANCES, LOCATION OF PROPERTY PINS, AND OTHER PARTICULARS SHOWN ARE CORRECT.

DATE: 8/24/77

ROBERT J. ALBAN, P.E.
REGISTERED CIVIL ENGINEER (P.E. 34873)
and LAND SURVEYOR (L.S. 5711)

STATE OF OHIO · ROBERT J. ALBAN 34873 · REGISTERED PROFESSIONAL ENGINEER

STATE OF OHIO · ROBERT J. ALBAN 5711 · REGISTERED SURVEYOR

BRAINARD SITE PLAN

SCALE: 1:20	APPROVED BY:	DRAWN BY
DATE: 8/24/77		REVISED

Painesville Twp.; Lake Coun

PART of PERM. PARCEL 11-35A-5 — DRAWING

OCE INDUSTRIES INC. #2310 ELLCO VEL T/P