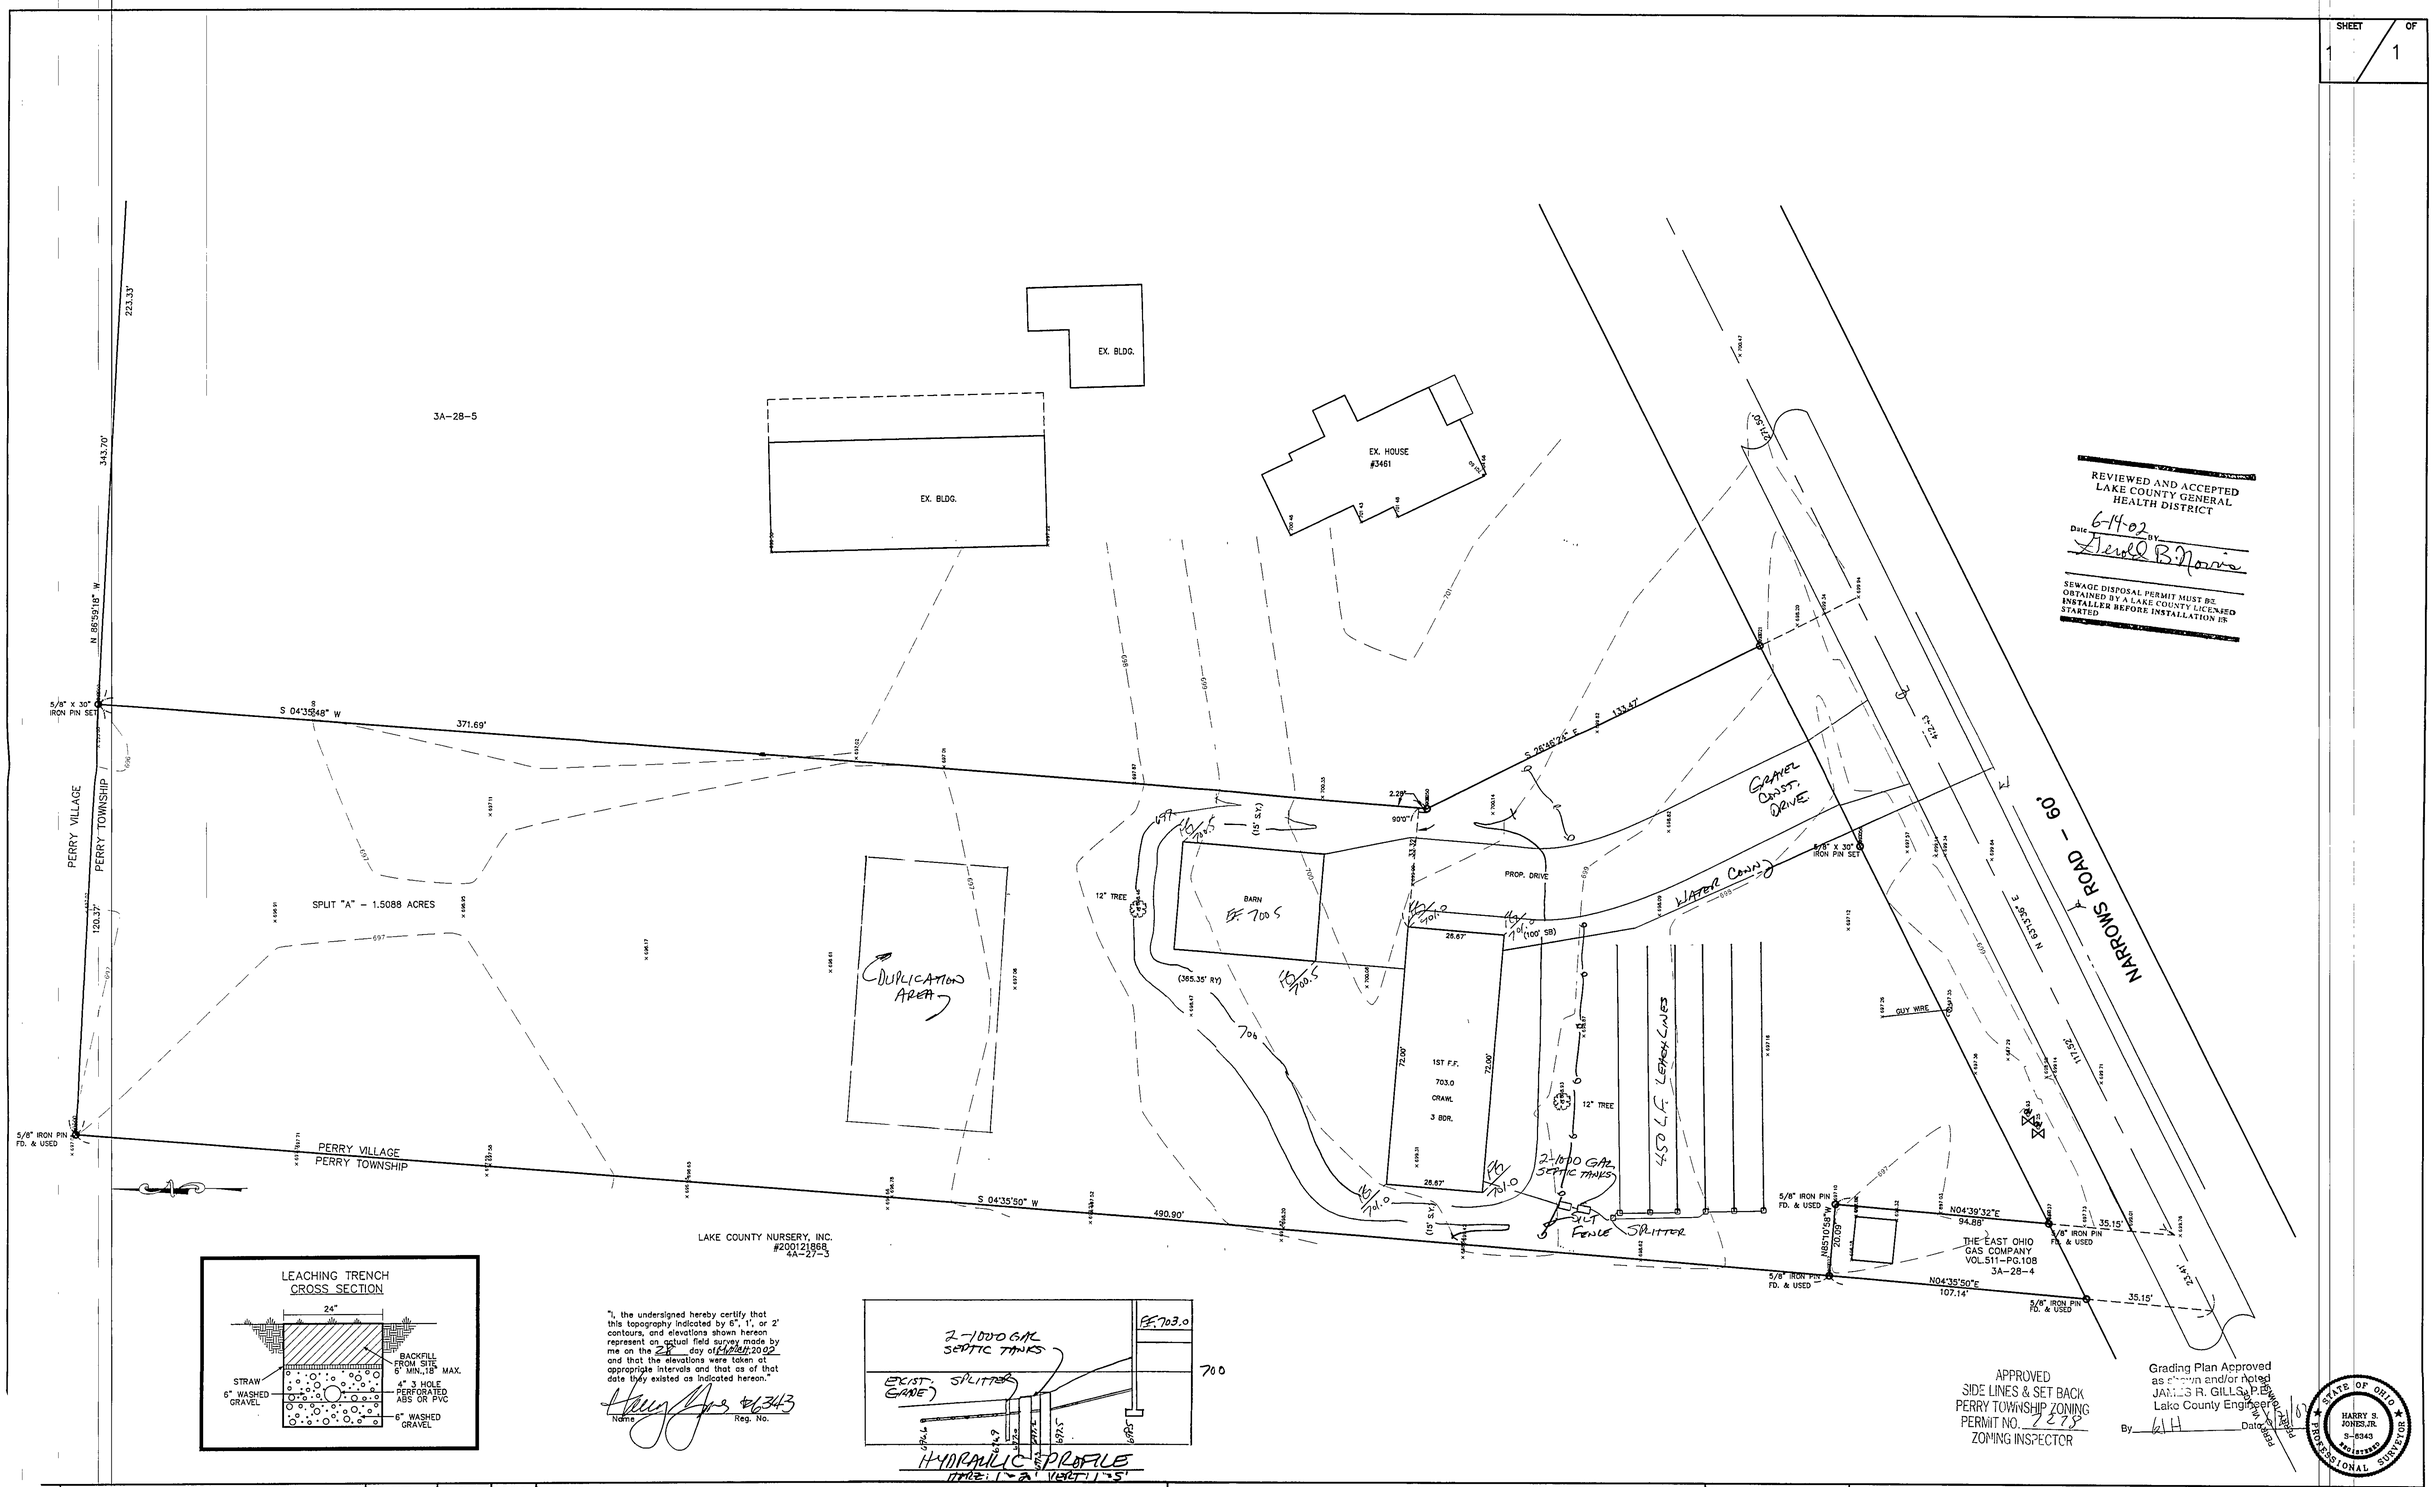

NO.	DESCRIPTION	DATE	BY	CHK'D
	HSE/BARN CHANGE	5/31/02	H.J.	H.J.

BABCOCK, JONES AND ASSOCIATES, INC
CIVIL ENGINEERS – SURVEYORS – LAND PLANNERS
PAINESVILLE OHIO 44077

DATE	5/24/02
DESIGN BY	H.J.
DRAWN BY	M.M.
APPROVED BY	H.J.

SITE PLAN FOR CHARLES EISENHART

TOWNSHIP OF PERRY LAKE COUNTY, OHIO

SCALE:	1"=20'
JOB NO	01-244
SHEET	1 OF 1