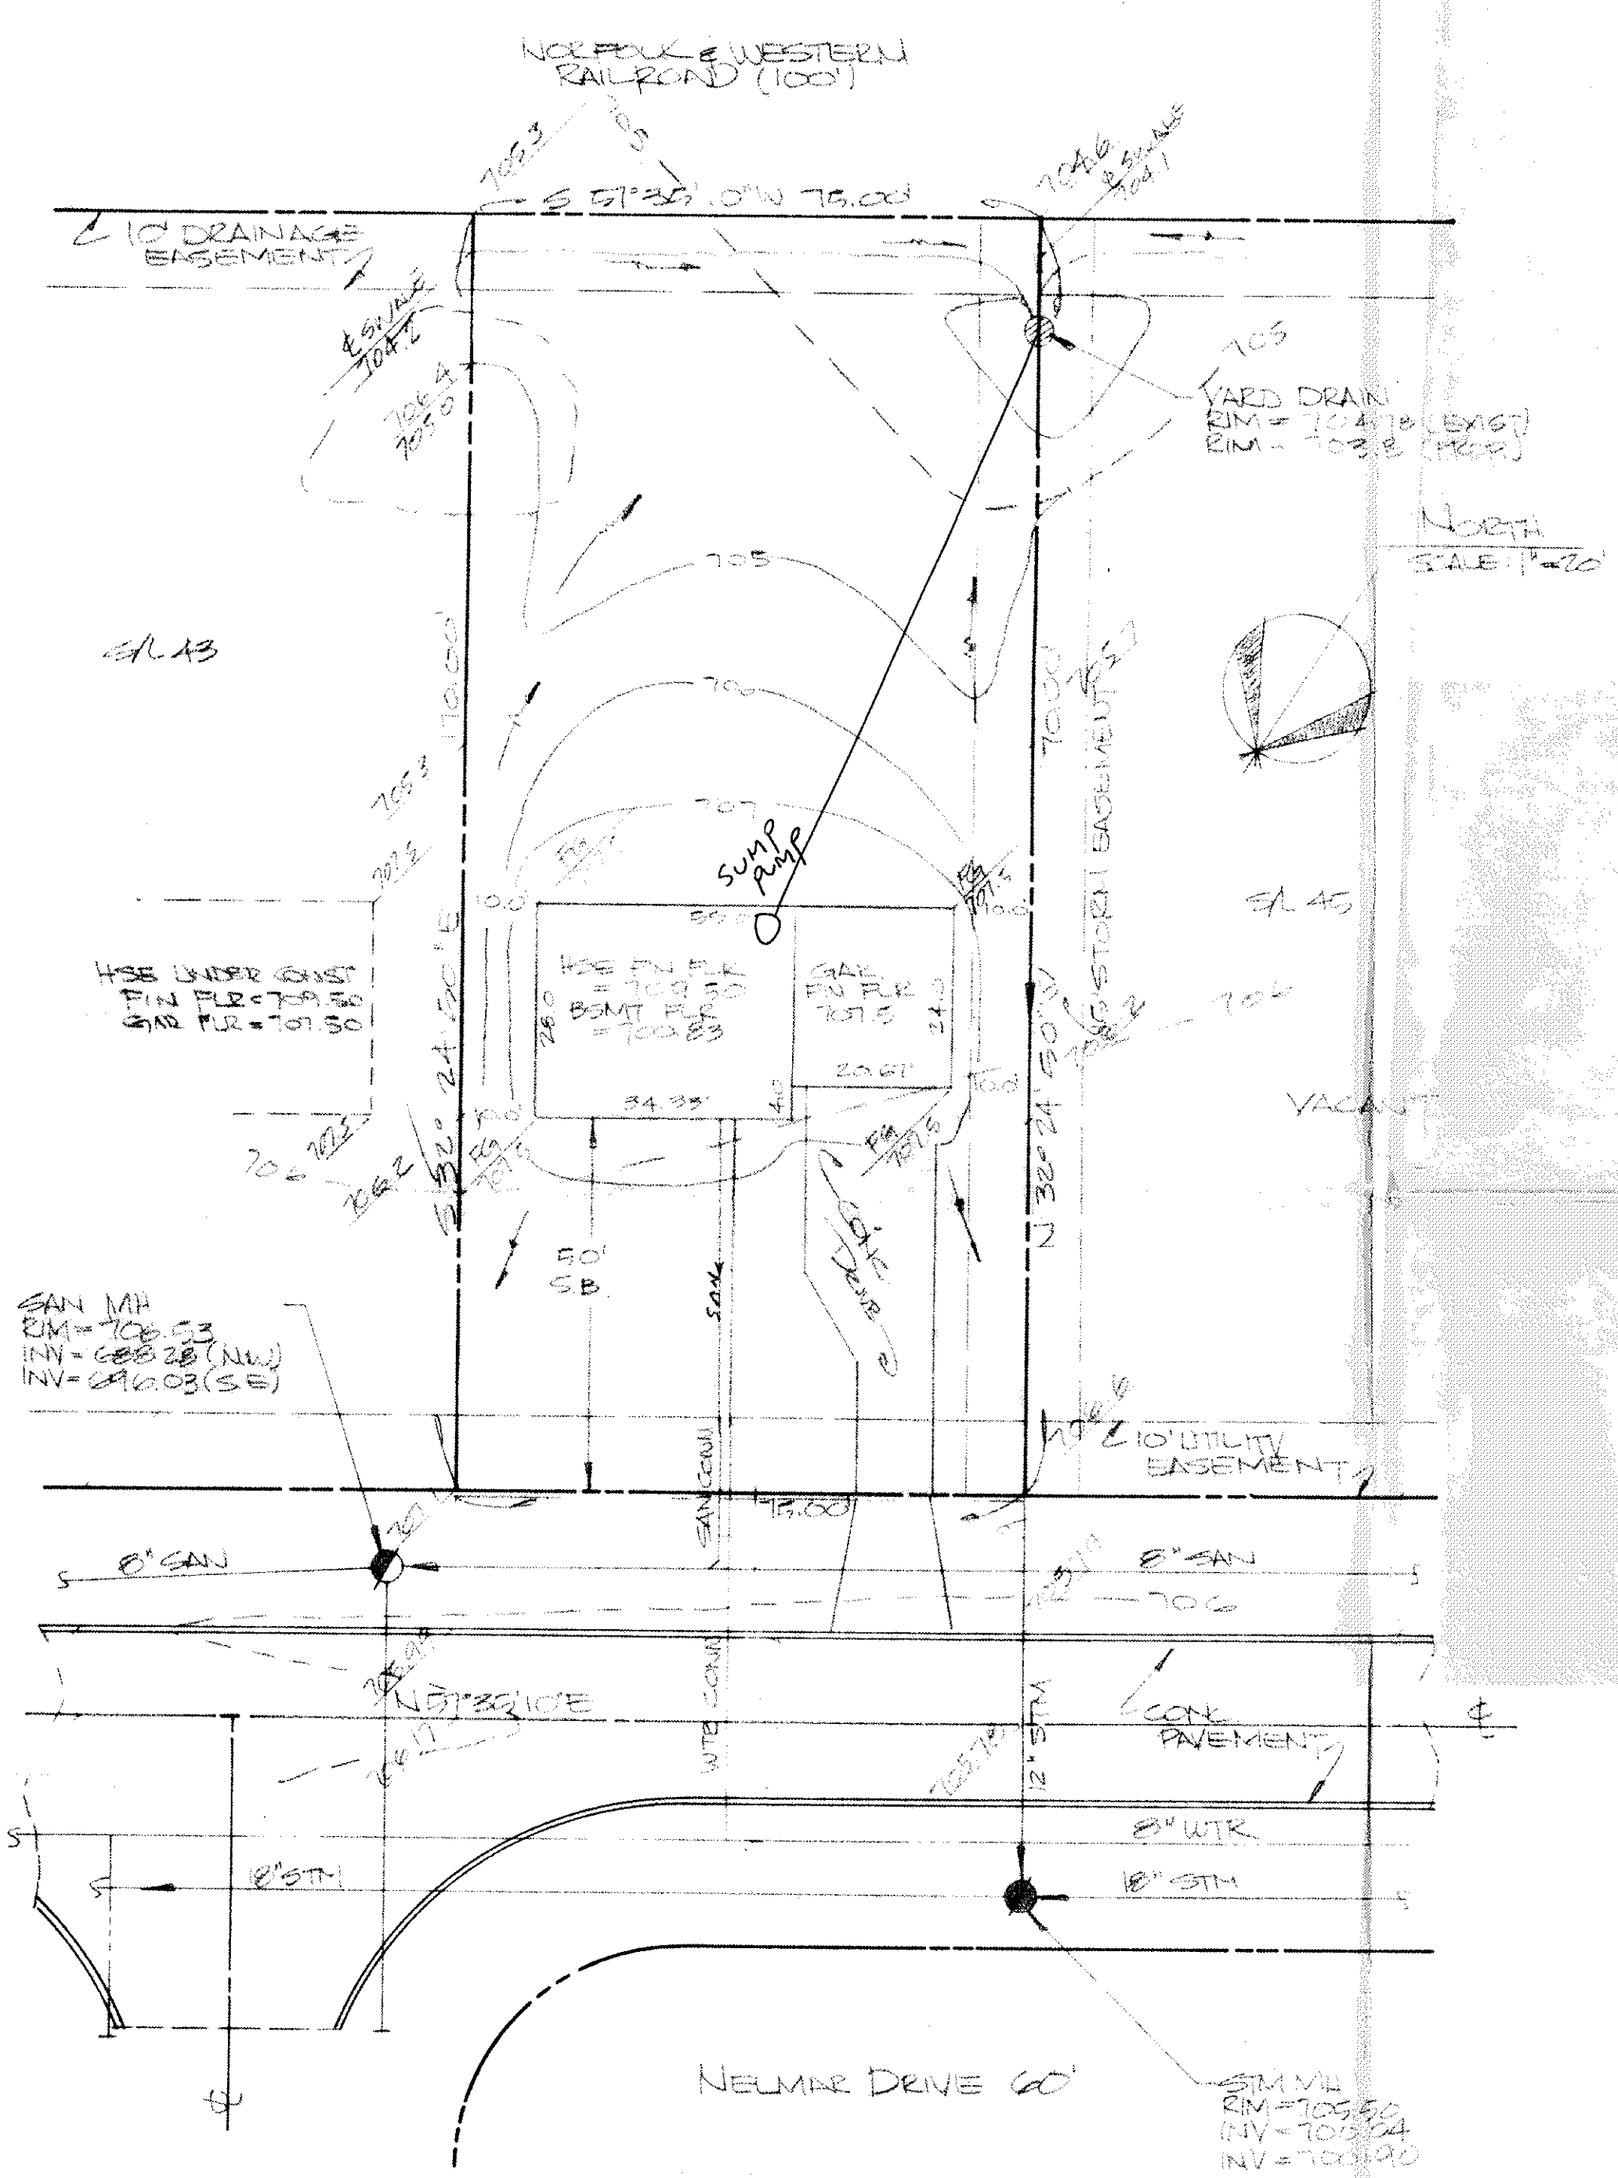

NOTE:

1. DRIVEWAY TO HAVE 6" THK APRON
2. DOWNSPOUTS TO BE OUTLET TO SPLASH BLOCKS
3. SUMP PUMP REQUIRED FOR BASEMENT
4. BENCHMARK — TOP FIRE HYDRANT ACROSS FROM SUBLOT 42 TOP STEM = 709.21

EXISTING CONTOUR
PROPOSED CONTOUR
100.00 / 100.00 EXISTING ELEVATION / PROPOSED ELEVATION
DIRECTION OF SURFACE DRAINAGE

Grading Plan Approved
as shown and/or noted
THOMAS P. GILLES, P.E.
Lake County Engineer
By GJH Date 8/6/90

1. CONNECT SUMP PUMP TO STM. SEWER

This Permit Expires
4-20-91
PAINESVILLE TOWNSHIP
ZONING APPROVED
7486 DgRwt
Zoning Inspector

THIS PLAN WAS PREPARED BY ME AND IS CORRECT TO THE BEST OF MY KNOWLEDGE
Quent Humbaugh PS #6820

STATE OF OHIO
QUENTIN S. HUMBAUGH
REGISTERED SURVEYOR

SITE PLAN - SUBLOT 44 NELMAR DRIVE IMPERIAL WOODS SUB #2 PAINESVILLE TWP.		
SCALE: 1"=20' DATE: FEB 28, 1990	APPROVED BY Q. Humbaugh	DRAWN BY DNOVAK
PLAN PREPARED BY: HIMEBAUGH AND ASSOCIATES 38085 W. SPAULDING ST. WILLOUGHBY OH 44094		
216-946-1761		DRAWING NUMBER 90-016-44

TELEDYNE POST 18AB-14 – 17 x 22