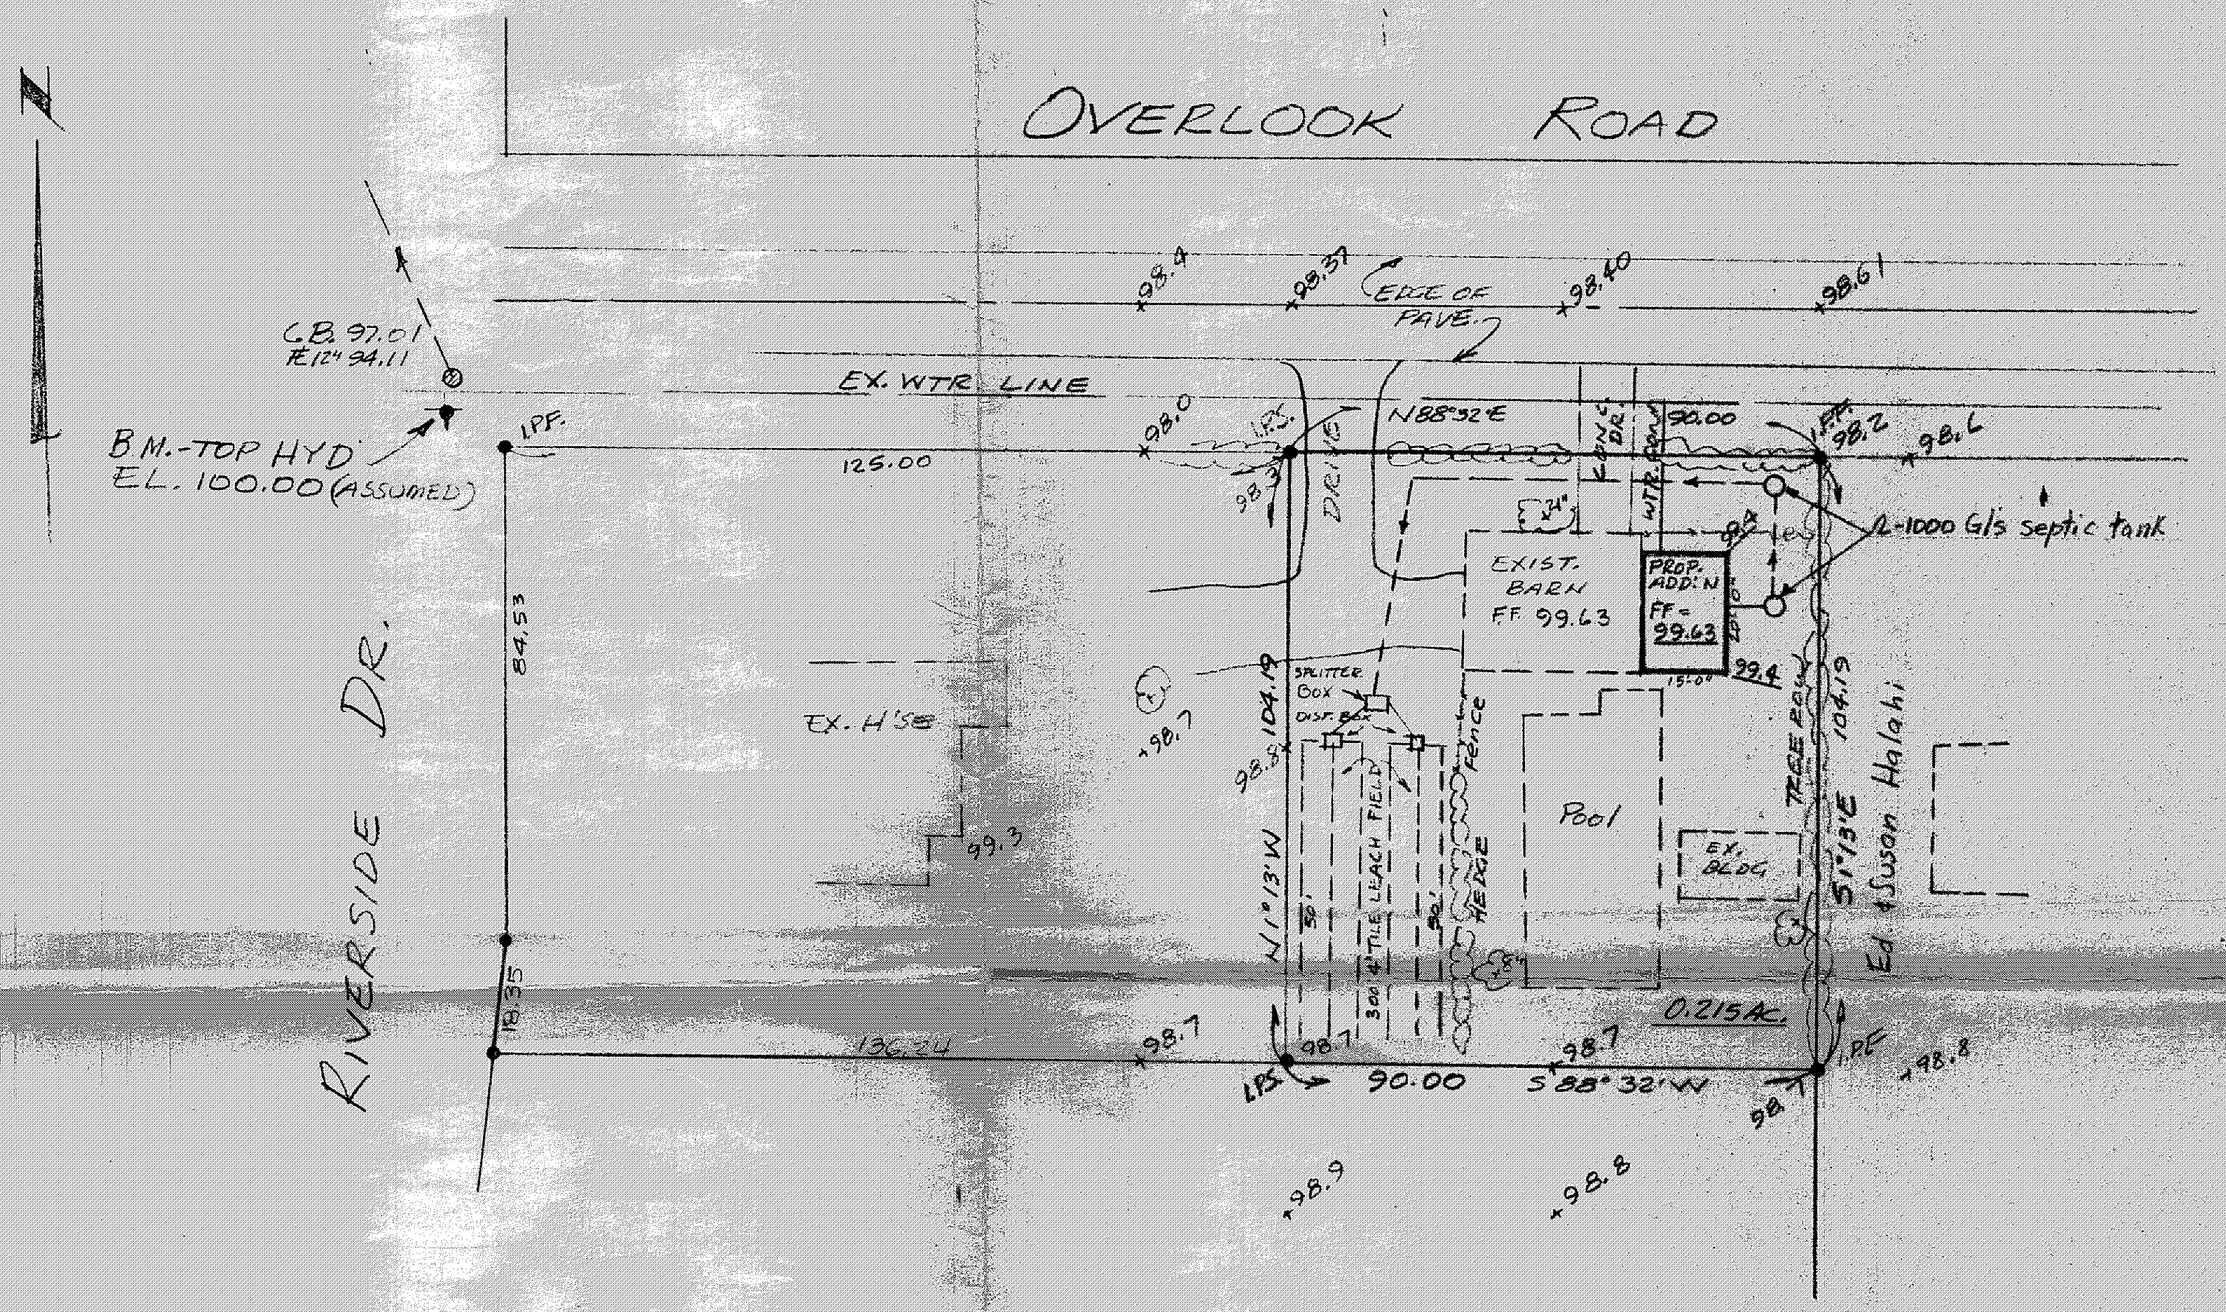

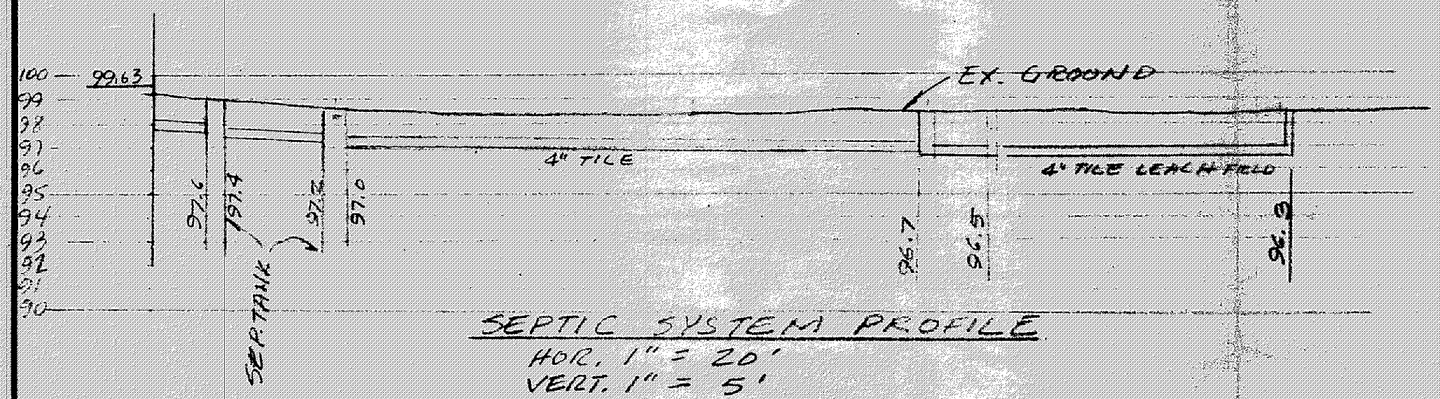

SEPTIC SYSTEM PROFILE
HOR. 1" = 20'
VERT. 1" = 5'

PAINESVILLE TOWNSHIP
ZONING APPROVED
4333 1-17-78
Zoning Inspector

Grading Plan Approved
as shown and/or noted
THOMAS P. GILLES, P.E.
Lake County Engineer
By _____ Date 5 MAY 78

DESIGN CERTIFICATION
THIS PLAT WAS PREPARED BY ME AND IS CORRECT TO THE BEST OF MY KNOWLEDGE AND BELIEF.
REG. SURVEYOR No. 4785

"AS BUILT CERTIFICATION"
I HEREBY CERTIFY THAT THE CIRCLED GRADES ARE EXISTING FINISH GRADES CHECKED IN FIELD ON _____
AND THAT SURVEY IS CORRECT TO THE BEST OF MY KNOWLEDGE AND BELIEF.

SITE PLAN & BOUNDARY SURVEY
FOR
JOHN GALEAZZO
PT. S/L 81 RIVERSIDE HTS VOL. G-12 - PAINESVILLE TWP - LAKE COUNTY.

DATE 4-14-78
SCALE 1" = 20'
DRAWN BY
CH'K'D BY
F.B. 318 PG.

Colpetzer • Woods Consultants, Inc.
CONSULTING ENGINEERS AND SURVEYORS
PAINESVILLE, OHIO 44077

SHEET 1
CONTRACT 7806