* SUMP PUMP SHALL DISCHARGE INTO STORM LATERAL

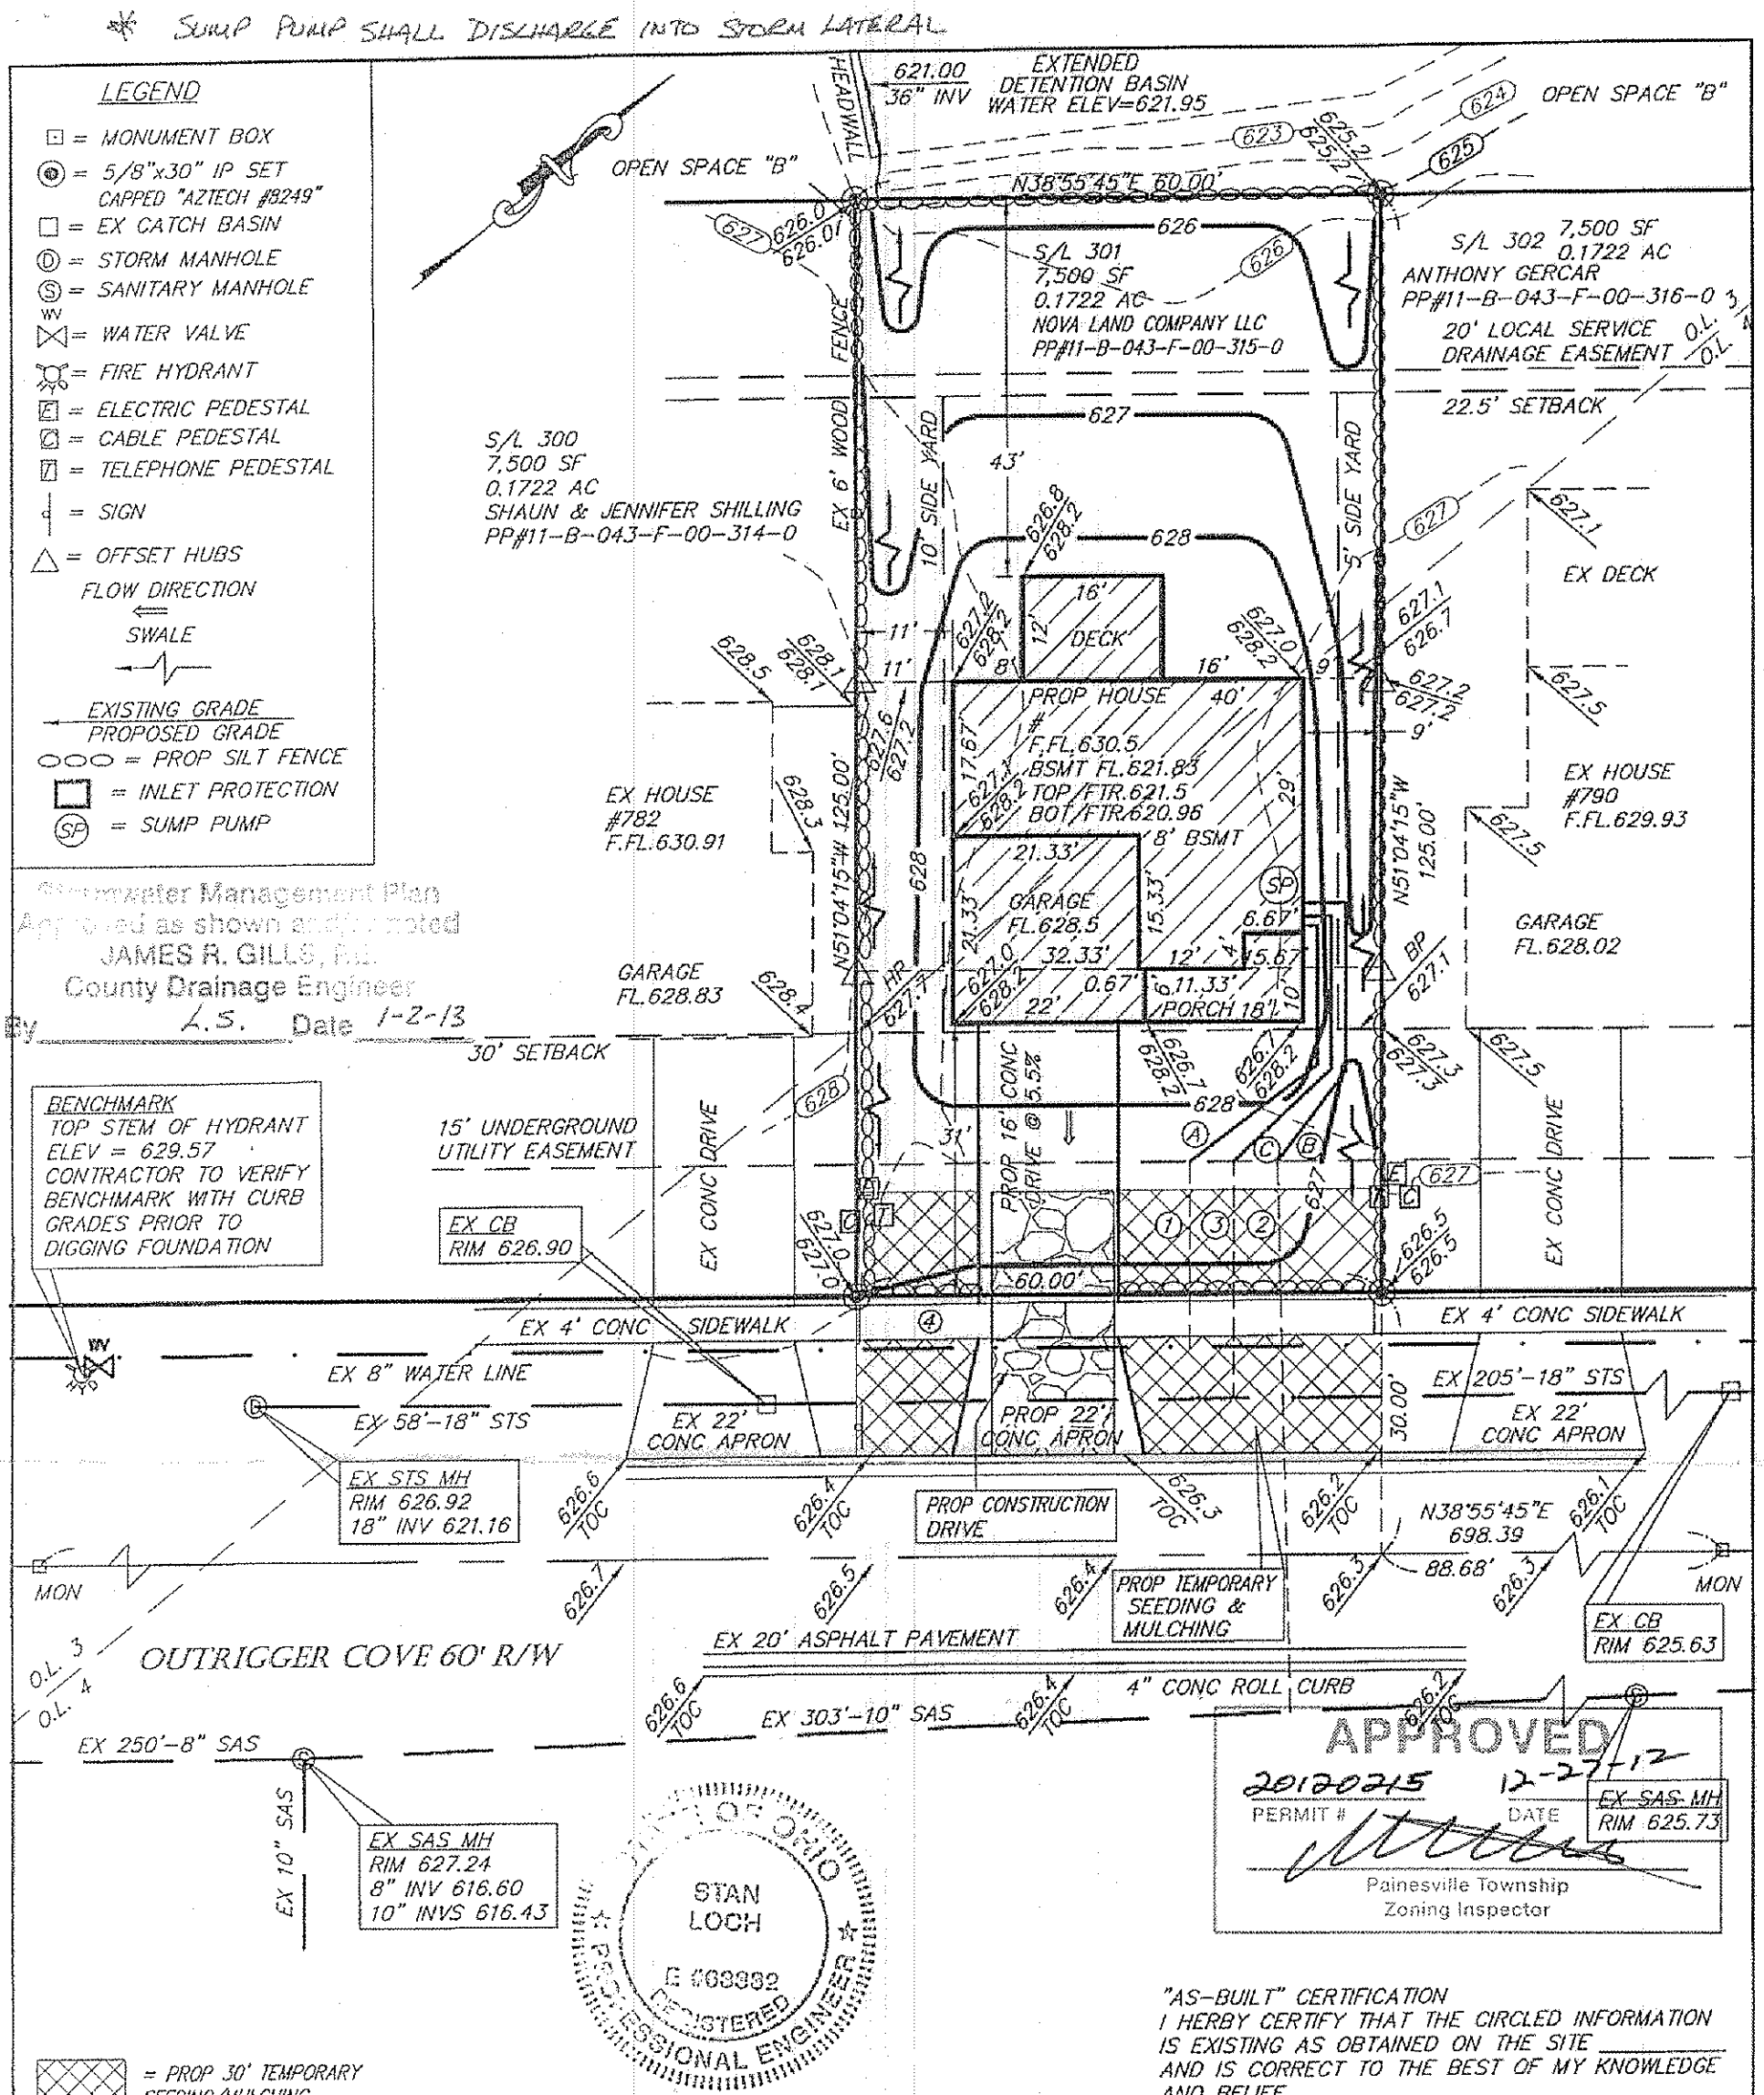

"AS-BUILT" CERTIFICATION
I HERBY CERTIFY THAT THE CIRCLED INFORMATION IS EXISTING AS OBTAINED ON THE SITE _____ AND IS CORRECT TO THE BEST OF MY KNOWLEDGE AND BELIEF.

STAN R. LOCH REG.#

"I, THE UNDERSIGNED HEREBY CERTIFY THAT THIS TOPOGRAPHY, INDICATED BY 6", (1) OR 2' CONTOURS, AND ELEVATIONS SHOWN HEREON REPRESENT AN ACTUAL FIELD SURVEY MADE BY ME ON THE 14TH DAY OF DECEMBER, 20 12 AND THAT THE ELEVATIONS WERE TAKEN AT APPROPRIATE INTERVALS AND THAT AS OF THAT DATE THEY EXISTED AS INDICATED HEREON."

12-21-12
STAN R. LOCH P.S. REG.# 8249

HORIZ. SCALE: 1" = 20'	VERT. SCALE:	5425 WARNER ROAD - SUITE 12 VALLEY VIEW, OHIO 44125 440-602-9071 FAX 216-369-0259 AZTECH ENGINEERING + SURVEYING Civil Engineering + Land Surveying	SITE PLAN FOR B.R. KNEZ CONSTRUCTION, INC. OUTRIGGER COVE BEING SUBLOT 301 IN THE LAKE ERIE SHORES PHASE 4A PLAT VOLUME 30, PAGE 33 P.P.#11-B-043-F-00-315-0 PAINESVILLE TOWNSHIP, COUNTY OF LAKE STATE OF OHIO
DRAWN BY: CL	DATE: 12-20-2012		
CHECKED BY: SRL	DRAWING NO.: 20112539		
JOB NO.: 20112539	SHEET: 1 OF 2		

NO.	DATE	DESCRIPTION	BY