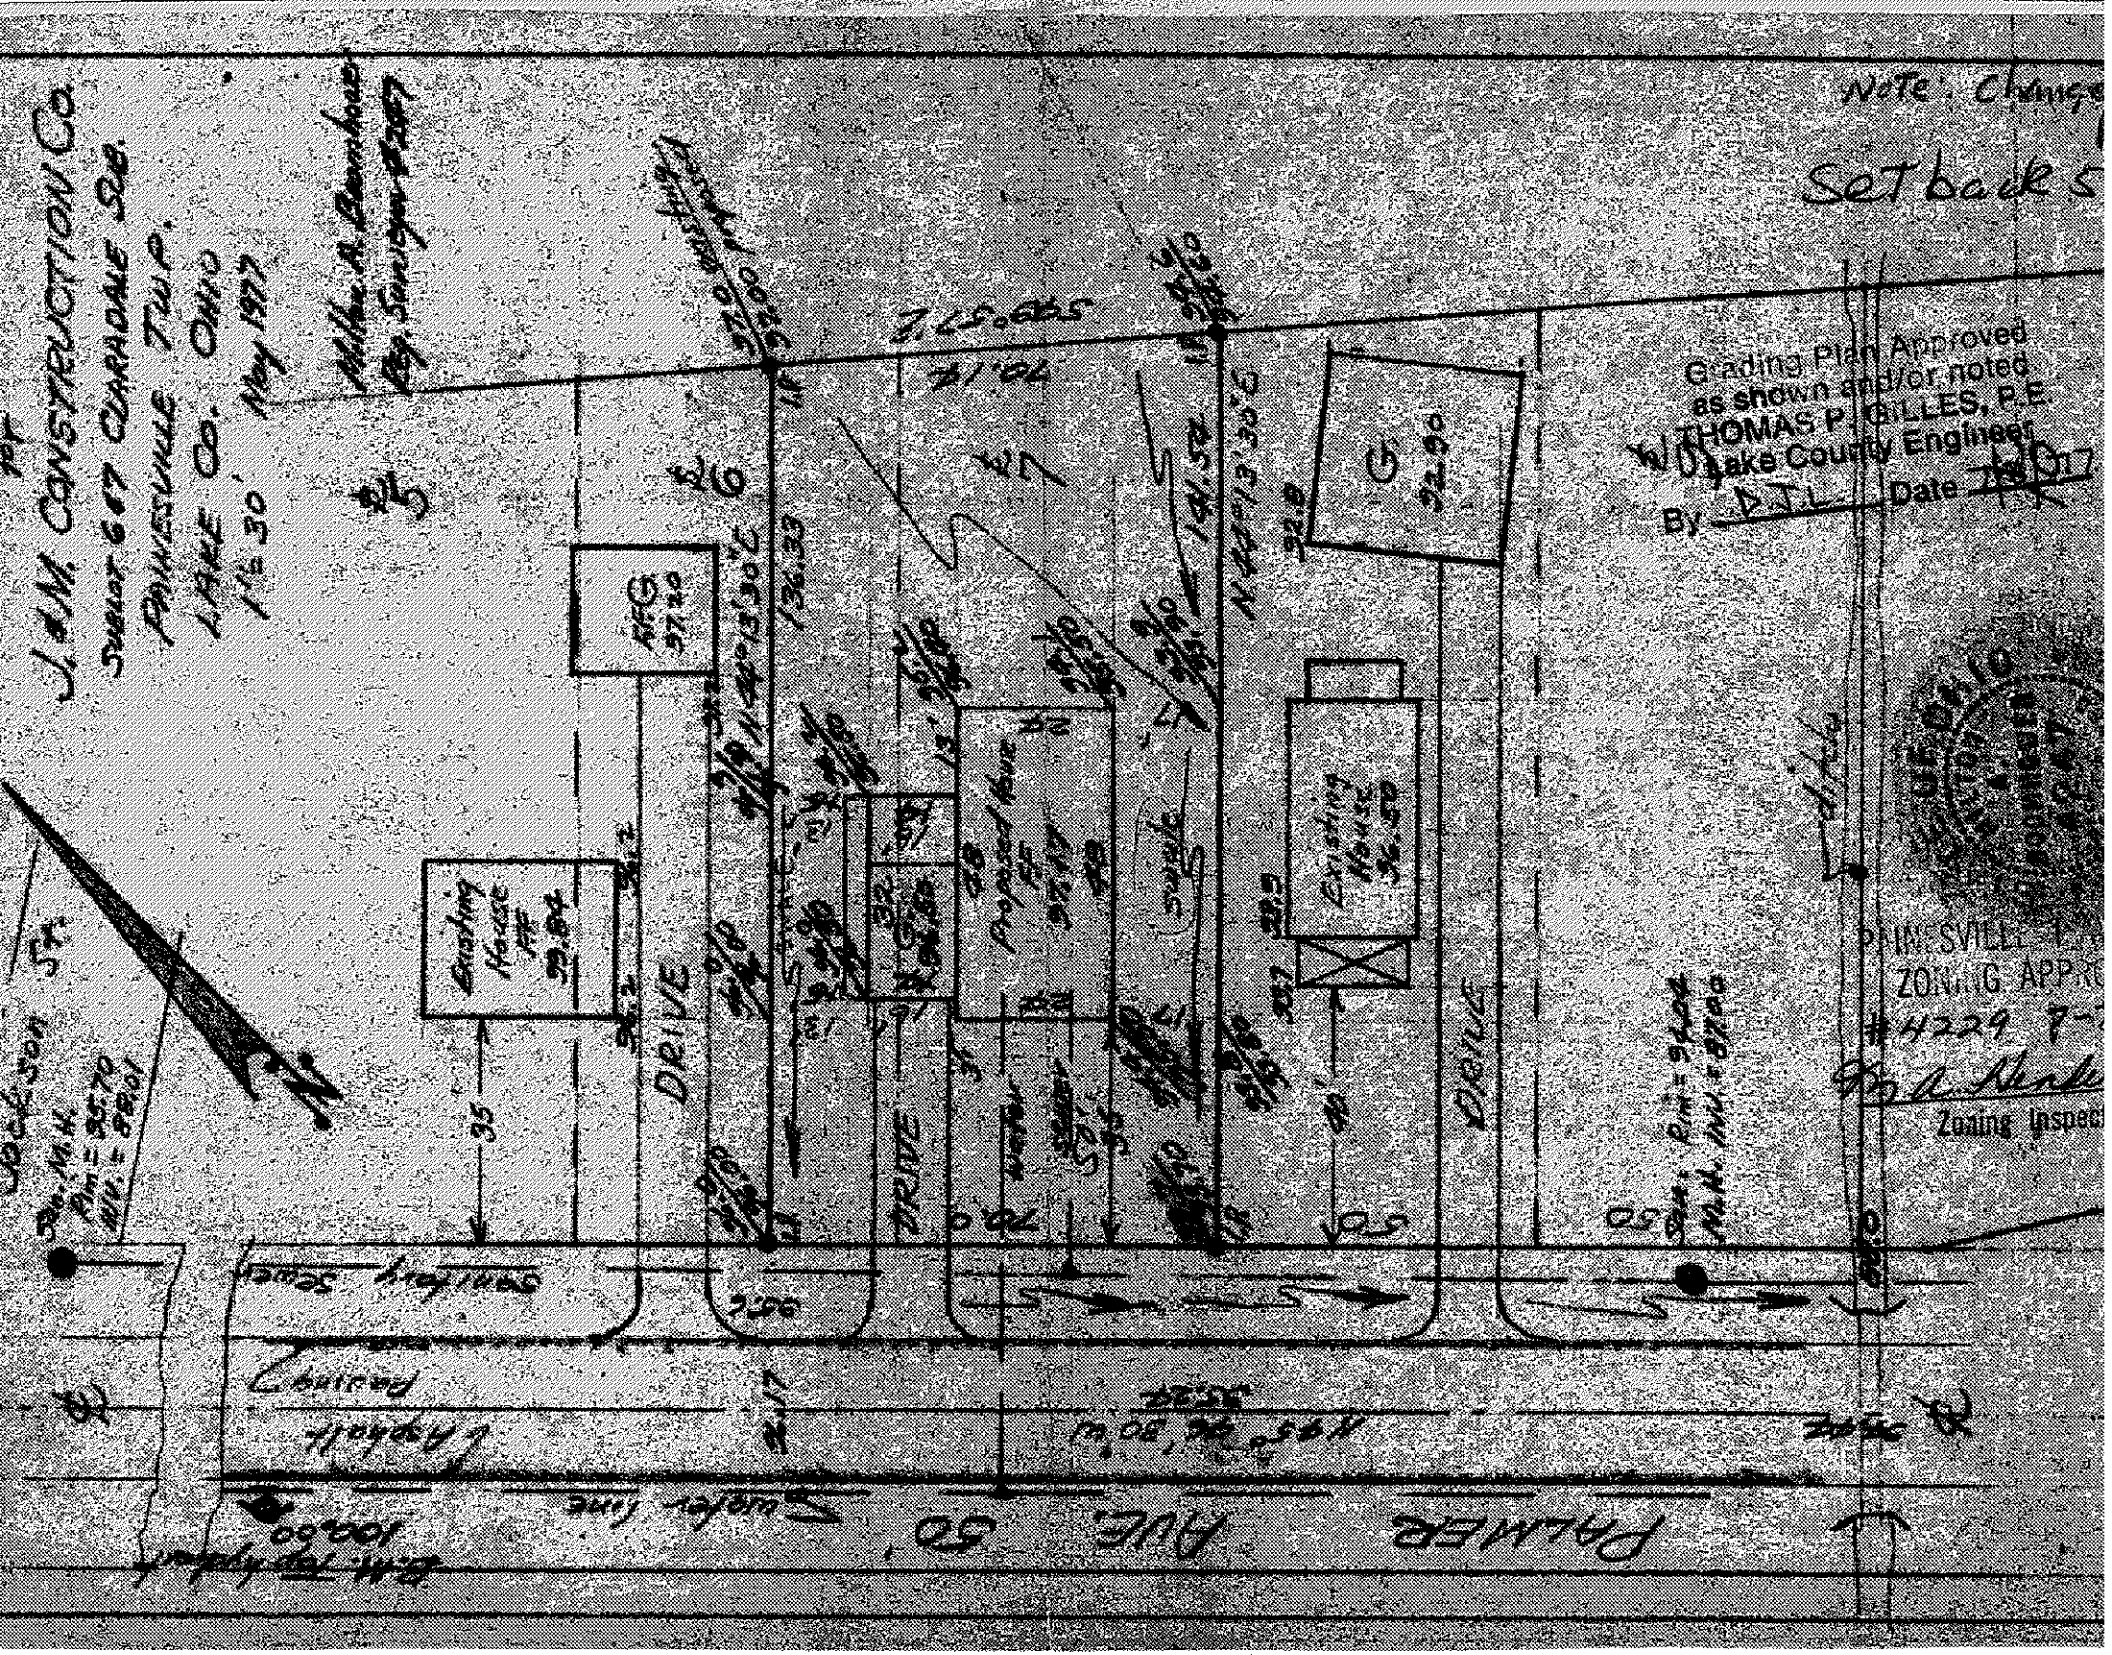

Note: Change
Setback 5
Grading Plan Approved
as shown and/or noted
THOMAS P. GILLES, P.E.
Lake County Engineer
By D.J.L. Date
PAINESVILLE
ZONING APPR
#4229
Zoning Inspect
J. & M. CONSTRUCTION Co.
SUBLOT 6 & 7 CLARADALE SUB.
PAINESVILLE TWP.
LAKE CO. OHIO
1" = 30'
May 1977
Existing House FF 99.84
Existing House 96.50
Proposed House FF 97.17
DRIVE
DRIVE
DRIVE
Sanitary Sewer
Asphalt Paving
Water line
PALMER AVE. 50'