PAINESVILLE TOWNSHIP
- ZONING APPROVED
3196 3-26-73
D. A. Henderson
Zoning Inspector

Grading Plan Approved
as shown and/or noted
THOMAS P. GILLES, P.E.
Lake County Engineer
By JWK Date 26 March 73

SITE PLAN

PAINESVILLE TOWNSHIP — LAKE COUNTY, OHIO

for TOM REED
CLIENT OWNER

ADDRESS STREET CITY ZIP

28 LOT 1 TRACT
VOLUME PAGE
PERM PARCEL # STREET

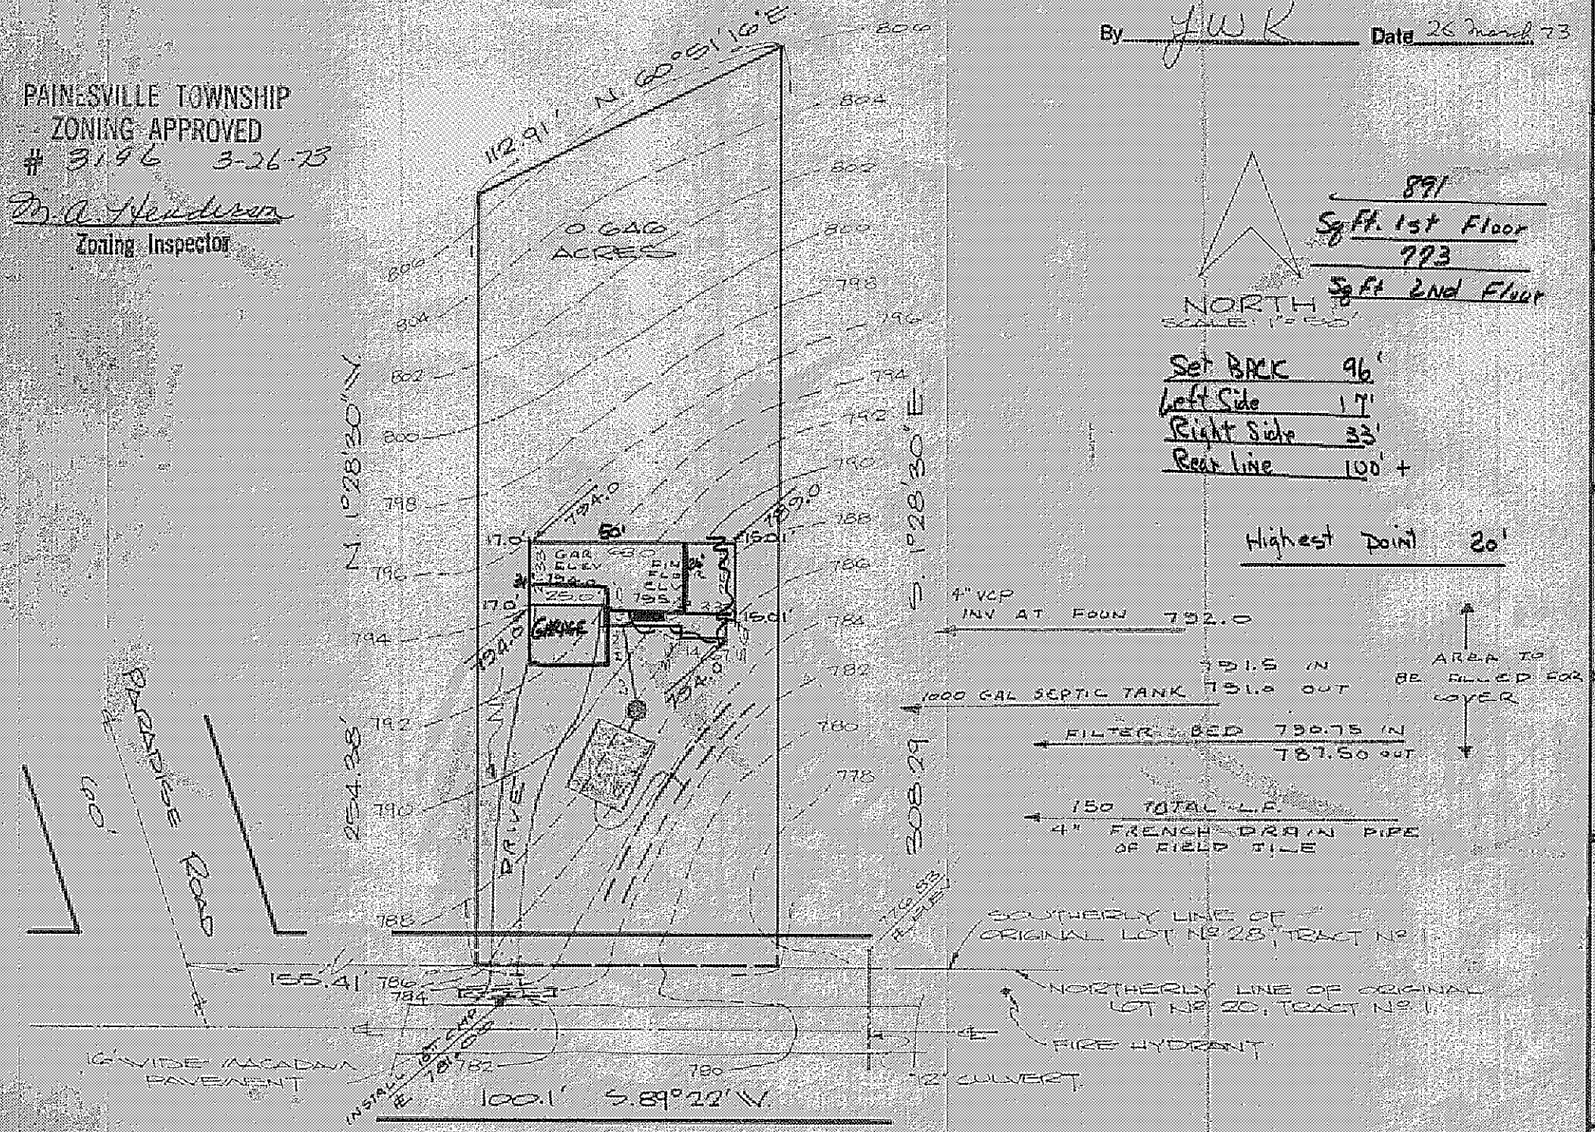

891 Sq Ft. 1st Floor
793 Sq Ft 2nd Floor

Set Back
Left Side 17'
Right Side 33'
Rear Line 100' +

Highest Point 20'

LEGEND

SANITARY MANHOLE
STORM MANHOLE
INLET OR CATCH BASIN
HYDRANT
EXISTING CONTOURS
PROPOSED CONTOURS
EXIST ELEV 1000
1000 - PROP ELEV
WATER VALVE (GAS)
WATER METER (GAS)
AS BUILT ELEVATION
DIRECTION OF SURFACE DRAINAGE

REMARKS

ALL BOUNDARY DATA SHOWN WAS OBTAINED FROM DEEDS RECORDED SUBDIVISION PLAT OR OTHER PUBLIC RECORDS.

DESIGN CERTIFICATION

THIS PLAT WAS PREPARED BY ME, AND IS CORRECT TO THE BEST OF MY KNOWLEDGE AND BELIEF

Richard L. Dick Pe. Nº 5244
NAME SURVEYOR REGISTRATION NO

CHECK LIST

DIMENSIONS
BEARINGS
TIE TO NEAREST STREET
SUBLOT NO PARCEL NO
SURROUNDING OWNERS
BLDG DIMENSIONS FIN GR
BLDG TIES FLR GRADES
APRON TYPE WIDTH THICKNESS
SIDEWALK TYPE WIDTH THICKNESS
CULVERT TYPE DIA LENGTH
WATER MAIN SIZE LOCATION
SAN SEWER SIZE % GR LOC
SAN MH CAST ELEV INV ELEV
SAN CONN SIZE LOC DEPTH
STORM SEWER SIZE % GR LOC
STORM MH CAST ELEV INV ELEV
PAVT TYPE GRADE CURBS
GAS LINE LOC SIZE PRESSURE
SEPTIC TANK SIZE LOC
WELL LOCATION

"AS BUILT" CERTIFICATION

I HEREBY CERTIFY THAT THE CIRCLED GRADES ARE EXISTING FINISH GRADES CHECKED IN FIELD ON _____ 19__ BY _____ SURVEYING AND ARE CORRECT TO THE BEST OF MY KNOWLEDGE AND BELIEF

REGISTERED SURVEYOR REG. NO

REVISIONS		
NO	DATE	BY
1		
2		
3		
4		
5		

PLAN PREPARED BY:
DEBEVEC-SALO & ASSOC, INC.
NAME
130 EAST JACKSON ST, PAINESVILLE
ADDRESS

DRAWN BY AG	SCALE 1"=50'	PHONE NO
CHK'D RLD	DATE 2/15/73	DRAWING NO 3732
CREW CHIEF	APP'D	