Grading Plan Approved
as shown and/or noted
THOMAS P. GILLES, P.E.
Lake County Engineer

By J W K Date 28 Nov 1978

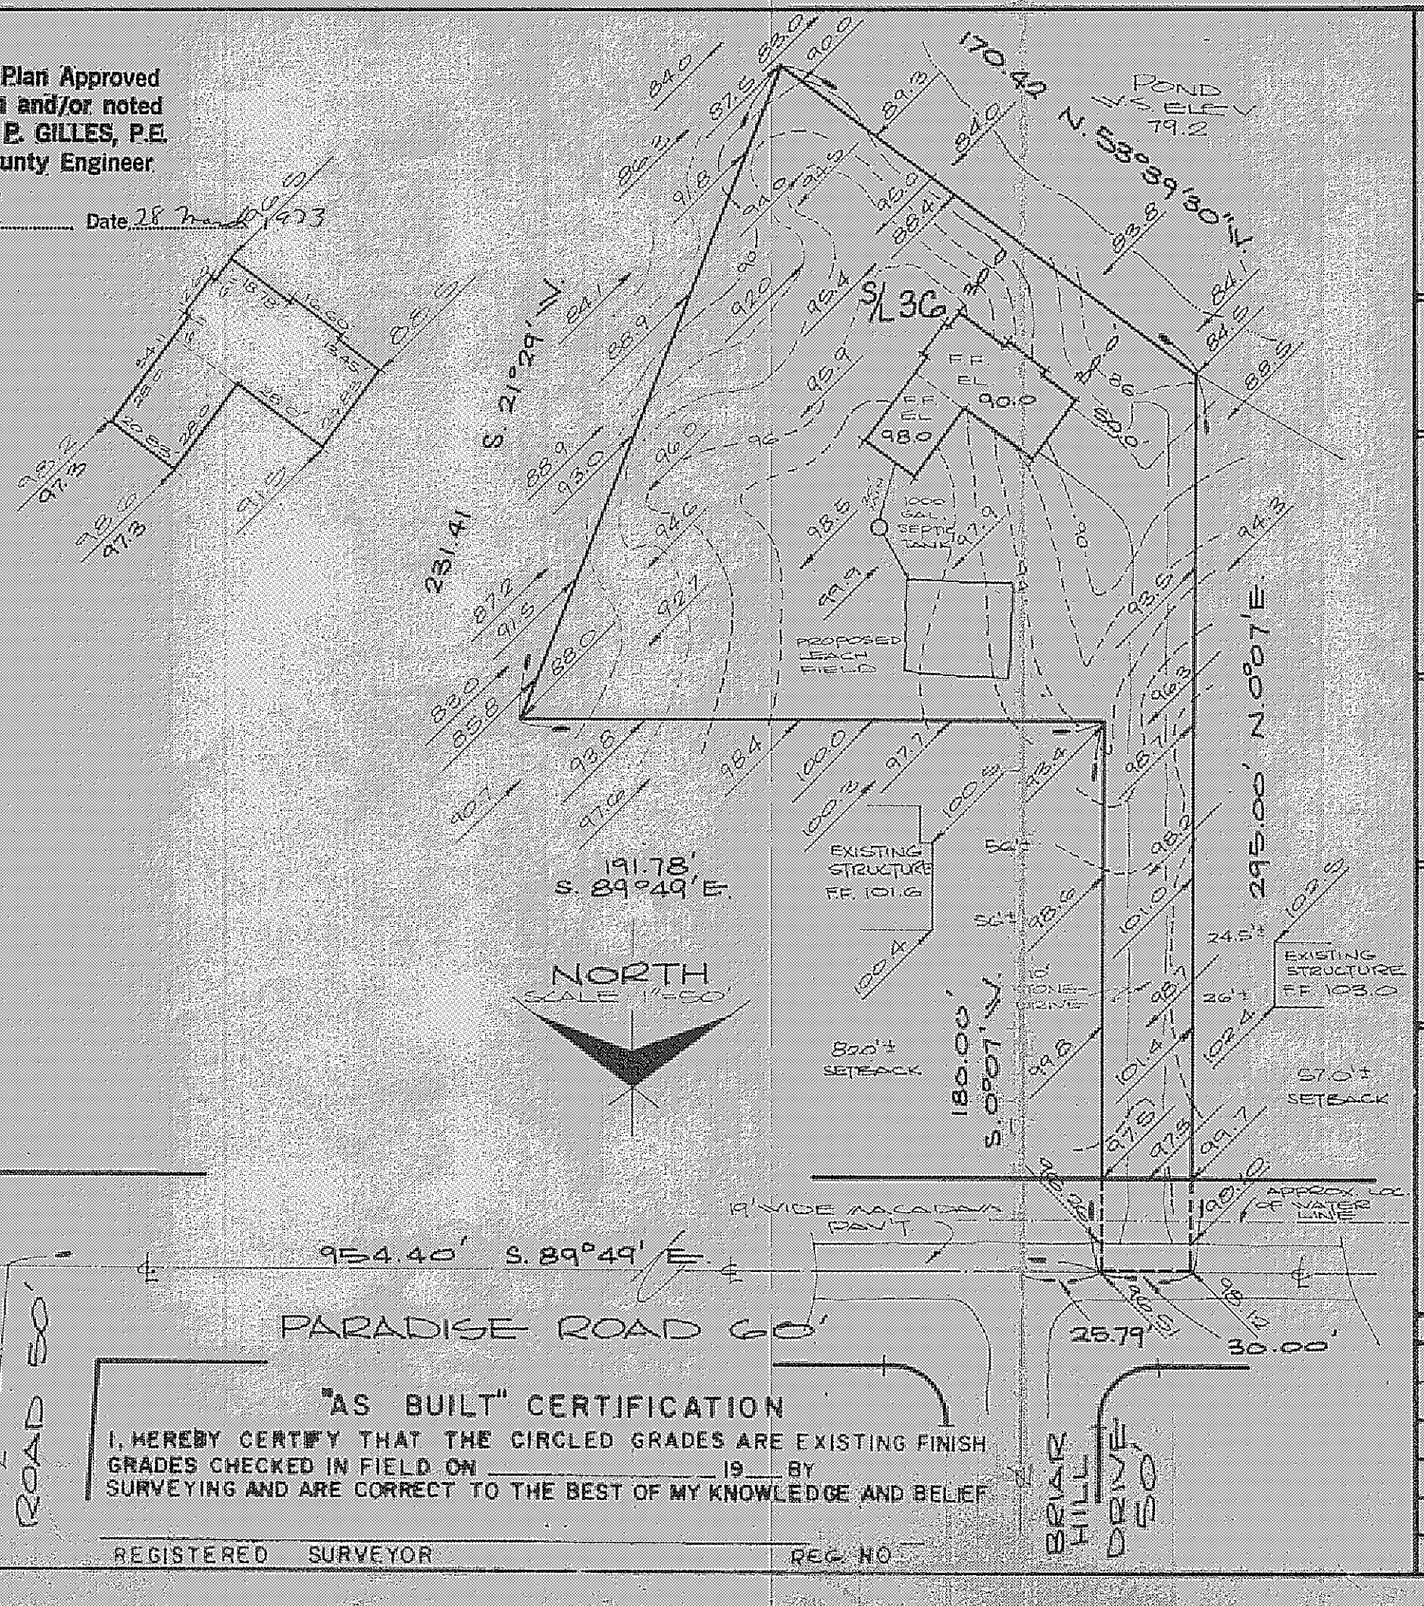

SITE PLAN

PAINESVILLE TOWNSHIP — LAKE COUNTY, OHIO

for: GENE & SUSAN DOMINISH (CLIENT / OWNER)

509 MEIGS RD. (ADDRESS) GRAND RIVER (STREET) (CITY) (ZIP)

TWIN LAKES ESTATES (SUBDIVISION NAME) J-82 (VOL - PG)

S/L 36 (SUBLOT NO.) PARADISE RD. (STREET)

LOT / TRACT

VOLUME / PAGE

PERM PARCEL # / STREET

LEGEND

- SANITARY MANHOLE
- STORM MANHOLE
- INLET OR CATCH BASIN
- HYDRANT
- EXISTING CONTOURS
- PROPOSED CONTOURS
- EXIST. ELEV. 100.0
- 100.0 PROP ELEV.
- WATER VALVE (GAS)
- WATER METER (GAS)
- AS BUILT ELEVATION 100.0
- INDICATES DIRECTION OF SURFACE DRAINAGE

REMARKS

ALL BOUNDARY DATA SHOWN WAS OBTAINED FROM (DEEDS, RECORDED SUBDIVISION PLAT, OR OTHER PUBLIC RECORDS)

DESIGN CERTIFICATION

THIS PLAT WAS PREPARED BY ME, AND IS CORRECT TO THE BEST OF MY KNOWLEDGE AND BELIEF.

Richard Meeks P.S. No. 5244

NAME SURVEYOR REGISTRATION NO.

CHECK LIST

- DIMENSIONS
- BEARINGS
- TIE TO NEAREST STREET
- SUBLOT NO. PARCEL NO.
- SURROUNDING OWNERS
- BLDG DIMENSIONS FIN GR
- BLDG TIES FLR GRADES
- APRON TYPE WIDTH THICKNESS
- SIDEWALK TYPE WIDTH THICKNESS
- CULVERT TYPE DIA LENGTH
- WATER MAIN SIZE LOCATION
- SAN SEWER SIZE % GR LOC.
- SAN MH CAST ELEV. INV ELEV
- SAN. CONN SIZE LOC DEPTH
- STORM SEWER SIZE % GR LOC
- STORM MH CAST ELEV. INV ELEV.
- PAVT TYPE GRADE CURBS
- GAS LINE LOC SIZE PRESSURE
- SEPTIC TANK SIZE LOC
- WELL LOCATION

"AS BUILT" CERTIFICATION

I, HEREBY CERTIFY THAT THE CIRCLED GRADES ARE EXISTING FINISH GRADES CHECKED IN FIELD ON _____ 19__ BY SURVEYING AND ARE CORRECT TO THE BEST OF MY KNOWLEDGE AND BELIEF.

REGISTERED SURVEYOR REG. NO.

REVISIONS		
NO	DATE	BY
1		
2		
3		
4		
5		

PLAN PREPARED BY:

DEBEVEC-SALO & ASSOC., INC. (NAME)

130 EAST JACKSON ST. PAINESVILLE (ADDRESS)

DRAWN BY AG	SCALE	PHONE NO.
CHK'D	DATE 1-19-78	DRAWING NO. 3823
CREW CHIEF	APP'D	