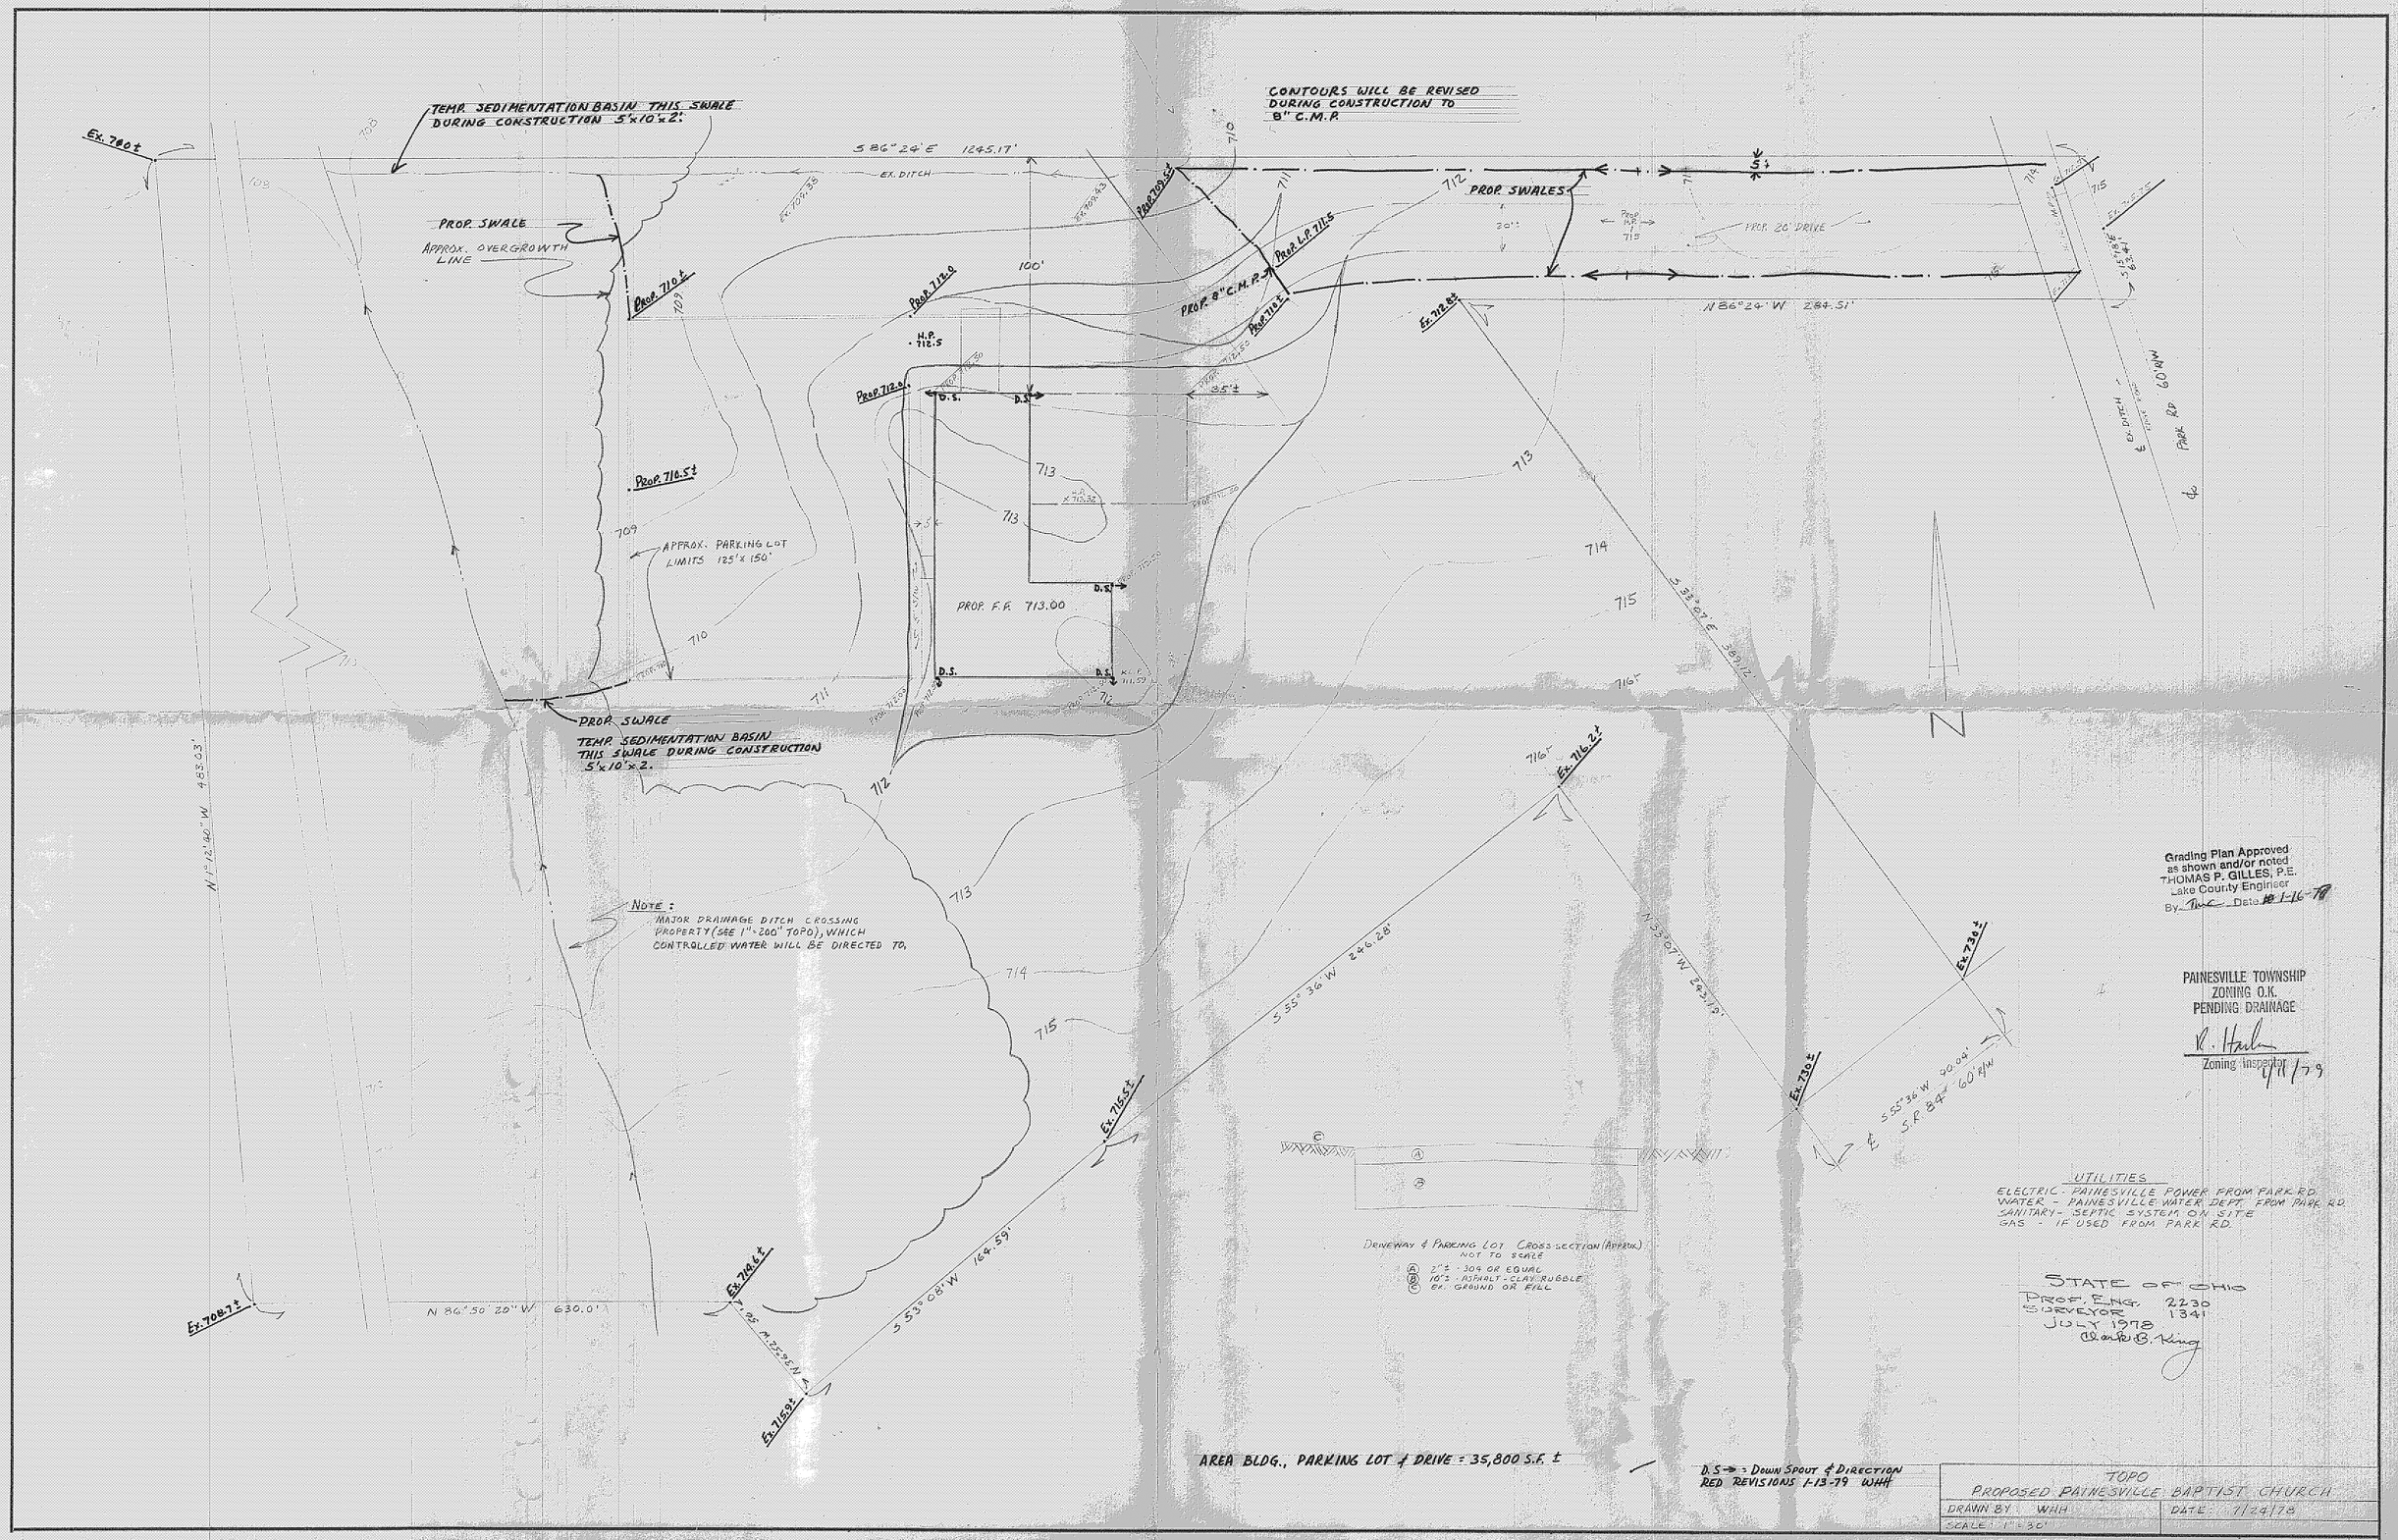

TEMP. SEDIMENTATION BASIN THIS SWALE DURING CONSTRUCTION 5'x10'x2'.
CONTOURS WILL BE REVISED DURING CONSTRUCTION TO 8" C.M.P.
Ex. 700±
S 86°24' E 1245.17'
EX. DITCH
PROP. SWALE
APPROX. OVERGROWTH LINE
PROP. SWALES
PROP. 20' DRIVE
PROP. 8" C.M.P.
N 86°24' W 284.51'
PROP. 710±
PROP. 712.0
PROP. 710.5±
PROP. 712.0
PROP. 709.5±
PROP. L.P. 711.5
PROP. 710±
Ex. 712.8±
H.P. 712.5
D.S.
APPROX. PARKING LOT LIMITS 125'x150'
PROP. F.F. 713.00
PROP. SWALE
TEMP. SEDIMENTATION BASIN THIS SWALE DURING CONSTRUCTION 5'x10'x2.
N 1°12'40" W 483.03'
NOTE: MAJOR DRAINAGE DITCH CROSSING PROPERTY (SEE 1"=200' TOPO), WHICH CONTROLLED WATER WILL BE DIRECTED TO.
Ex. 716.2±
S 55°36' W 246.28'
N 33°07' W 243.19'
Ex. 730±
Ex. 730±
S 55°36' W 90.04'
S.R. 84 60' R/W
Ex. 715.5±
S 53°08' W 164.59'
Ex. 714.6±
Ex. 708.7±
N 86°50'20" W 630.0'
Ex. 715.9±
N 33°52' W 25.95'
S 33°07' E 389.12'
PARK RD 60' R/W
℄ EX. DITCH
N
Grading Plan Approved as shown and/or noted THOMAS P. GILLES, P.E. Lake County Engineer By Date 1-16-78
PAINESVILLE TOWNSHIP ZONING O.K. PENDING DRAINAGE
Zoning Inspector 1/11/79
UTILITIES
ELECTRIC - PAINESVILLE POWER FROM PARK RD.
WATER - PAINESVILLE WATER DEPT. FROM PARK RD.
SANITARY - SEPTIC SYSTEM ON SITE
GAS - IF USED FROM PARK RD.
DRIVEWAY & PARKING LOT CROSS-SECTION (APPROX.) NOT TO SCALE
(A) 2"± - 304 OR EQUAL
(B) 10"± - ASPHALT - CLAY RUBBLE
(C) EX. GROUND OR FILL
STATE OF OHIO
PROF. ENG. 2230
SURVEYOR 1341
JULY 1978
Clark B. King
AREA BLDG., PARKING LOT & DRIVE = 35,800 S.F. ±
D.S. → = DOWN SPOUT & DIRECTION
RED REVISIONS 1-13-79 WHH
TOPO
PROPOSED PAINESVILLE BAPTIST CHURCH
DRAWN BY WHH
DATE 7/24/78
SCALE 1"=30'