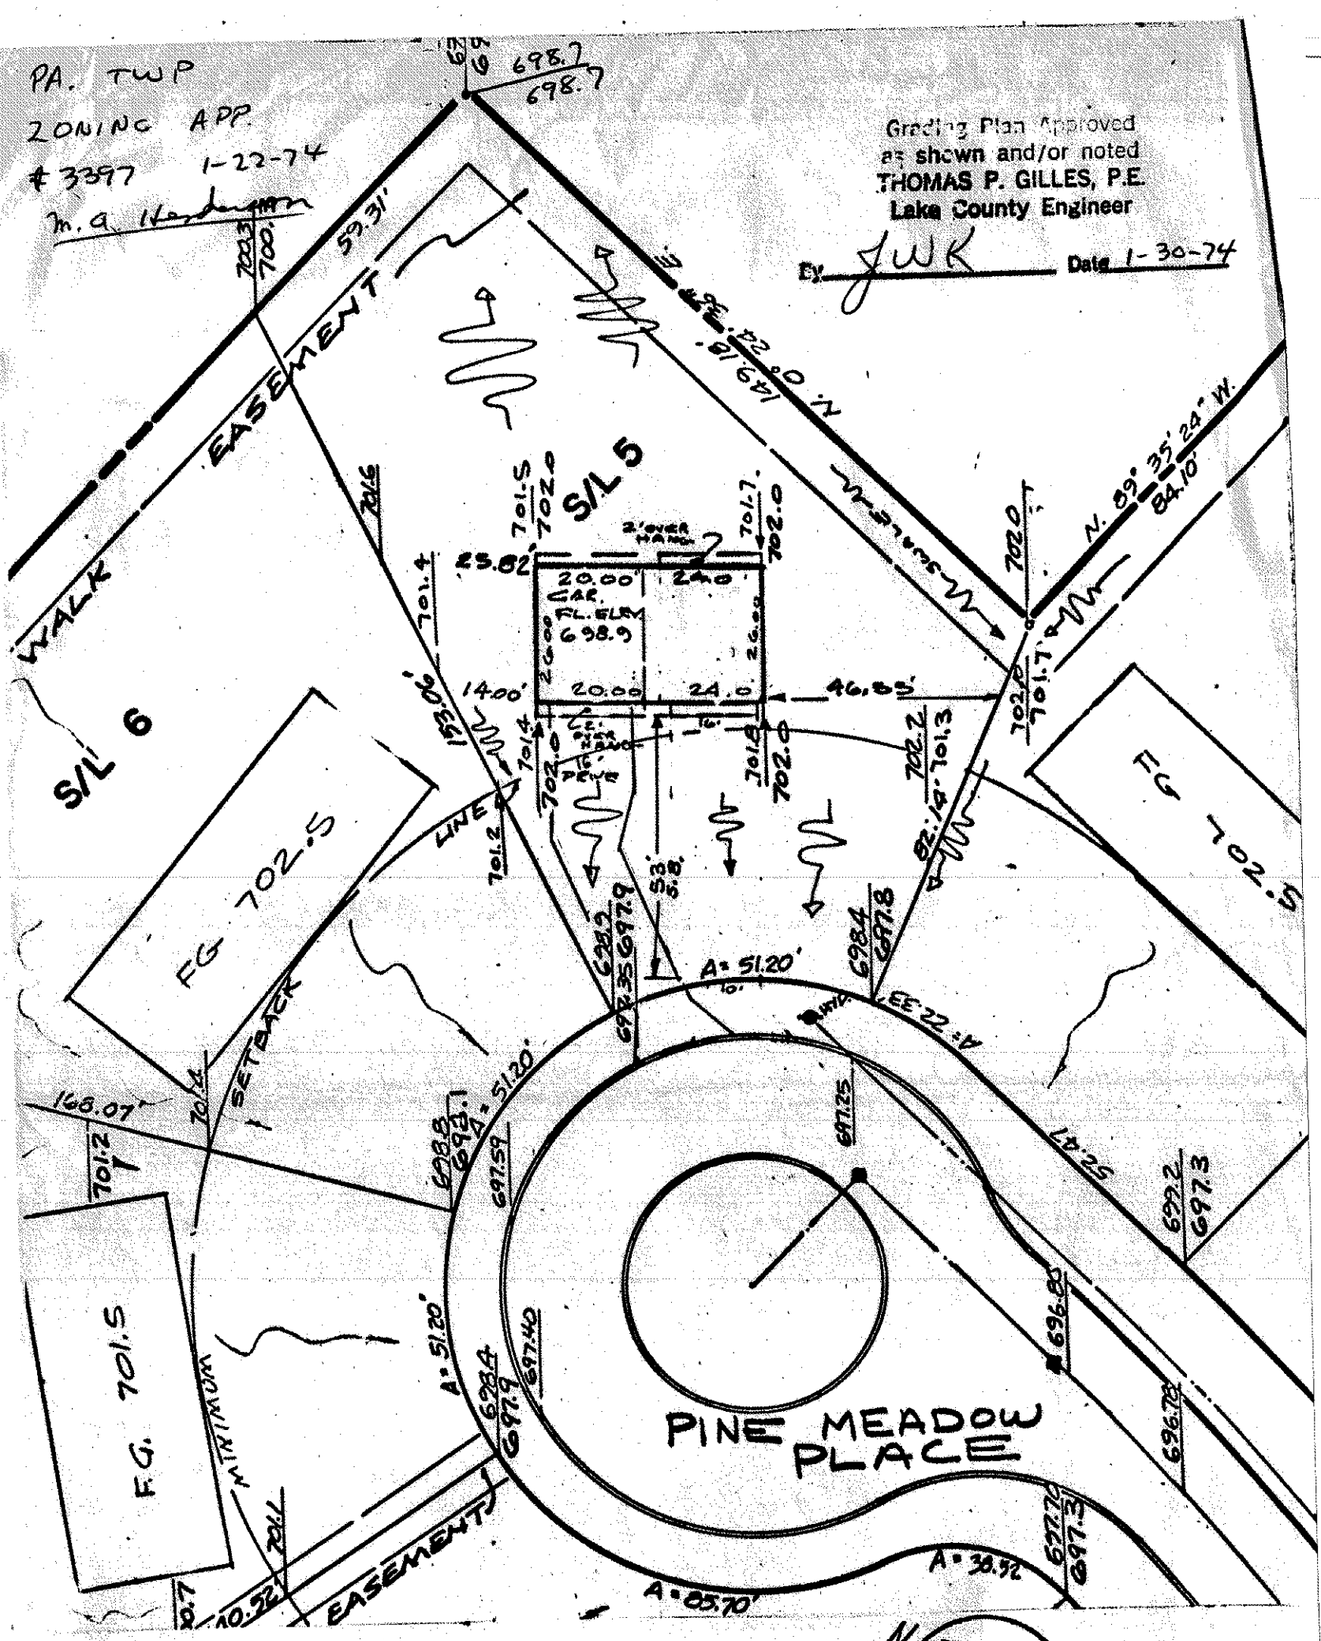

SITE PLAN for B.S.M. Inc.

of S/L 5 in the FOXFIRE TRAILS, a subdivision recorded in Vol. S, Pg. 7, of Lake County Deed Records.
Situated in Painesville Township
Lake County, Ohio

5 S/L — PINE MEADOW PLACE STREET

This plat was prepared by me and is correct to the best of my knowledge and belief.

Richard J. Bilski #5244
Reg. No.

Jan 29, 1974

EXISTING ELEV 100.0 / 100.0 PROPOSED ELEVATION

INDICATES DIRECTION OF SURFACE DRAINAGE