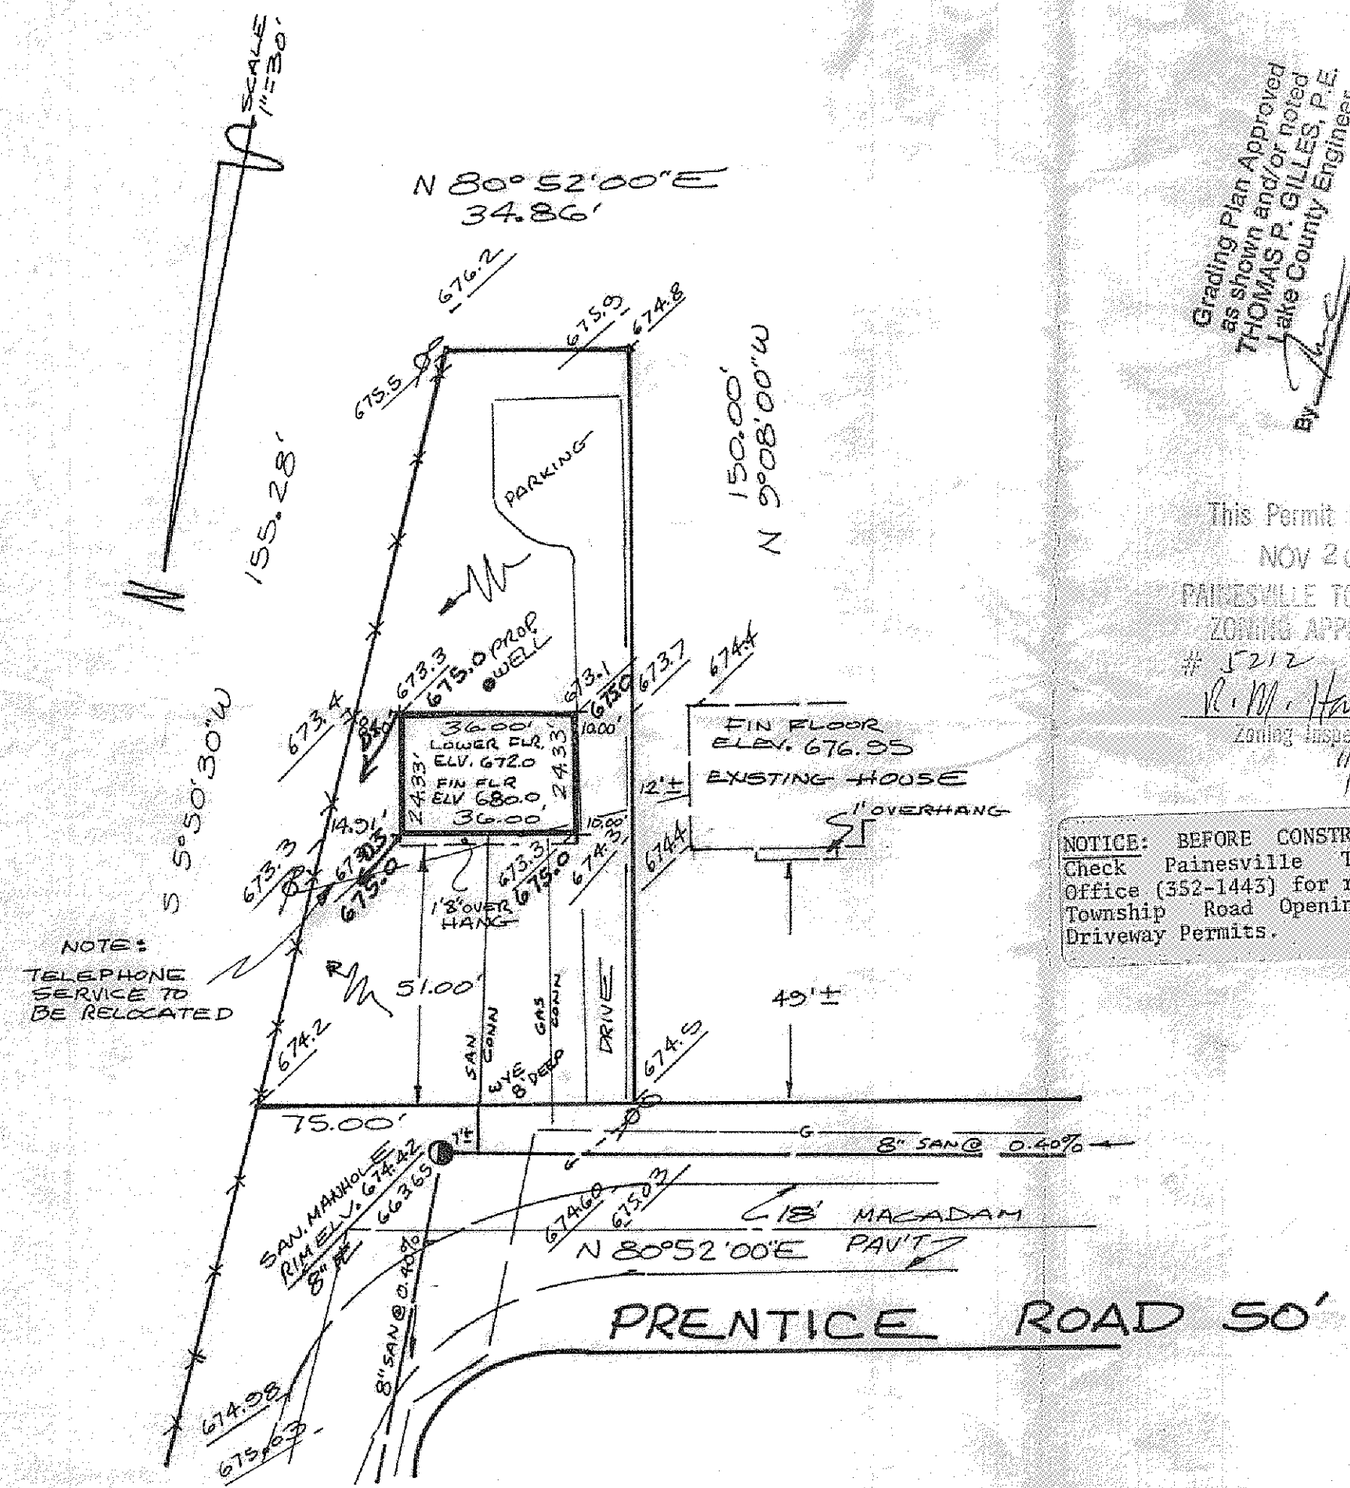


Grading Plan Approved as shown and/or noted
THOMAS P. GILLES, P.E.
Lake County Engineer
By [signature] Date 12-4-80

This Permit Expires
NOV 20 1981
PAINESVILLE TOWNSHIP
ZONING APPROVED
# 5212
R. M. Hach
Zoning Inspector
11/20/80

NOTICE: BEFORE CONSTRUCTION, Check Painesville Township Office (352-1443) for required Township Road Opening and Driveway Permits.

# SITE PLAN

for BILL DAWSON
CLIENT OWNER

6333 DAWSON BLVD. MENTOR, OHIO
ADDRESS STREET CITY

23 PRENTICE REYNOLDS SUBD J - 66
SUBLOT NO. SUBDIVISION NAME VOL. PAGE

X PAINESVILLE TOWNSHIP, OHIO
LOT, TRACT

## REMARKS

ALL BOUNDARY DATA SHOWN WAS OBTAINED FROM (DEEDS, RECORDED SUBDIVISION PLAT OR OTHER PUBLIC RECORDS). LOCATIONS AS SHOWN OF ADJACENT WELLS AND SEPTIC TANKS OBTAINED FROM LAKE COUNTY HEALTH DEPARTMENT.

## LEGEND

SANITARY MANHOLE
PROPOSED CONTOURS
EXIST. ELEV. → 100.0
100.0 ← PROP. ELEV.
WATER VALVE (GAS)
DIRECTION OF SURFACE DRAINAGE

## CHECK LIST

NO. OF BEDROOMS
DIMENSIONS
BEARINGS
TIE TO NEAREST STREET
SUBLOT NO. PARCEL NO.
SURROUNDING OWNERS
BLDG. DIMENSIONS FIN. GR.
BLDG. TIES FL'R. GRADES
APRON TYPE WIDTH THICKNESS
SIDEWALK TYPE WIDTH THICKNESS
CULVERT TYPE DIA., LENGTH
ROCK OUTCROPPINGS
WATER MAIN SIZE, LOCATION
SAN. SEWER SIZE % GR. LOC.
SAN. MH. CAST. ELEV. IN. ELEV.
SAN. CONN. SIZE, LOC. DEPTH
STORM SEWER SIZE % GR. LOC.
STORM MH. CAST ELEV. INV. ELEV.
PAV'T TYPE GRADE CURBS
GAS LINE LOC. SIZE PRESSURE
SEPTIC TANK LOCATION & DUPLICATION AREA
WELL LOCATION
ISOLATION RADIUS FROM WELL

## DESIGN CERTIFICATION

THIS PLAT WAS PREPARED BY ME, AND IS CORRECT TO THE BEST OF MY KNOWLEDGE AND BELIEF.

[signature] PS#5244
NAME SURVEYOR REGISTRATION NO.

## "AS BUILT" CERTIFICATION

I HEREBY CERTIFY THAT THE CIRCLED GRADES ARE EXISTING GRADES OBTAINED ON THE SITE ON _____ 19____ AND ARE CORRECT TO THE BEST OF MY ACKNOWLEDGMENT AND BELIEF.

LAND DESIGN consultants, inc.
9613 JACKSON STREET MENTOR OHIO 44060
TELEPHONE (216) 951-6872 or 354-6646

| | | | | | |
|---|---|---|---|---|---|
| 1 | | | DRAWN BY [initials] | SCALE 1"=30' | DRAWING NO. |
| 2 | | | CHK'D. | DATE 11.18.80 | 389-23 |
| 3 | | | CREW CHIEF EWH | APP'D. | |