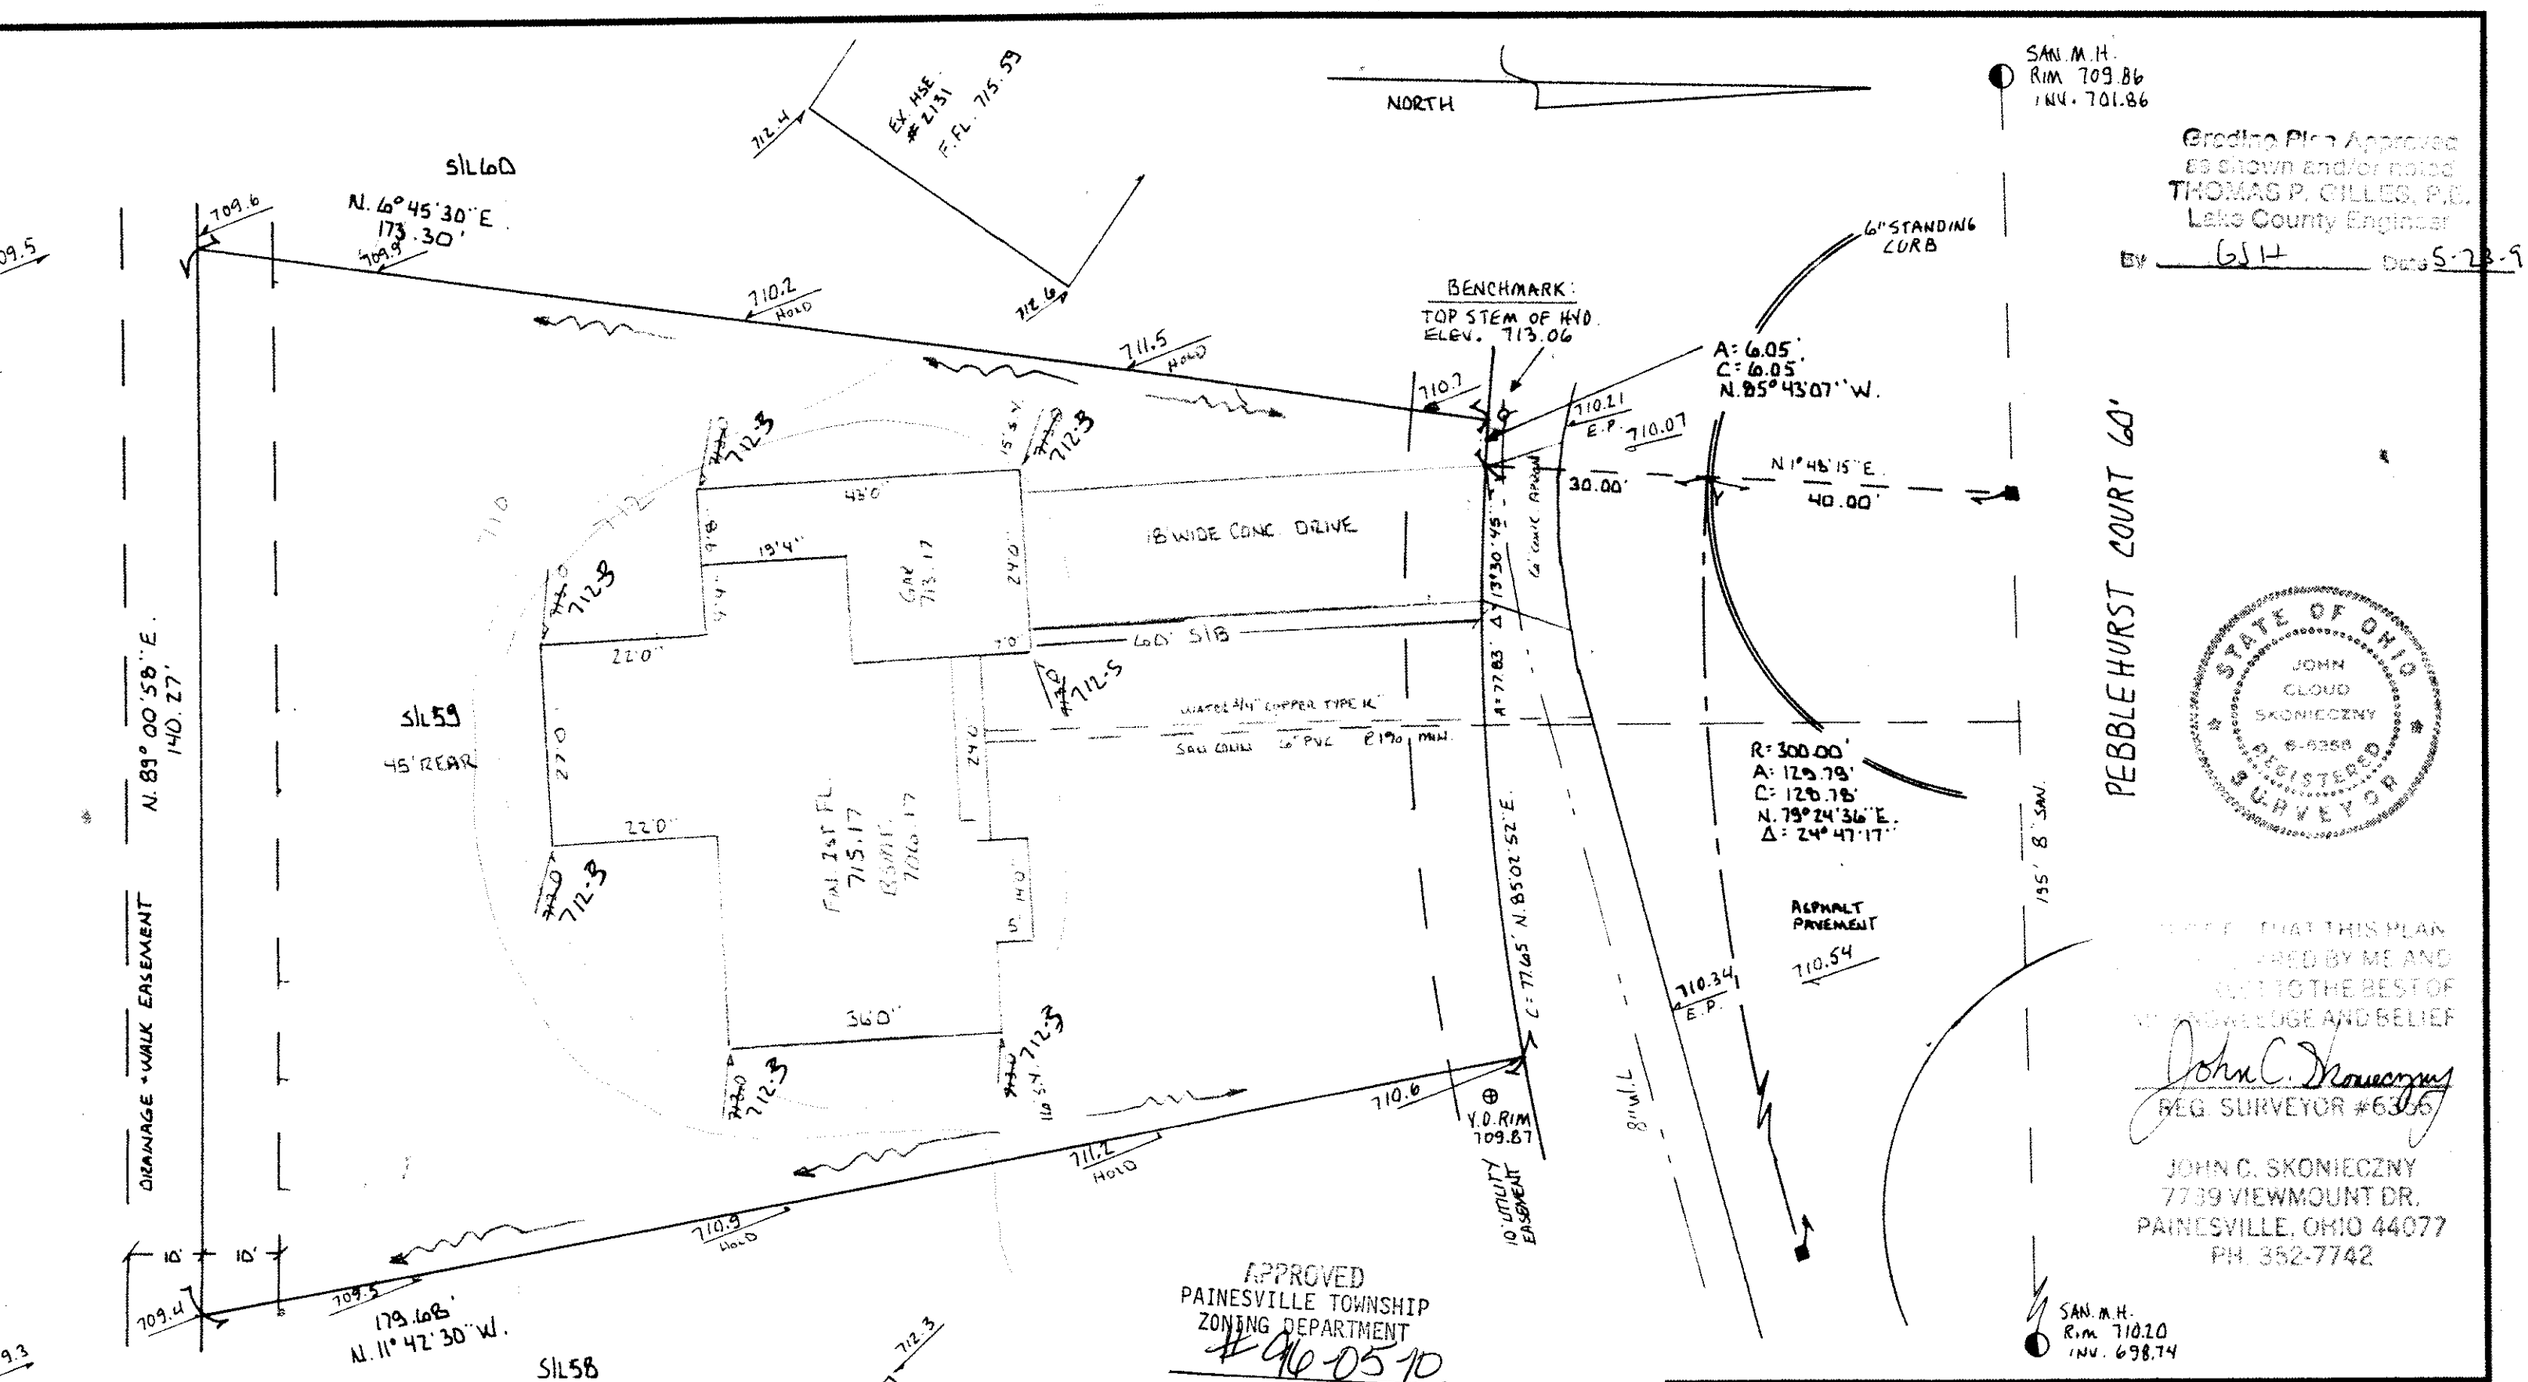

Grading Plan Approved as shown and/or noted
THOMAS P. GILLES, P.E.
Lake County Engineer
BY GJH DATE 5-23-96

STATE OF OHIO
JOHN CLOUD SKONIECZNY
S-6358
REGISTERED SURVEYOR

I HEREBY CERTIFY THAT THIS PLAN WAS PREPARED BY ME AND IS CORRECT TO THE BEST OF MY KNOWLEDGE AND BELIEF

John C. Skonieczny
REG. SURVEYOR #6358

JOHN C. SKONIECZNY
7739 VIEWMOUNT DR.
PAINESVILLE, OHIO 44077
PH. 352-7742

APPROVED
PAINESVILLE TOWNSHIP
ZONING DEPARTMENT
#96-05-10
D. Rust

2 WORKING DAYS BEFORE YOU DIG
CALL TOLL FREE 800-362-2764
OHIO UTILITIES PROTECTION SERVICE

SITE PLAN FOR:
ARTISTIC CONST. 255-4270 9281 LORI JEAN DR. MENTOR, OHIO 44060

SCALE: 1" = 20'	APPROVED BY:	DRAWN BY FJH
DATE: APR 96		REVISED

BEING SUBLOT 59 IN THE KINGSBOROUGH SUBDIVISION No. 2
TOWNSHIP OF PAINESVILLE - LAKE COUNTY - OHIO

JOB # 96-2217

DRAWING NUMBER 96-1450

2 X 18 PRINTED ON NO. 1000N CLEARPRINT ®