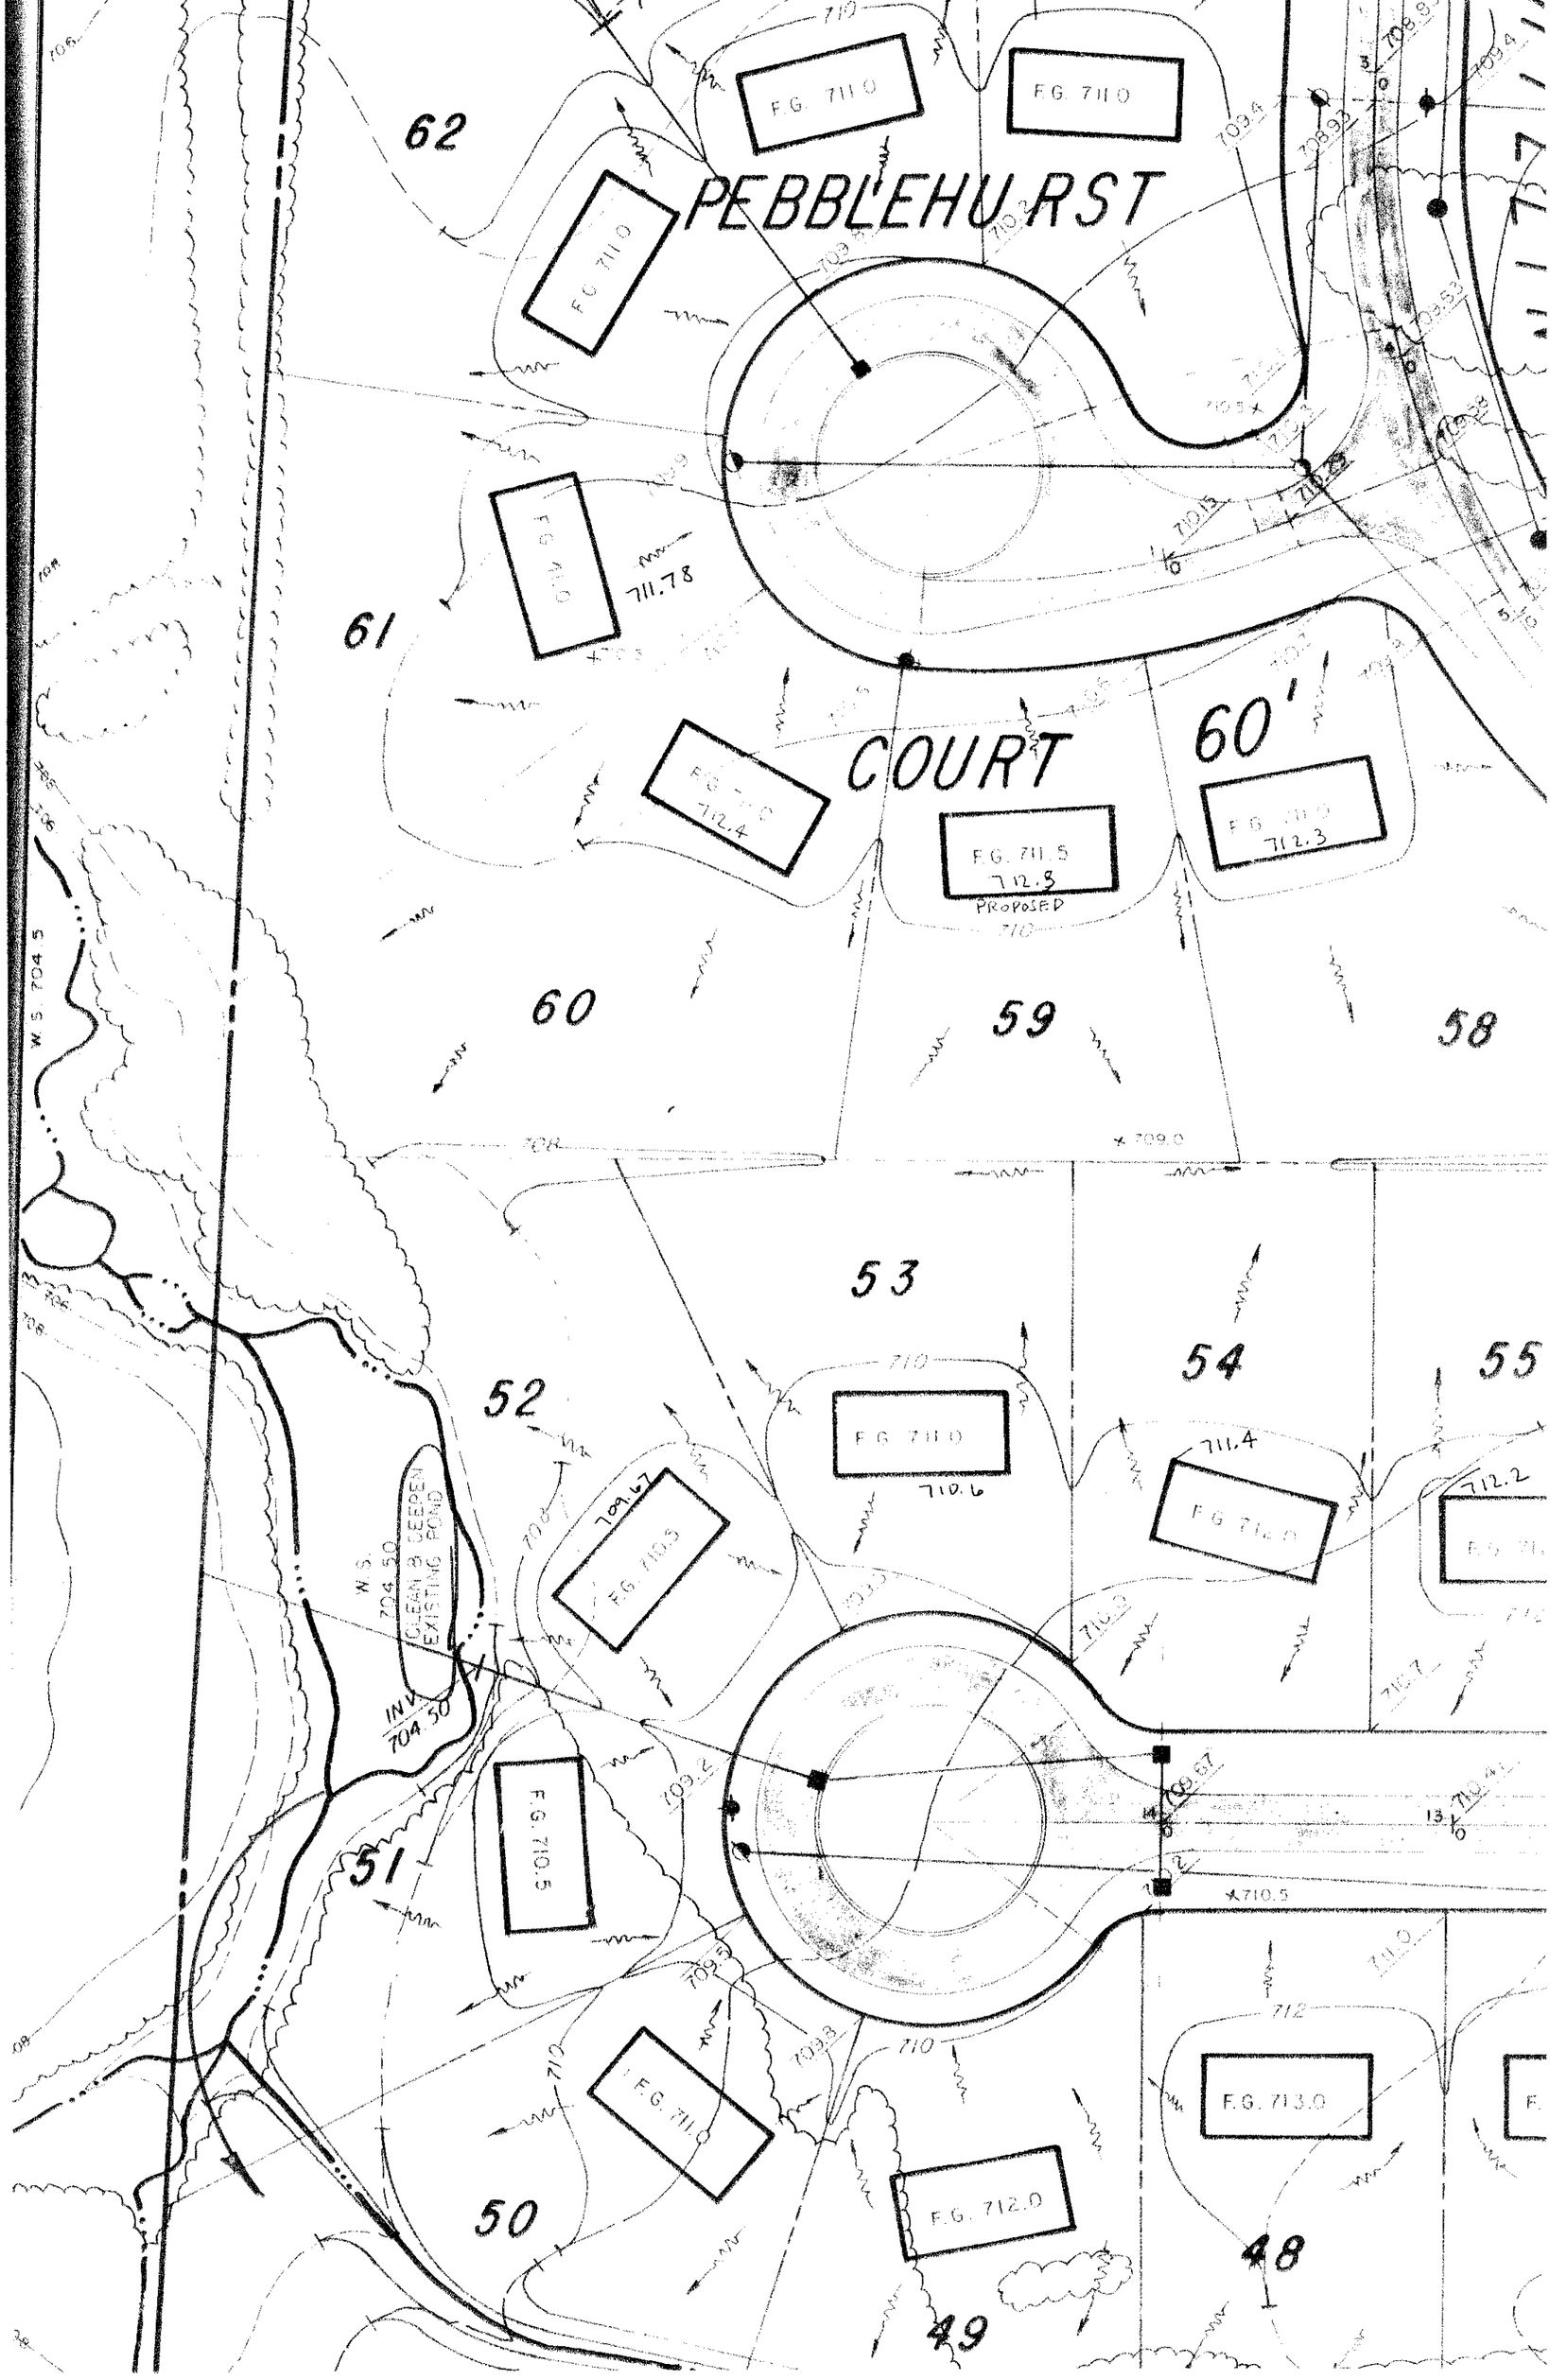
PEBBLEHURST
COURT
62
61
60
59
58
60'
53
54
55
52
51
50
49
48
F.G. 711.0
F.G. 711.0
F.G. 711.0
F.G. 711.0
711.78
F.G. 712.4
F.G. 711.5
712.3
PROPOSED
F.G. 712.3
W.S. 704.5
W.S. 704.50
CLEAN & DEEPEN EXISTING POND
INV. 704.50
709.67
F.G. 710.5
F.G. 710.6
711.4
F.G. 712.0
712.2
F.G. 710.5
F.G. 711.0
F.G. 712.0
F.G. 713.0