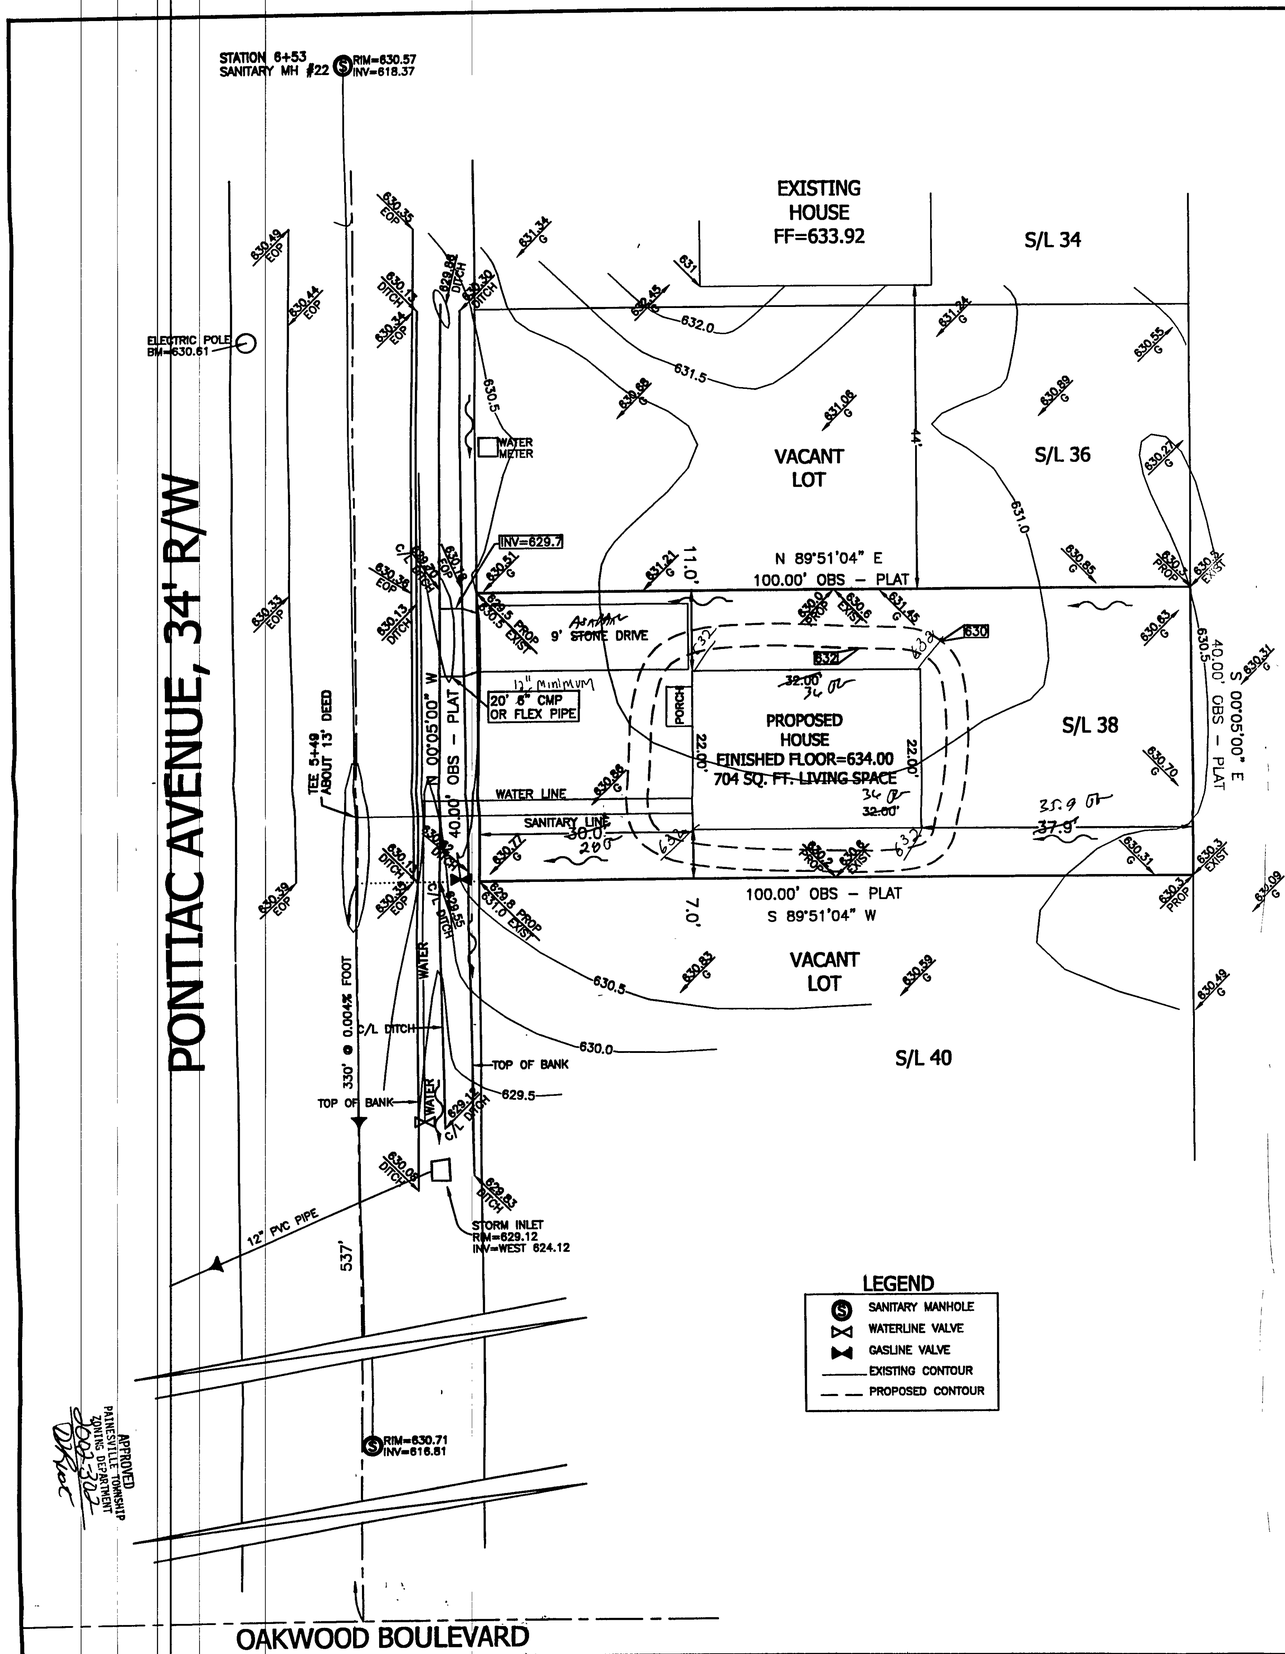

SITE PLAN OF LANDS

ALL THAT CERTAIN LANDS SITUATE IN SUBLOT NUMBER 38, BLOCK 5, PAINESVILLE ON THE LAKE ALLOTMENT, AS RECORDED IN PLAT VOLUME D, PAGE 13, PAINESVILLE TOWNSHIP, COUNTY OF LAKE, STATE OF OHIO. A SITE PLAN OF THE LANDS TO SHANNON MANGANO AS RECORDED IN DOCUMENT 20024690 IN THE OFFICE OF THE COUNTY RECORDER.

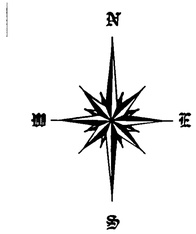

BASUS OF BEARINGS ARE TO AN ASSUMED MERIDIAN ALONG THE EAST LINE OF PONTIAC AVENUE NORTH 00°-05'-00" WEST

10' 0' 10' 20'

SCALE: 1" = 10'

Grading Plan Approved as shown and/or noted
JAMES R. GILLS, P.E.
Lake County Engineer
By GJH Date 8.12.02
12" Minimum culvert
Finished Grade 632.00

DATE OF ORIGINAL: JULY 13, 2002
REVISION: LOCATION OF HOUSE DATE: JULY 26, 2002
REVISION: DATE: , 2002

THIS SURVEY WAS PERFORMED TO AN ACCURACY AS SET FORTH IN THE 1999 OHIO ADMINISTRATIVE CODE 4733-37.

STATE OF OHIO
TIMOTHY E. STOCKER
No. 7245
REGISTERED PROFESSIONAL SURVEYOR

7-26-02

TIMOTHY E. STOCKER, P.S. 7245

APPROVED
PAINESVILLE TOWNSHIP
ZONING DEPARTMENT
2002-302

CHK: T. STOCKER
DRN: S. LOVEJOY
REV:
PAGE 1 OF 1

PROJECT ADDRESS:
V/L PONTIAC AVENUE, PAINESVILLE TWP., OHIO

JOB NUMBER: 3108

PROJECT NAME:
SITE PLAN OF LANDS

PROJECT LOCATION:
LAKE COUNTY, OHIO

PREPARED FOR:
SHANNON MANGANO

FOR INQUIRIES CONCERNING THIS SURVEY CONTACT:

U.S. SURVEYOR
CRABBS' SURVEYING SERVICE
10 WEST ERIE STREET, SUITE 101
PAINESVILLE, OH 44077
1-800-488-3968