SITE PLAN
FOR
TOM REED

BEING S/L 16 IN THE PAINESVILLE-ON-THE-LAKE
SUB'D IN P'VILLE TWP., LAKE COUNTY, OHIO.

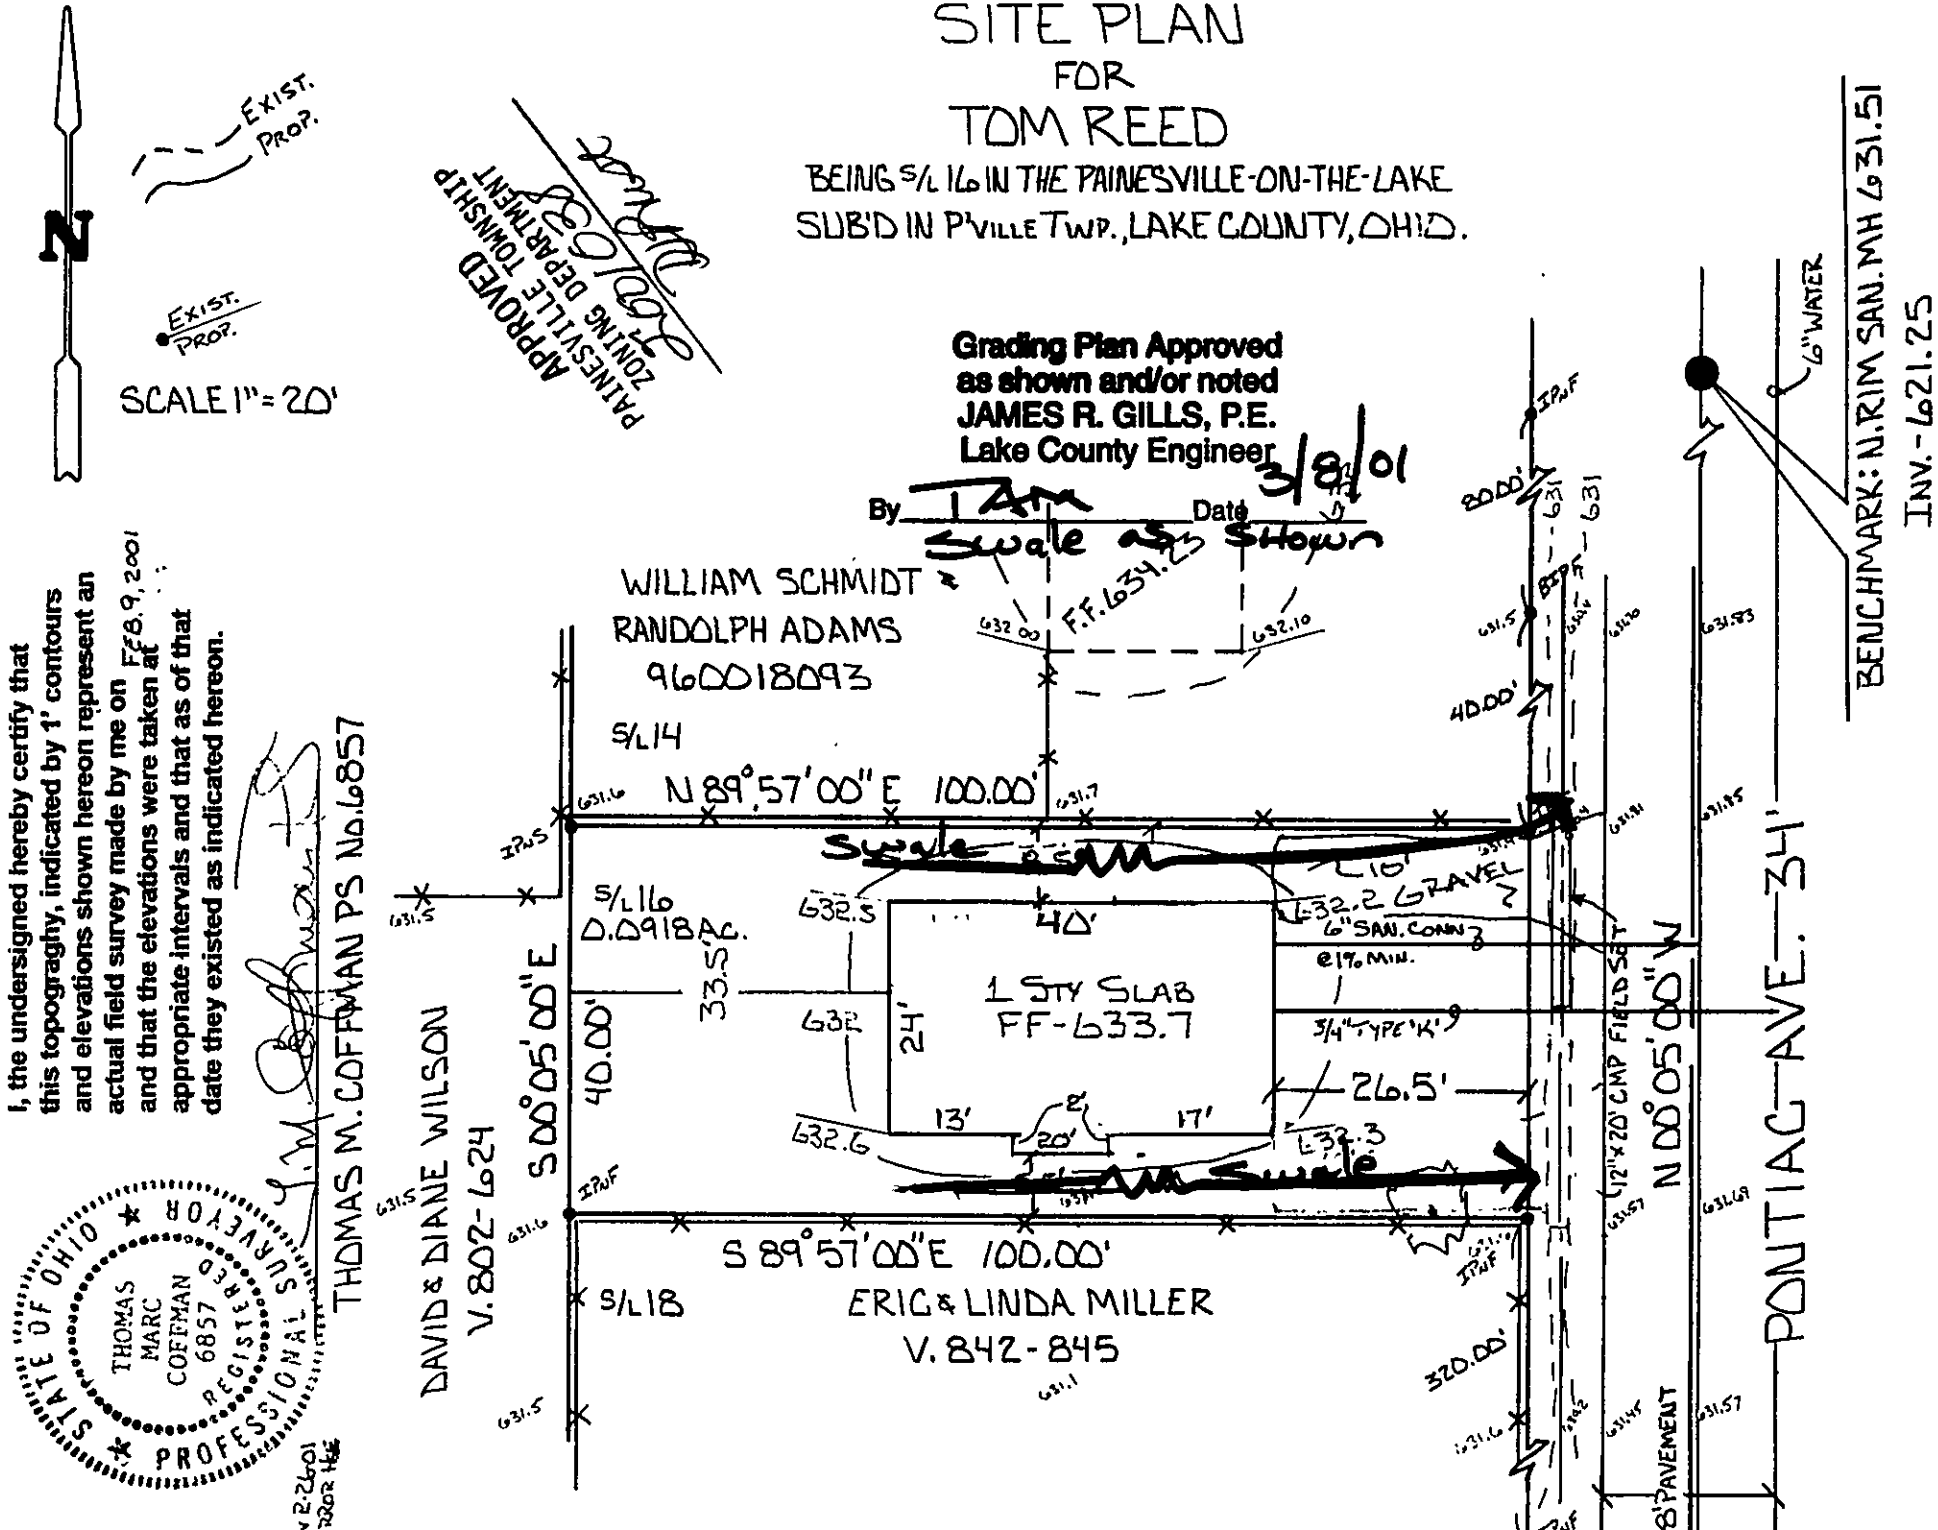

I, the undersigned hereby certify that this topograghy, indicated by 1' contours and elevations shown hereon represent an actual field survey made by me on FEB. 9, 2001 and that the elevations were taken at appropriate intervals and that as of that date they existed as indicated hereon.