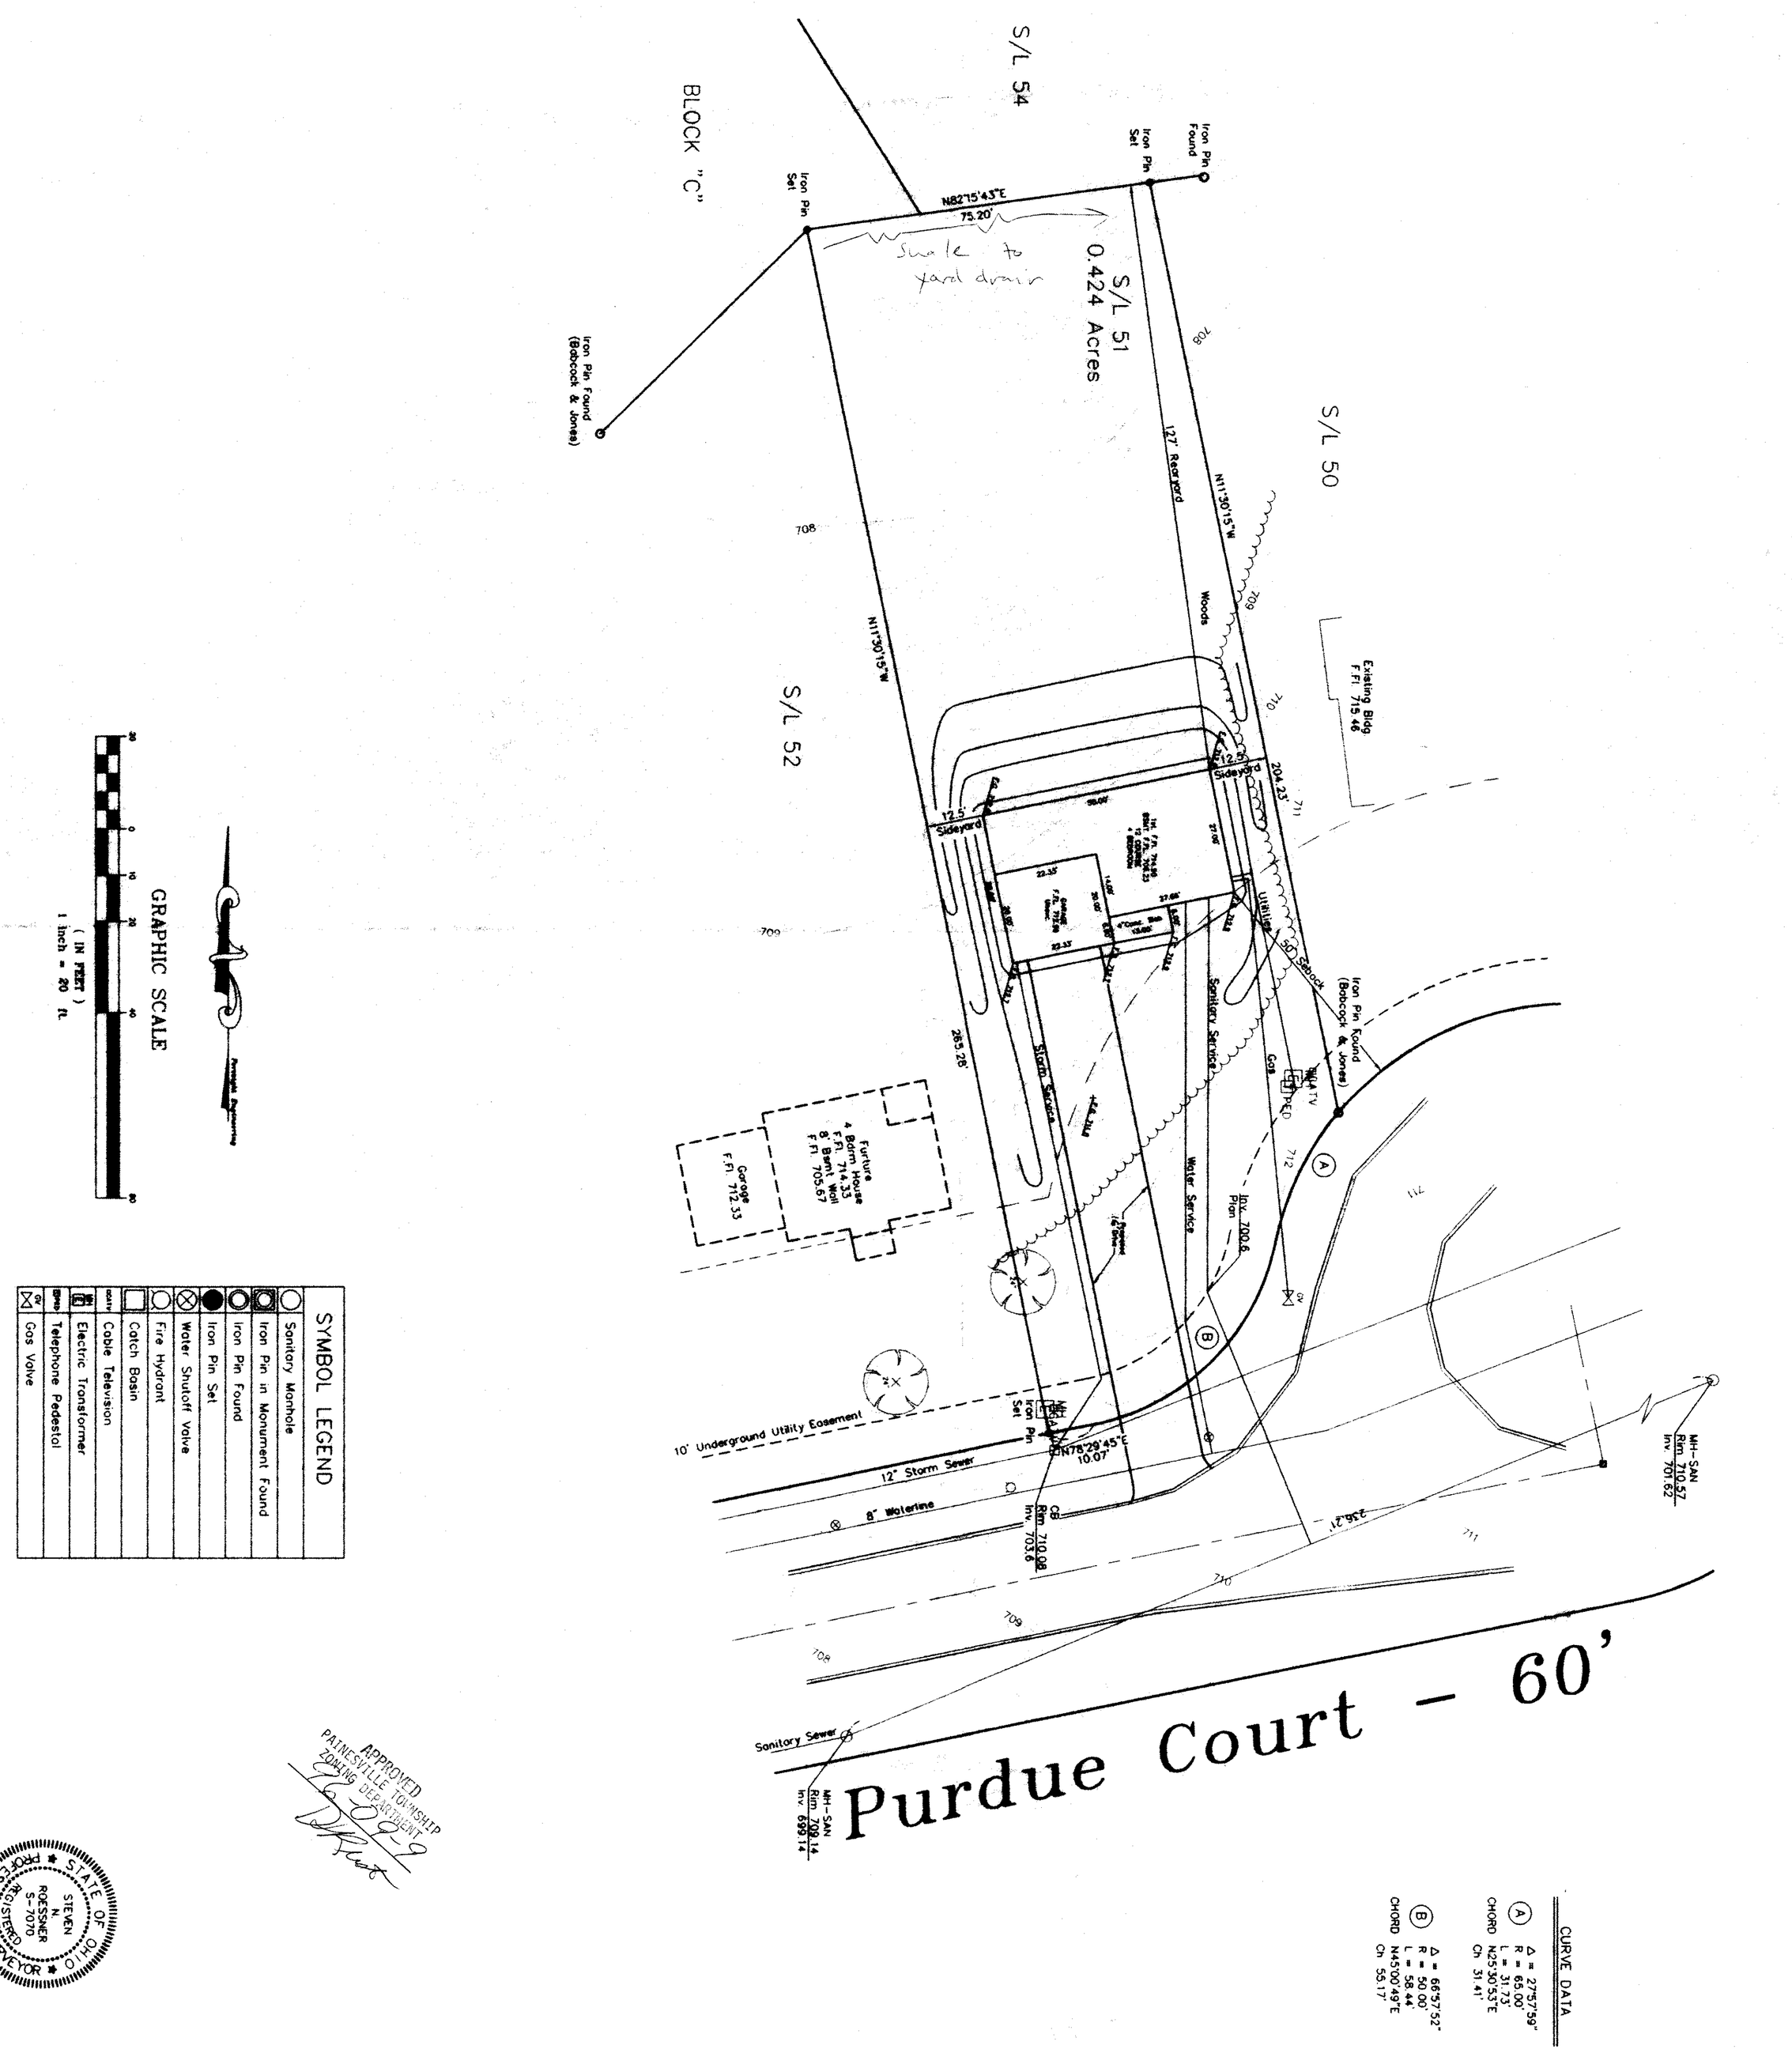

SHEET NO.	Deco Homes Heatherstone Subdivision Painesville Twp. - Lake County - Ohio Site Plan - S/L 51 - Purdue Court	REVISIONS:	SCALE : Horz. 1" = 20 Vert. None FILE NAME: I:\DEC19609\site.dwg DATE : Sept. 9, 1996	Foresight Engineering Group 216 286-1010 216 286-1034 fax 320 Center Street, Unit F Chardon, Ohio 44024 Engineers & Surveyors