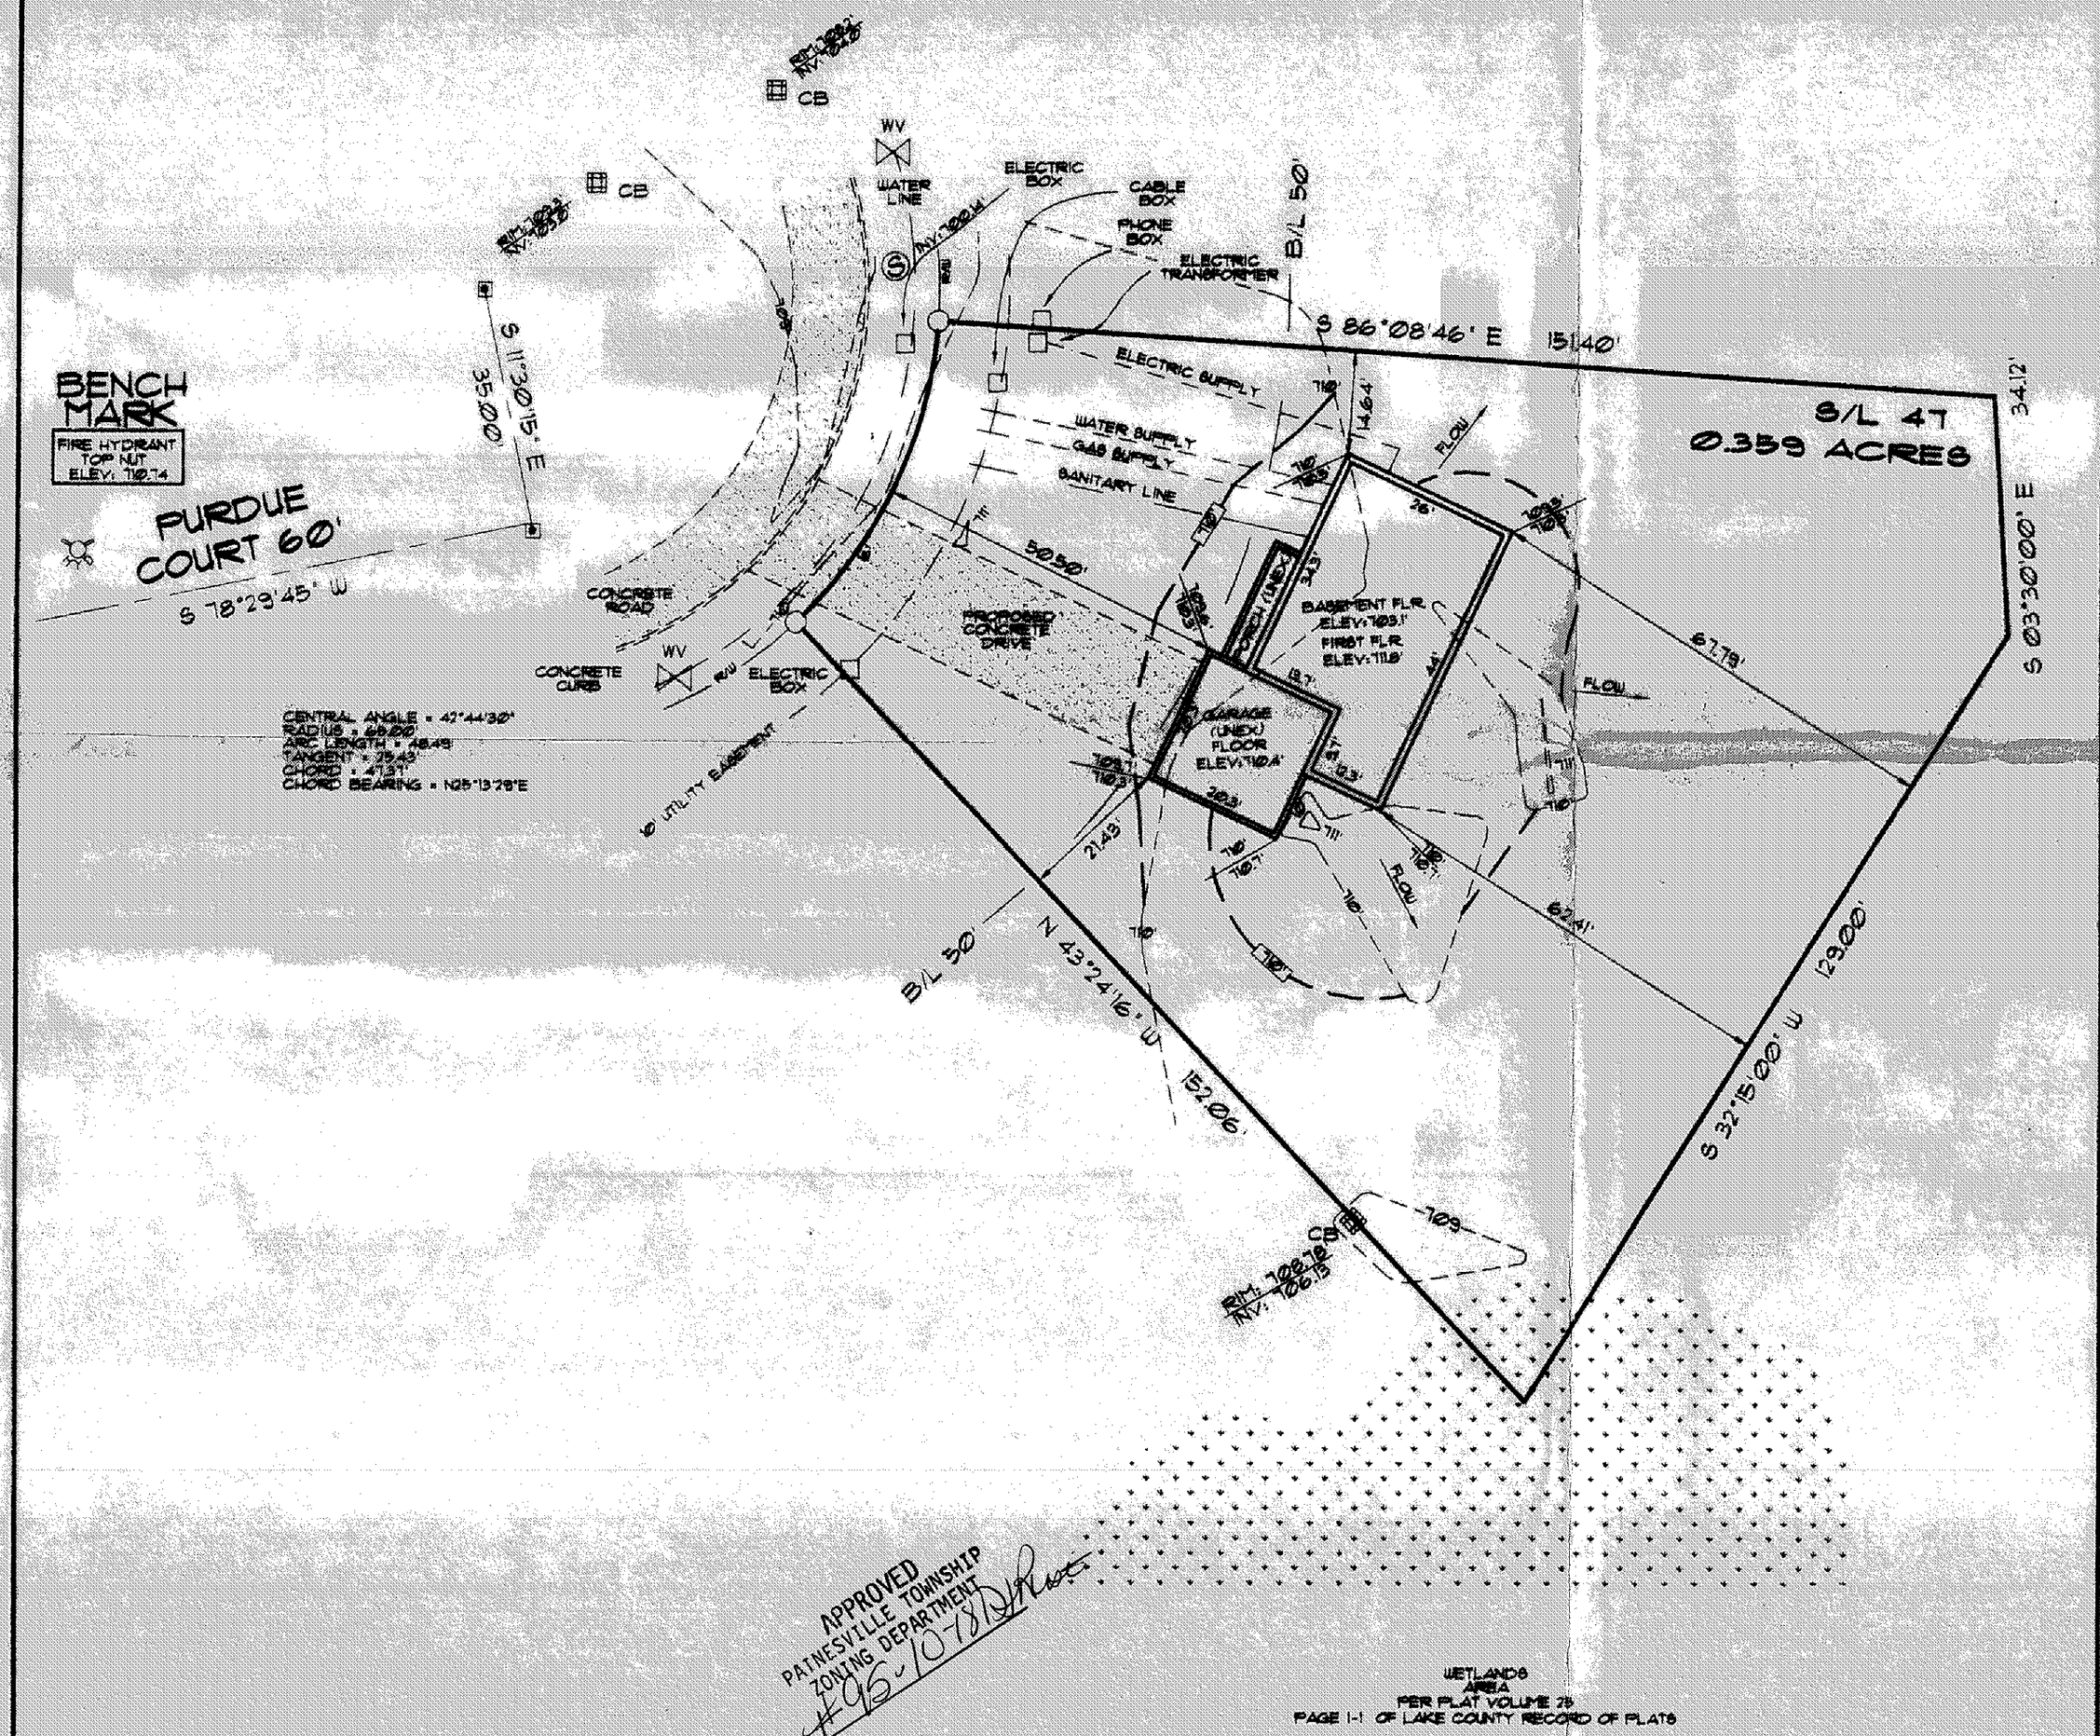

LEGEND

- IRON PIN FOUND
- R. R. SPIKE FOUND
- P.K. NAIL FOUND
- STONE FOUND
- FENCE POST FD. & USED
- IRON PIN SET
- R.R SPIKE SET
- P.K. NAIL SET
- BREAK POINT
- FENCE LINE
- PROPOSED CONTOURS
- EXISTING CONTOURS
- EXISTING ELEV: / PROPOSED ELEV:
- ELECTRIC LINES
- WATER LINE
- SANITARY LINE
- GAS LINE

COPYRIGHT 1995 by Bock & Clark

This product style and format is protected by Copyright. The use of this style and format is strictly prohibited without the written consent and permission of Bock & Clark.

0 10 20 40
1"=20'

SITE IMPROVEMENT PLAN

R.L. MOORE HOMES INC.,
S/L NO. 47
HEATHERSTONE VILLAGE SUBDIVISION
No. 2 PHASE 3
VOLUME 25 PAGE 1-1
1304 PURDUE COURT
TOWNSHIP OF PAINESVILLE
COUNTY OF LAKE
STATE OF OHIO

SURVEYOR'S STATEMENT

"I the undersigned hereby certify that the topography shown hereon, indicated by 1 foot contours and elevations, represents an actual field topographic survey made by me on the 17th day in October 1995 and that the elevations were taken at appropriate intervals and that as of that date they existed as indicated hereon.

Dimensions on this plat are expressed in feet and decimal parts thereof unless otherwise noted. Bearings are referred to an assumed meridian and are used to denote angles only. Monuments were found or set at points indicated hereon.

Grading Plan Approved
as shown and/or noted
THOMAS P. GILLES, P.E.
Lake County Engineer
GJH Date 10-26-95

ROOF DRAINS SHALL DISCHARGE TO SPLASH BLOCKS

STATE OF OHIO
TED R. CLARK
6809
REGISTERED
SURVEYOR

TED R. CLARK, PS
IN THE STATE OF OHIO

DRAWN BY: TJO
DATE OF SURVEY: 10-17-95
PROJECT NUMBER: 129
SHEET 1 OF 1

BOCK & CLARK'S NATIONAL SURVEYORS NETWORK
ENGINEERS & SURVEYORS (800-787-8396) (FAX: 216-350-3074)
8 NORTH STATE STREET, SUITE 102, PAINESVILLE, OHIO 44077