# SITE PLAN

PAINESVILLE TOWNSHIP — LAKE COUNTY, OHIO

**for:** MR. FARREN (CLIENT / OWNER)

ADDRESS — STREET — CITY — ZIP

RIDGECREST SUB #2 — SUBDIVISION NAME

VOL. PG.

SUBLOT NO. — RIDGECREST STREET

LOT 20 — TRACT

VOLUME

PERM. PARCEL NO. — PAGE — RIDGECREST STREET

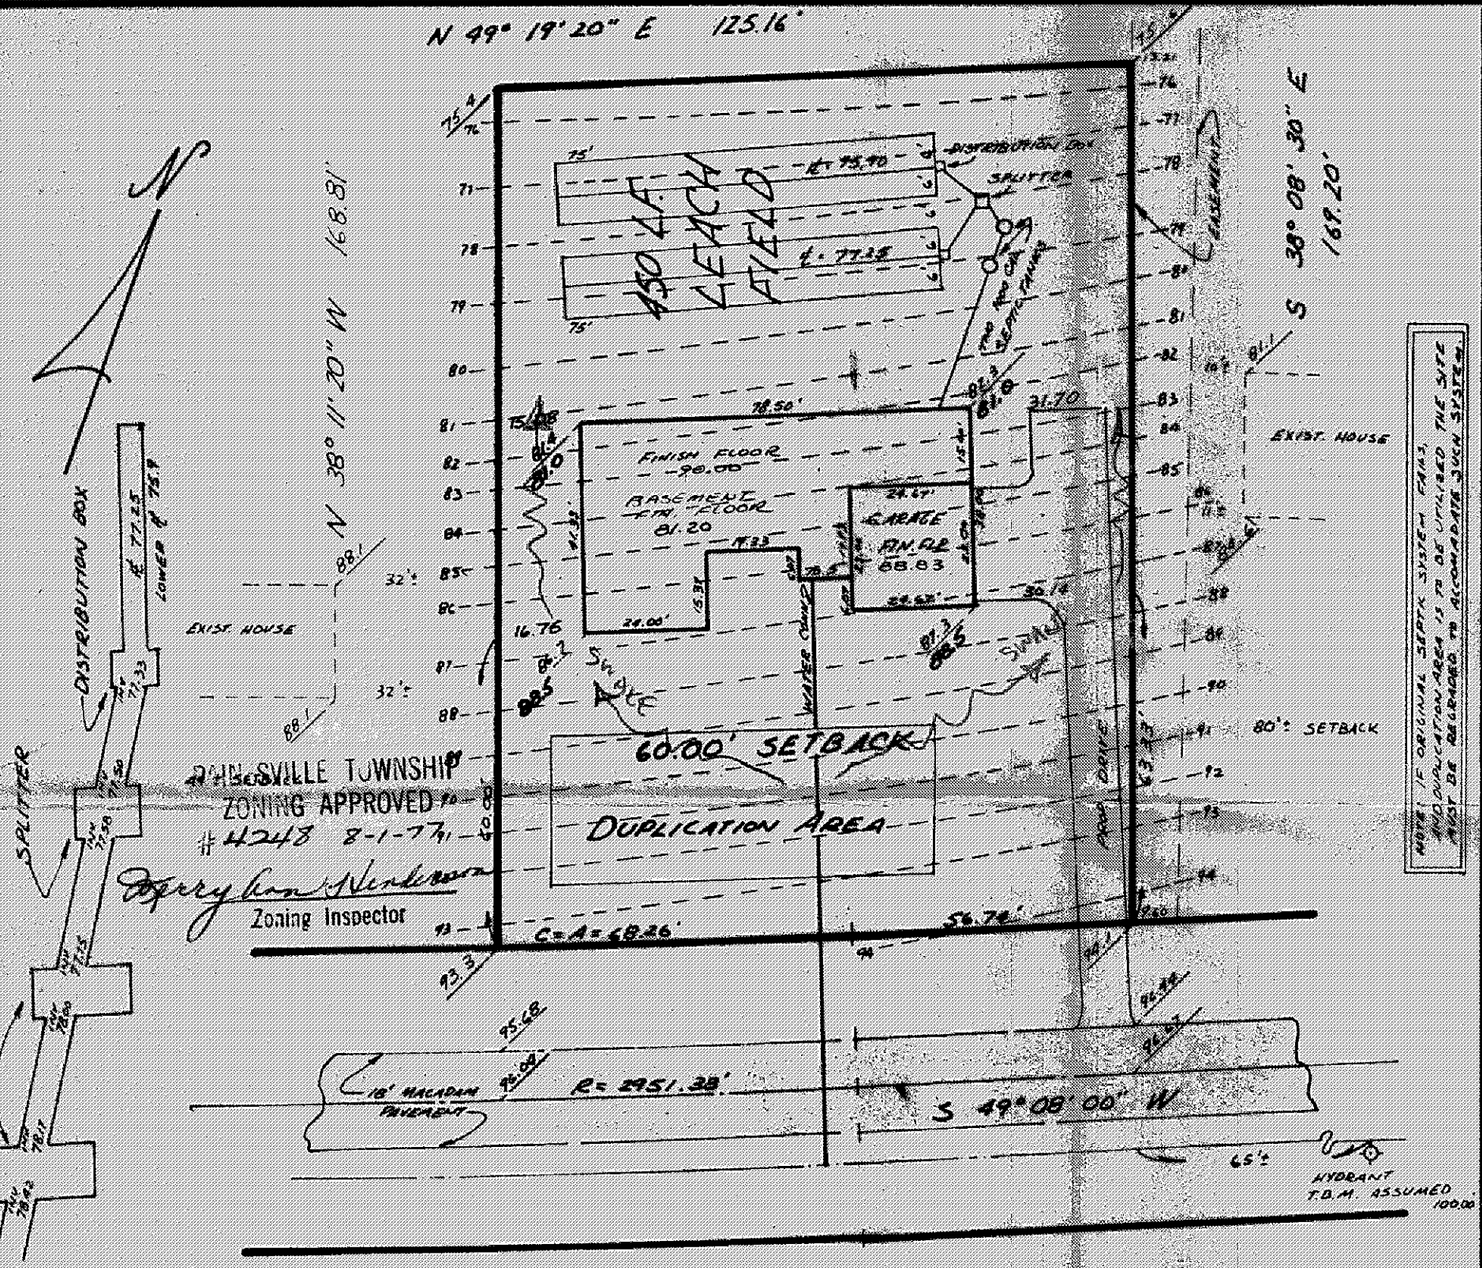


Grading Plan Approved as shown and/or noted
THOMAS P. GILLES, P.E.
Lake County Engineer
By D.T.L. Date 8/1/72

## LEGEND

| | | | |
|---|---|---|---|
| SANITARY MANHOLE | | WATER VALVE (GAS) | |
| STORM MANHOLE | | WATER METER (GAS) | |
| INLET OR CATCH BASIN | | AS BUILT ELEVATION | 100.0 |
| HYDRANT | | INDICATES DIRECTION OF SURFACE DRAINAGE | |
| EXISTING CONTOURS | | | |
| PROPOSED CONTOURS | | | |
| EXIST. ELEV. 100.0 / PROP. ELEV. 100.0 | | | |

## REMARKS

ALL BOUNDARY DATA SHOWN WAS OBTAINED FROM (DEEDS, RECORDED SUBDIVISION PLAT OR OTHER PUBLIC RECORDS)

LOCATIONS AS SHOW OF ADJACENT WELLS AND SERTIC TANKS OBTAINED FROM LAKE COUNTY HEALTH DEPARTMENT

## DESIGN CERTIFICATION

THIS PLAT WAS PREPARED BY ME, AND IS CORRECT TO THE BEST OF MY KNOWLEDGE AND BELIEF.

Edward V. Wade — 4514

NAME — SURVEYOR — REGISTRATION NO.

## CHECK LIST

- NO. OF BEDROOMS
- DIMENSIONS
- BEARINGS
- TIE TO NEAREST STREET
- SUBLOT NO. PARCEL NO.
- SURROUNDING OWNERS
- BLDG. DIMENSIONS FIN. GR.
- BLDG. TIES FL'R. GRADES
- APRON TYPE WIDTH THICKNESS
- SIDEWALK TYPE WIDTH THICKNESS
- CULVERT TYPE DIA., LENGTH
- ROCK OUTCROPPINGS
- WATER MAIN SIZE, LOCATION
- SAN. SEWER SIZE % GR. LOC.
- SAN. MH. CAST. ELEV. INV. ELEV.
- SAN. CONN. SIZE, LOC. DEPTH
- STORM SEWER SIZE % GR. LOC.
- STORM MH. CAST ELEV. INV. ELEV.
- PAV'T TYPE GRADE CURBS
- GAS LINE LOC. SIZE PRESSURE
- SEPTIC TANK LOCATION & DUPLICATION AREA
- WELL LOCATION
- ISOLATION RADIUS FROM WELL

## "AS BUILT" CERTIFICATION

I, HEREBY CERTIFY THAT THE CIRCLED GRADES ARE EXISTING FINISH GRADES CHECKED IN FIELD ON 19 BY SURVEYING AND ARE CORRECT TO THE BEST OF MY KNOWLEDGE AND BELIEF.

REGISTERED SURVEYOR — REG. NO.

| REVISIONS | | |
|---|---|---|
| NO. | DATE | BY |
| 1 | | |
| 2 | | |
| 3 | | |
| 4 | | |
| 5 | | |

PLAN PREPARED BY:

DEBEVEC · SALO & ASSOCIATES, INC.

130 EAST JACKSON ST. PAINESVILLE, OHIO

| | | |
|---|---|---|
| DRAWN BY D.V. | SCALE 1" = 30' | PHONE NO. 352-9250 |
| CHK'D. R.K. | DATE | DRAWING NO. 4934 |
| CREW CHIEF | APP'D. | |