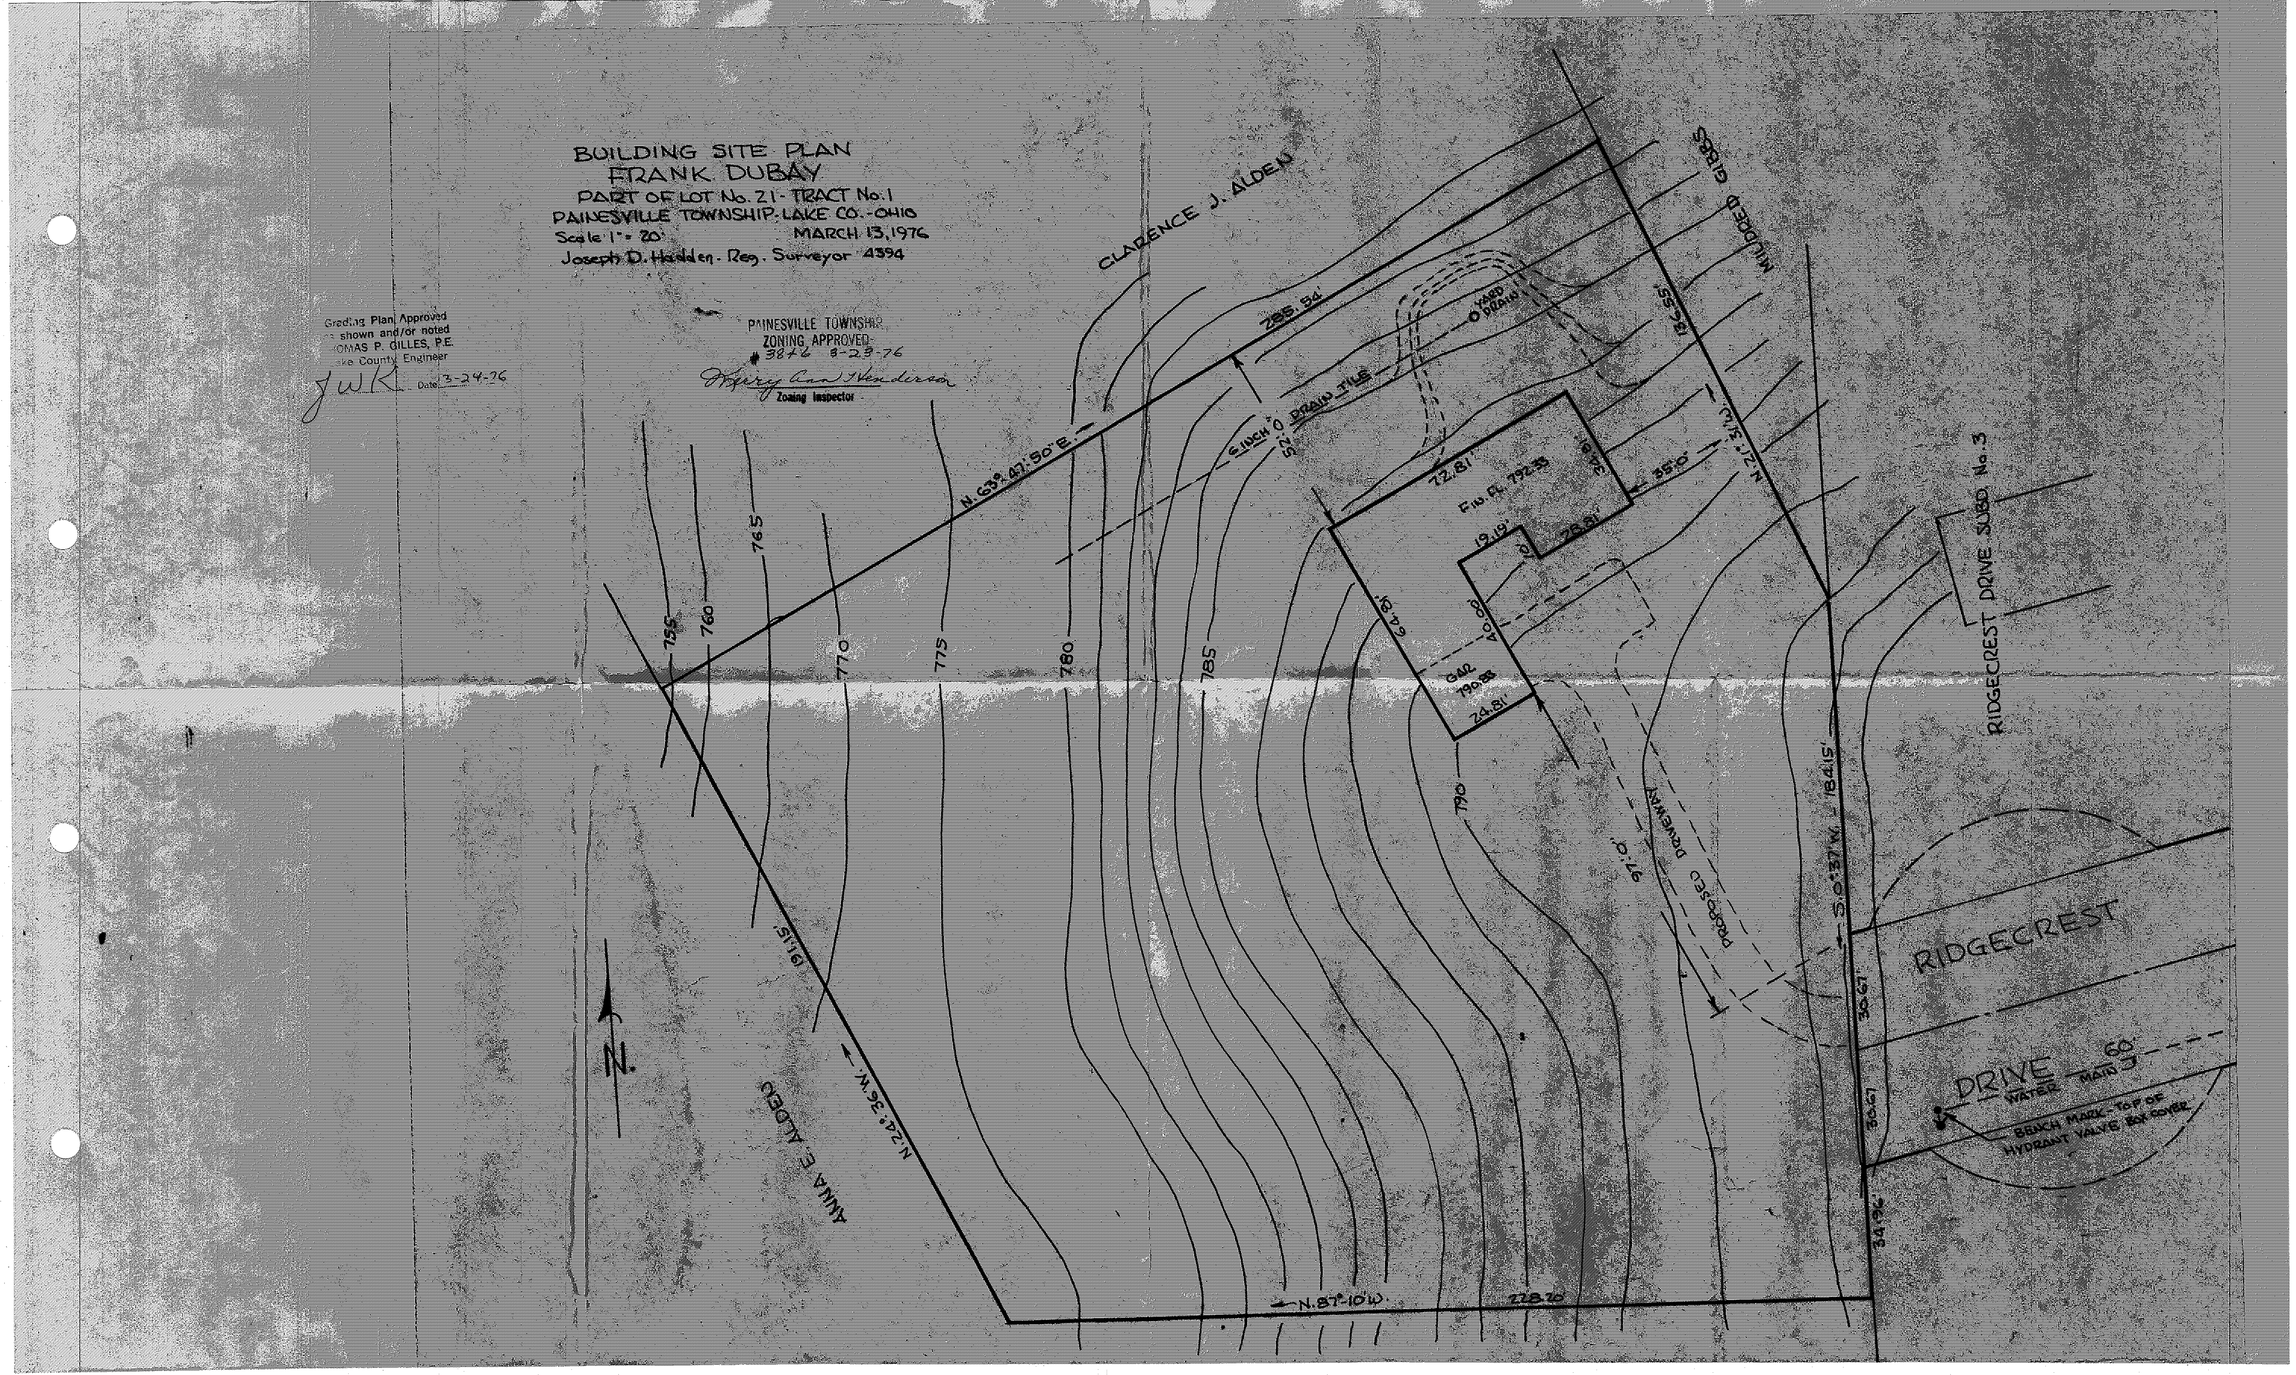
BUILDING SITE PLAN
FRANK DUBAY
PART OF LOT No. 21 - TRACT No. 1
PAINESVILLE TOWNSHIP - LAKE CO. - OHIO
Scale 1" = 20'
MARCH 13, 1976
Joseph D. Hadden - Reg. Surveyor 4394
Grading Plan Approved
as shown and/or noted
THOMAS P. GILLES, P.E.
Lake County Engineer
JWK Date 3-24-76
PAINESVILLE TOWNSHIP
ZONING APPROVED
#3846 8-23-76
Zoning Inspector
CLARENCE J. ALDEN
MILDRED GIBBS
ANNA E. ALDEN
RIDGECREST DRIVE SUBD. No. 3
RIDGECREST
DRIVE
WATER MAIN
BENCH MARK - TOP OF HYDRANT VALVE BOX COVER
PROPOSED DRIVEWAY
YARD DRAIN
6 INCH DRAIN TILE
N. 63° 47' 50" E.
N. 24° 36' W.
N. 87° 10' W.
N. 21° 31' W.
S. 0° 37' W. 184.15'
285.54'
136.55'
72.81'
34.81'
35.0'
19.19'
28.81'
40.00'
64.81'
24.81'
97.0'
191.15'
30.67'
34.96'
228.20'
755
760
765
770
775
780
785
790
N.