PREPARED BY:
Wilson and Associates
Registered Surveyors
11005 Wilson Mills Road
Chardon, Ohio 44024
Date: June 23, 1974
Scale: 1"=30'

SITE PLAN

FOR

B.S.M. Inc.

OF LAND DESCRIBED IN
VOLUME 708 PAGE 24

PAINESVILLE TOWNSHIP

LAKE COUNTY OHIO

for

CASEMENT HOMES
1251 MADISON AVE.
PAINESVILLE, OHIO

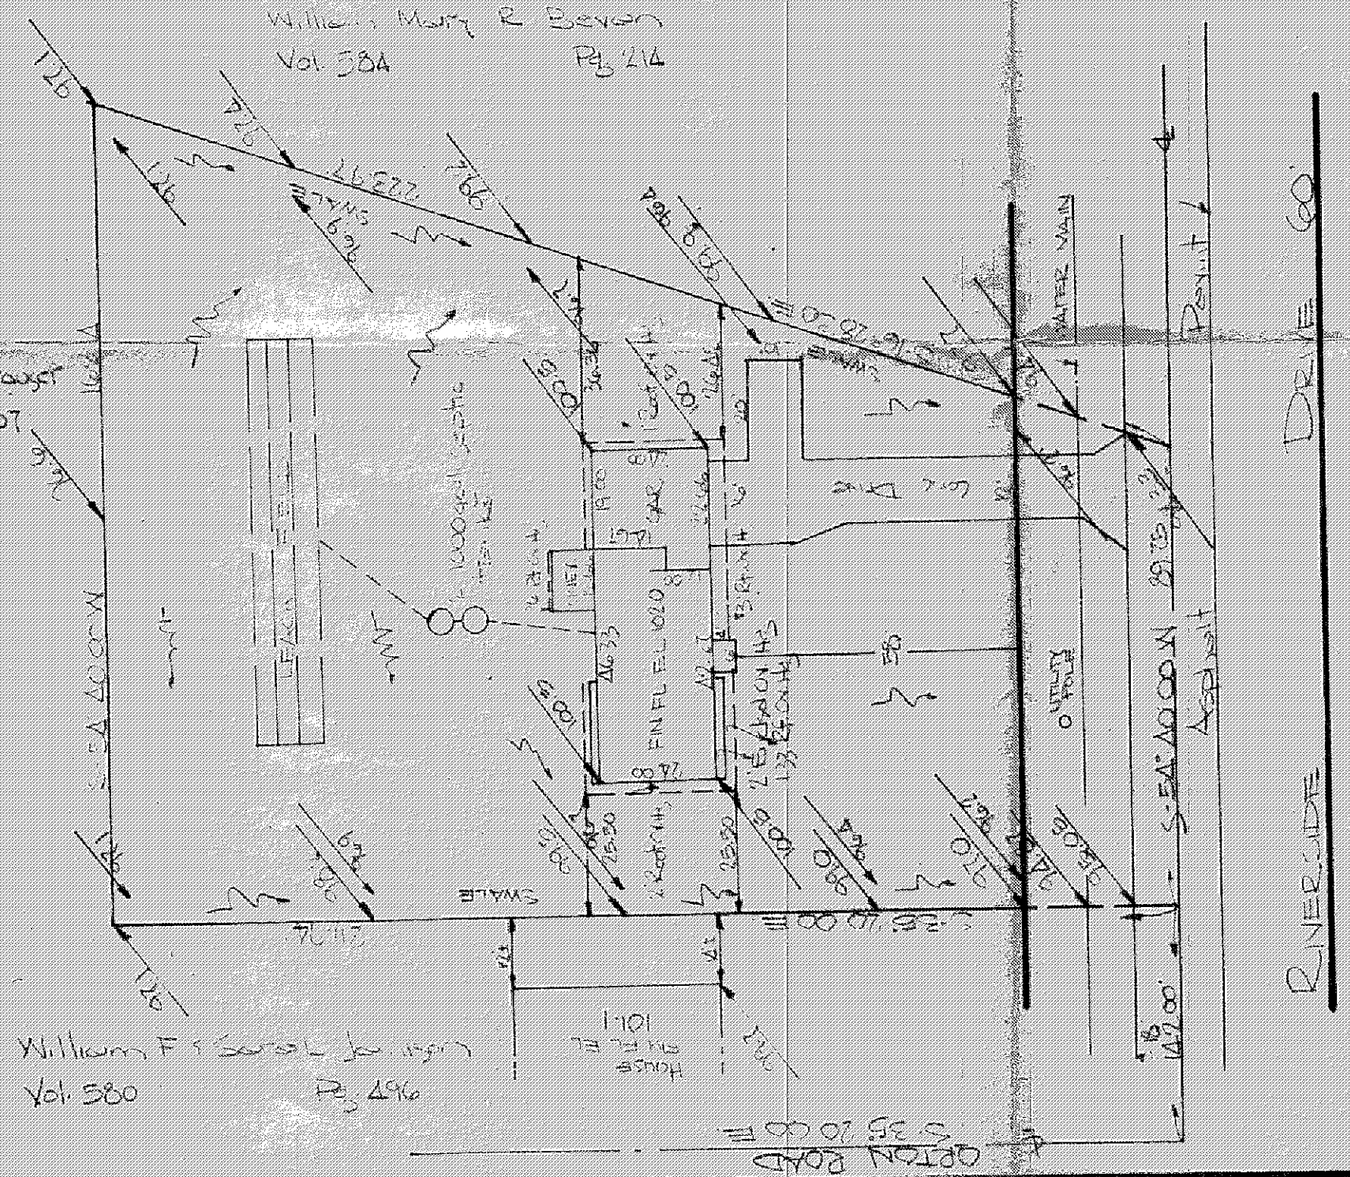

CERTIFICATION:
I certify that this plat was prepared by me, and is correct to the best of my knowledge.
By: Lawrence Wilson
Lawrence Wilson, Reg. Surveyor No. 5807

"AS BUILT" CERTIFICATION:

I certify that on _____ 1974, the finished grades were checked in the field, shown encircled, and are correct to the best of my knowledge.
By: _____
Lawrence Wilson, Reg. Surveyor No. 5807

Grading Plan Approved
as shown and/or noted
THOMAS P. GILLES, P.E.
Lake County Engineer
By: JWK Date: 6-25-74

EXIST
PROP

PAINESVILLE TOWNSHIP
ZONING APPROVED
 # 3488 6-25-74
D. A. Henderson
Zoning Inspector

STATE OF OHIO
LAWRENCE GORDON WILSON
5807
REGISTERED
SURVEYOR

BENCH MARK: TOP OF HYDRANT AT SOUTHEASTERLY CORNER OF INTERSECTION OF ORTON ROAD AND RIVERSIDE DRIVE
ELEV. 100.00