SOURCE BATH LINES TO REAR

11-38-①

Grading Plan Approved
as shown and/or noted
THOMAS P. GILLES, P.E.
Lake County Engineer
By JWK Date 12 June 73

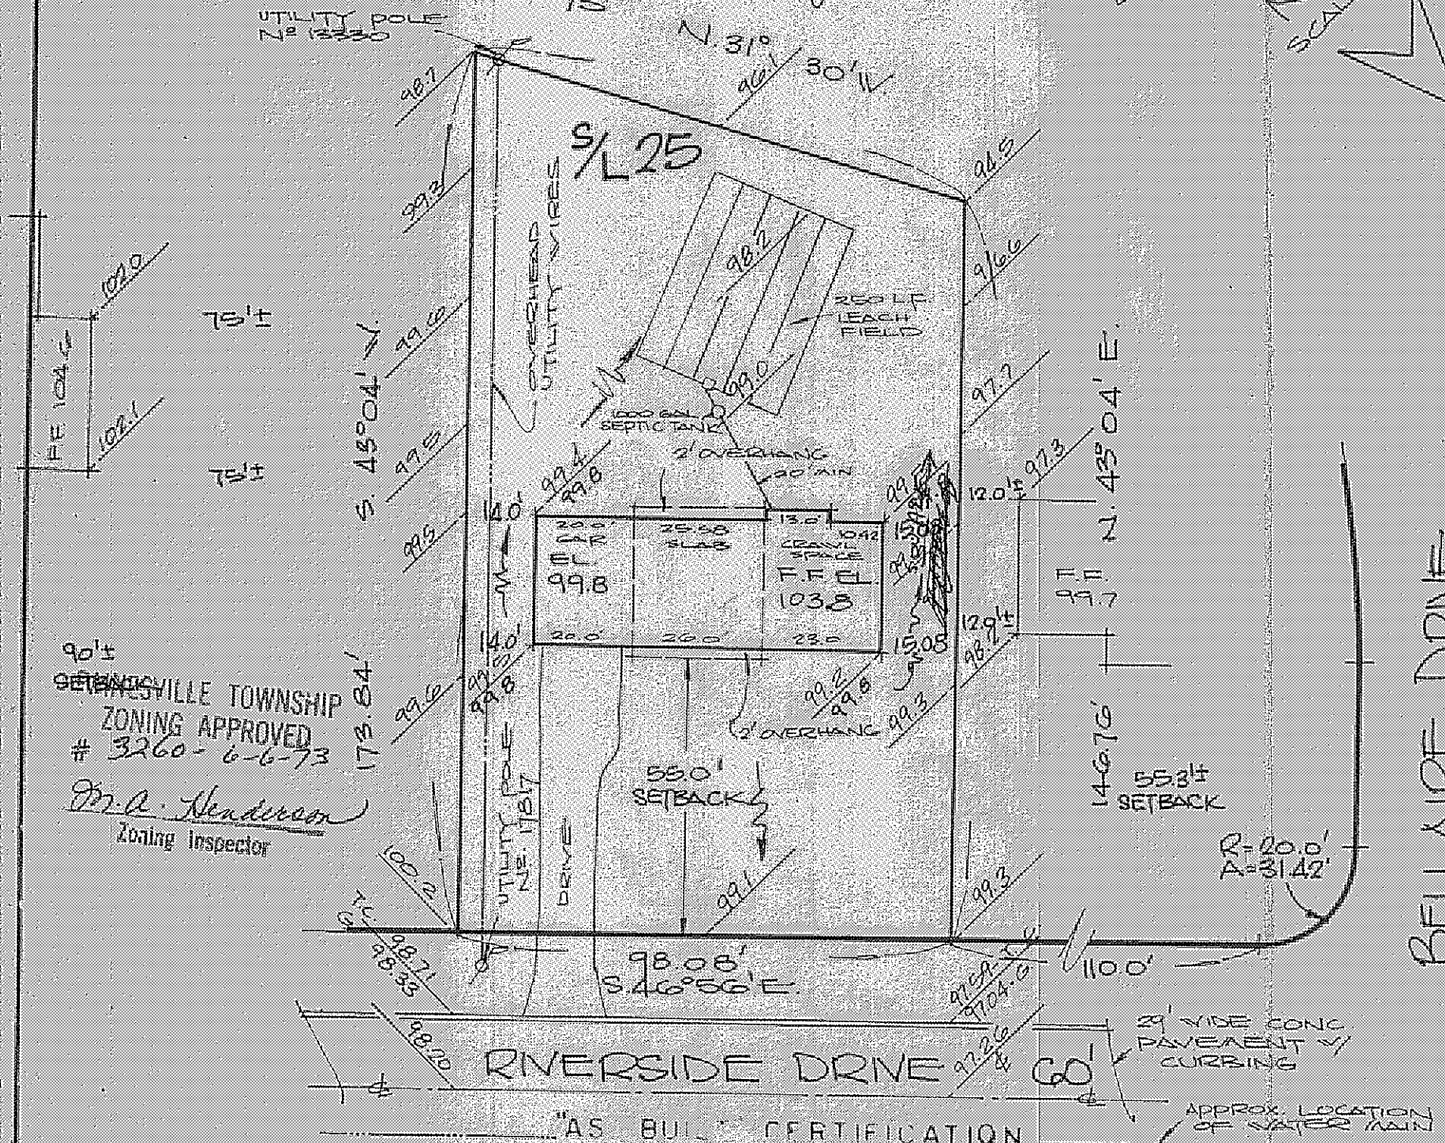

"AS BUILT" CERTIFICATION

I HEREBY CERTIFY THAT THE CHIEF DETAILS ARE CORRECT AS FINISH GRADES CHECKED IN FIELD ON ____ BY SURVEYING AND ARE CORRECT TO THE BEST OF MY KNOWLEDGE AND BELIEF

REGISTERED SURVEYOR NO

SITE PLAN

PAINESVILLE TOWNSHIP LAKE COUNTY, OHIO

for: BSM, INC.
CLIENT OWNER

ADDRESS STREET CITY ZIP

BELLAIRE DRIVE SUB
SUBDIVISION

K-7
VOLUME PAGE

S/L 15
SUBLOT No.

RIVERSIDE DR.
STREET

LOT TRACT
VOLUME PAGE
FEDR. PARCEL # STREET

LEGEND

SANITARY MANHOLE
STORM MANHOLE
INLET OR CATCH BASIN
HYDRANT
EXISTING CONTOUR
PROPOSED CONTOURS
EXIST ELEV = 100.0
100.0 - PROP ELEV
WATER VALVE (GAS)
WATER METER (GAS)
AS BUILT ELEVATION
INDICATES DIRECTION OF SURFACE DRAINAGE

REMARKS

ALL BOUNDARY DATA SHOWN WAS OBTAINED FROM (DEEDS RECORDED SUBDIVISION PLAT, OR OTHER PUBLIC RECORDS)

DESIGN CERTIFICATION

THIS PLAT WAS PREPARED BY ME, AND IS CORRECT TO THE BEST OF MY KNOWLEDGE AND BELIEF.

Richard Farber PS#5244
NAME SURVEYOR REGISTRATION NO.

CHECK LIST

DIMENSIONS
BEARINGS
TIE TO NEAREST STREET
SUBLOT NO PARCEL NO
SURROUN NG OWNER
BLDG DIMENSIONS F N GR
BLDG TIES FLR GRADES
APRON TYPE WIDTH THICKNESS
CURB TYPE WIDTH THICKNESS
CULVERT TYPE SIZE LENGTH
WATER MAIN SIZE LOCATION
SAN SEWER SIZE % GR LOC
SAN MH CAST ELEV INV ELEV
SAN CONN SIZE LOC DEPTH
STORM SEWER SIZE % GR LOC
STORM MH CAST ELEV INV ELEV
PAVT TYPE GRADE CURBS
GAS LINE LOC SIZE PRESSURE
SEPTIC TANK SIZE LOC
WELL LOCATION

REVISIONS		
No.	DATE	BY
1		
2		
3		
4		
5		

PLAN PREPARED BY:
DEBEVEC·SALO & ASSOC., INC.
NAME
130 E. JACKSON ST. PAINESVILLE, O.
ADDRESS

DRAWN BY AC	SCALE 1" = 30'	
CHK	DATE 5/31/73	DRAWING NO. 3945
CREW CHIEF	APP'D	