# SITE PLAN
FOR
## R.C. REED CONST.
BEING S/L 24, HEATHERSTONE VILLAGE SUB'D., NO. 2, PHASE 2, IN THE TOWNSHIP OF PAINESVILLE, LAKE COUNTY, OHIO.

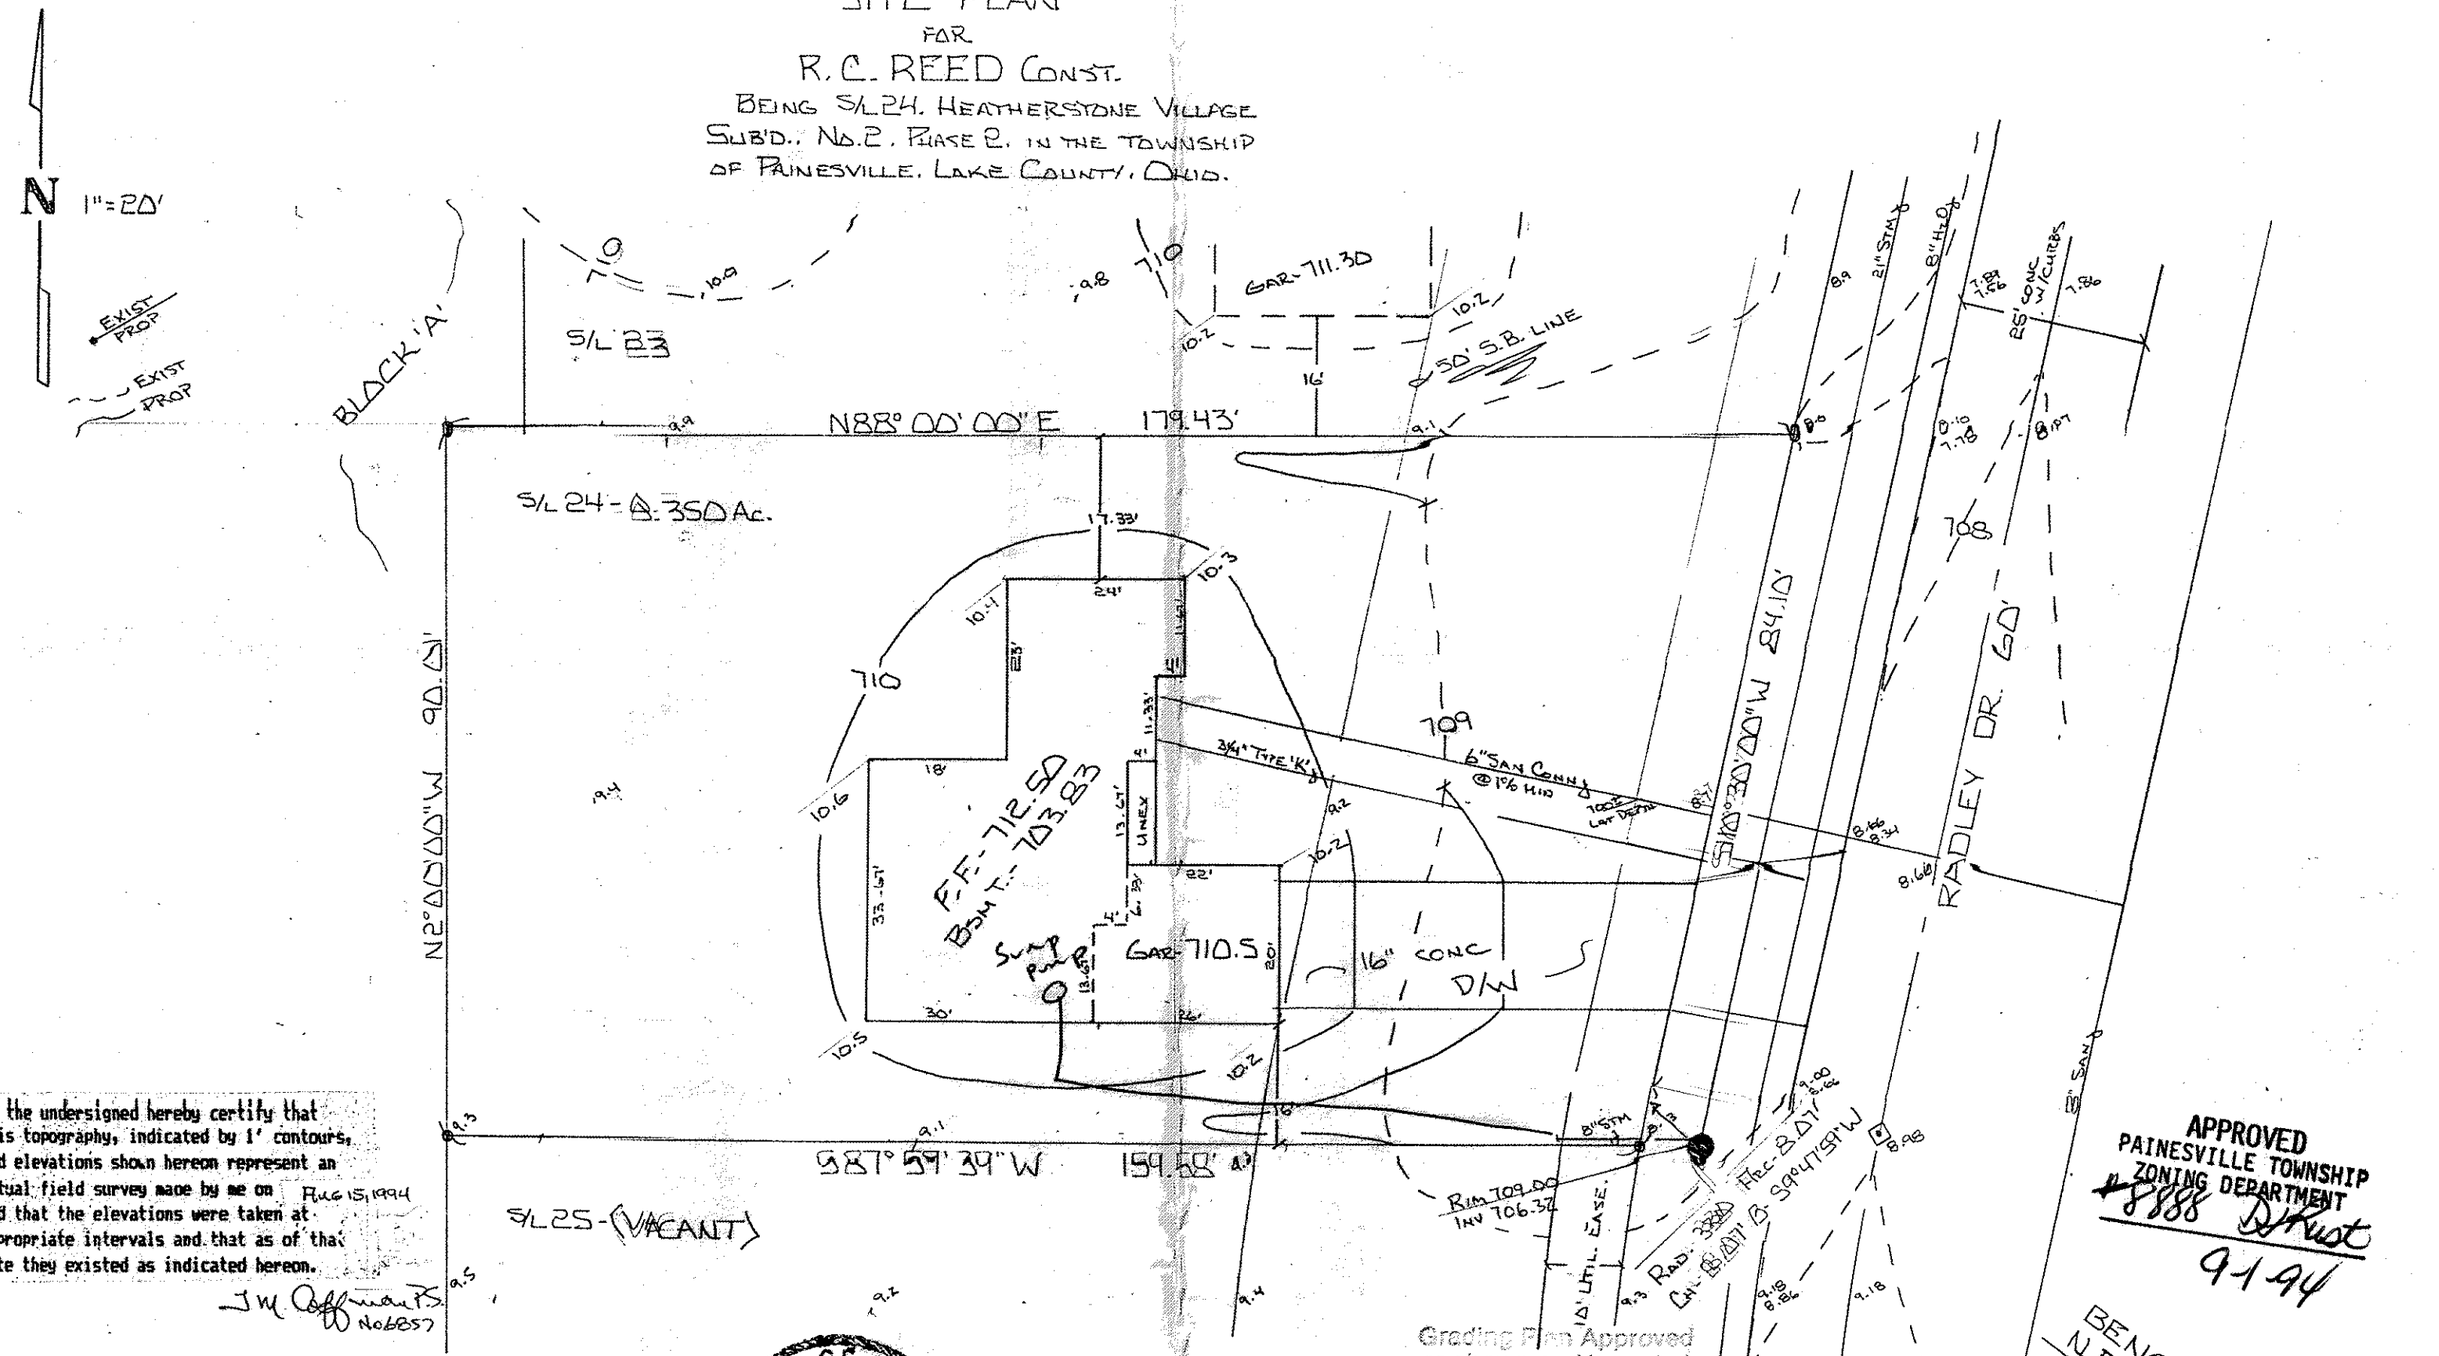


I, the undersigned hereby certify that this topography, indicated by 1' contours, and elevations shown hereon represent an actual field survey made by me on Aug 15, 1994 and that the elevations were taken at appropriate intervals and that as of that date they existed as indicated hereon.

J.M. Coffman P.S. No 6857

STATE OF OHIO
THOMAS MARC COFFMAN
6857
REGISTERED SURVEYOR
Aug 23, 1994

VILLAGE SURVEYING Co.
P.O. Box 1096, Fairport Hbr., OH 44077
(216) 357-1359

Grading Plan Approved
as shown and/or noted
THOMAS P. GILLES, P.E.
Lake County Engineer
By GJH Date 9-6-94

Discharge sump pump to stm. sewer as shown.

**ROOF DRAINS SHALL DISCHARGE TO SPLASH BLOCKS.**

APPROVED
PAINESVILLE TOWNSHIP
ZONING DEPARTMENT
#8888 D. Hurst
9-1-94