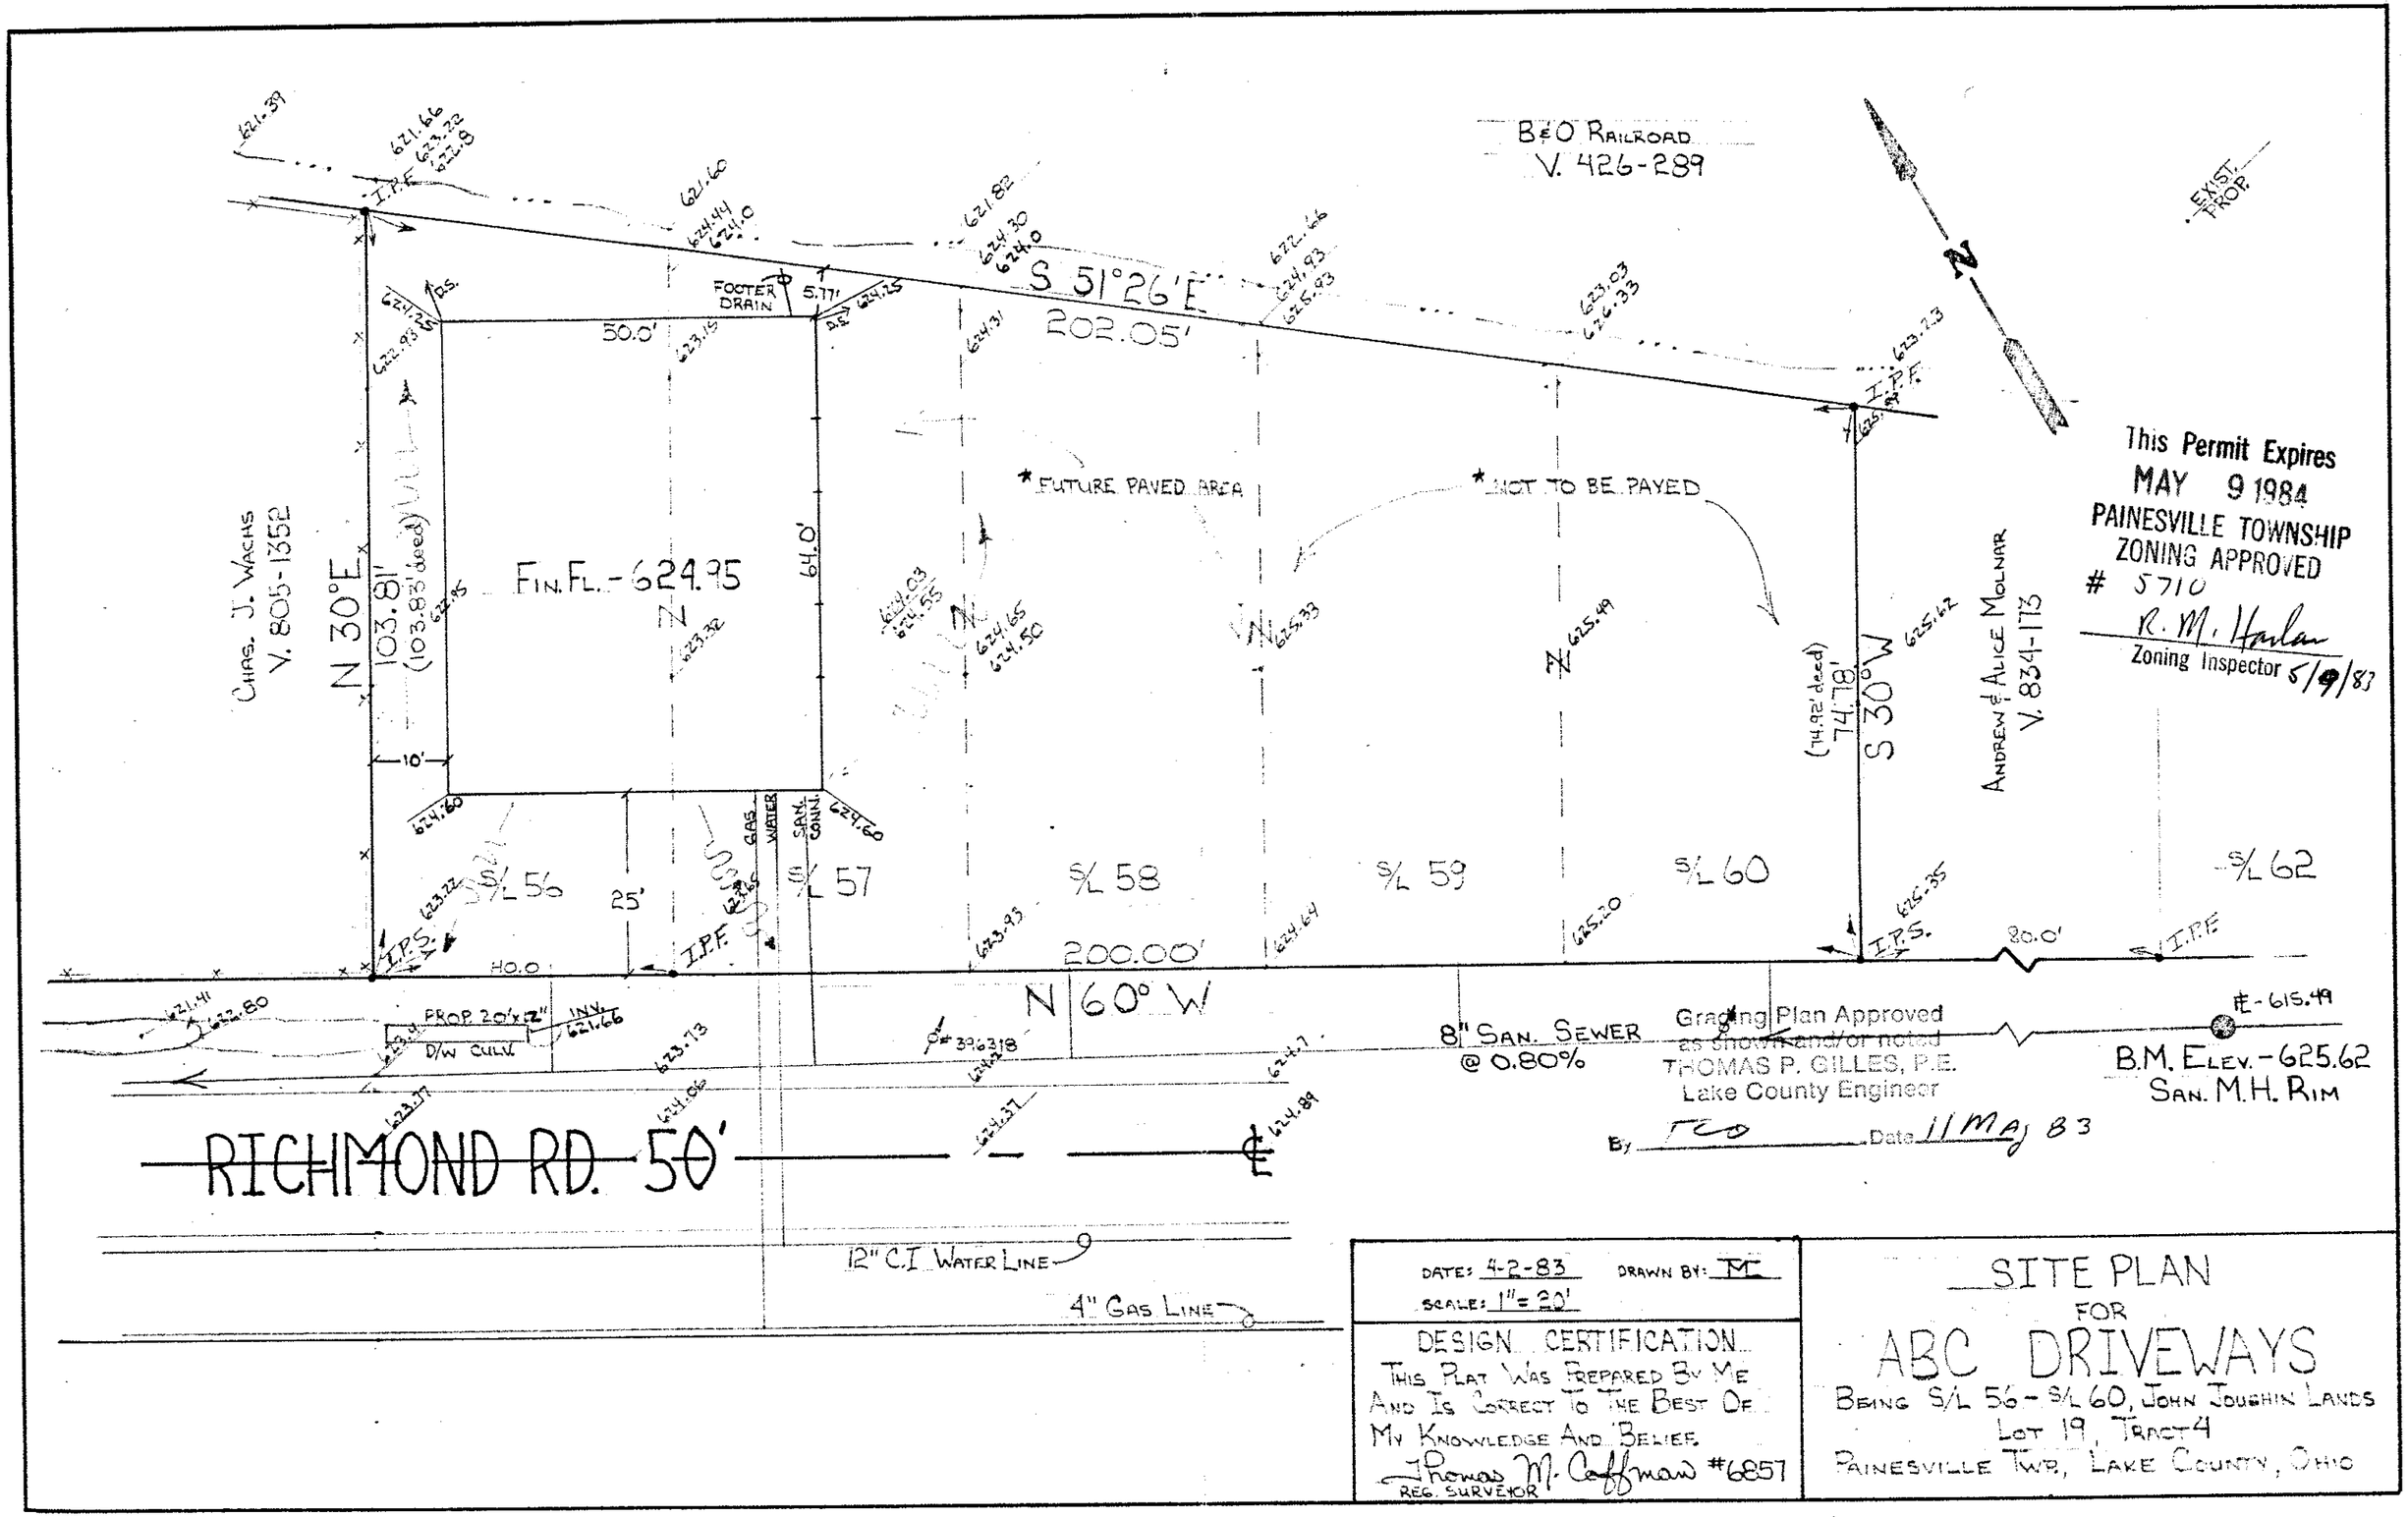

This Permit Expires
MAY 9 1984
PAINESVILLE TOWNSHIP
ZONING APPROVED
5710
R. M. Harlan
Zoning Inspector 5/9/83

DATE: 4-2-83 DRAWN BY: TC
SCALE: 1" = 20'

DESIGN CERTIFICATION
This Plat Was Prepared By Me And Is Correct To The Best Of My Knowledge And Belief.
Thomas M. Coffman #6857
Reg. Surveyor

SITE PLAN
FOR
ABC DRIVEWAYS
Being S/L 56 - S/L 60, John Joughin Lands
Lot 19, Tract 4
Painesville Twp., Lake County, Ohio