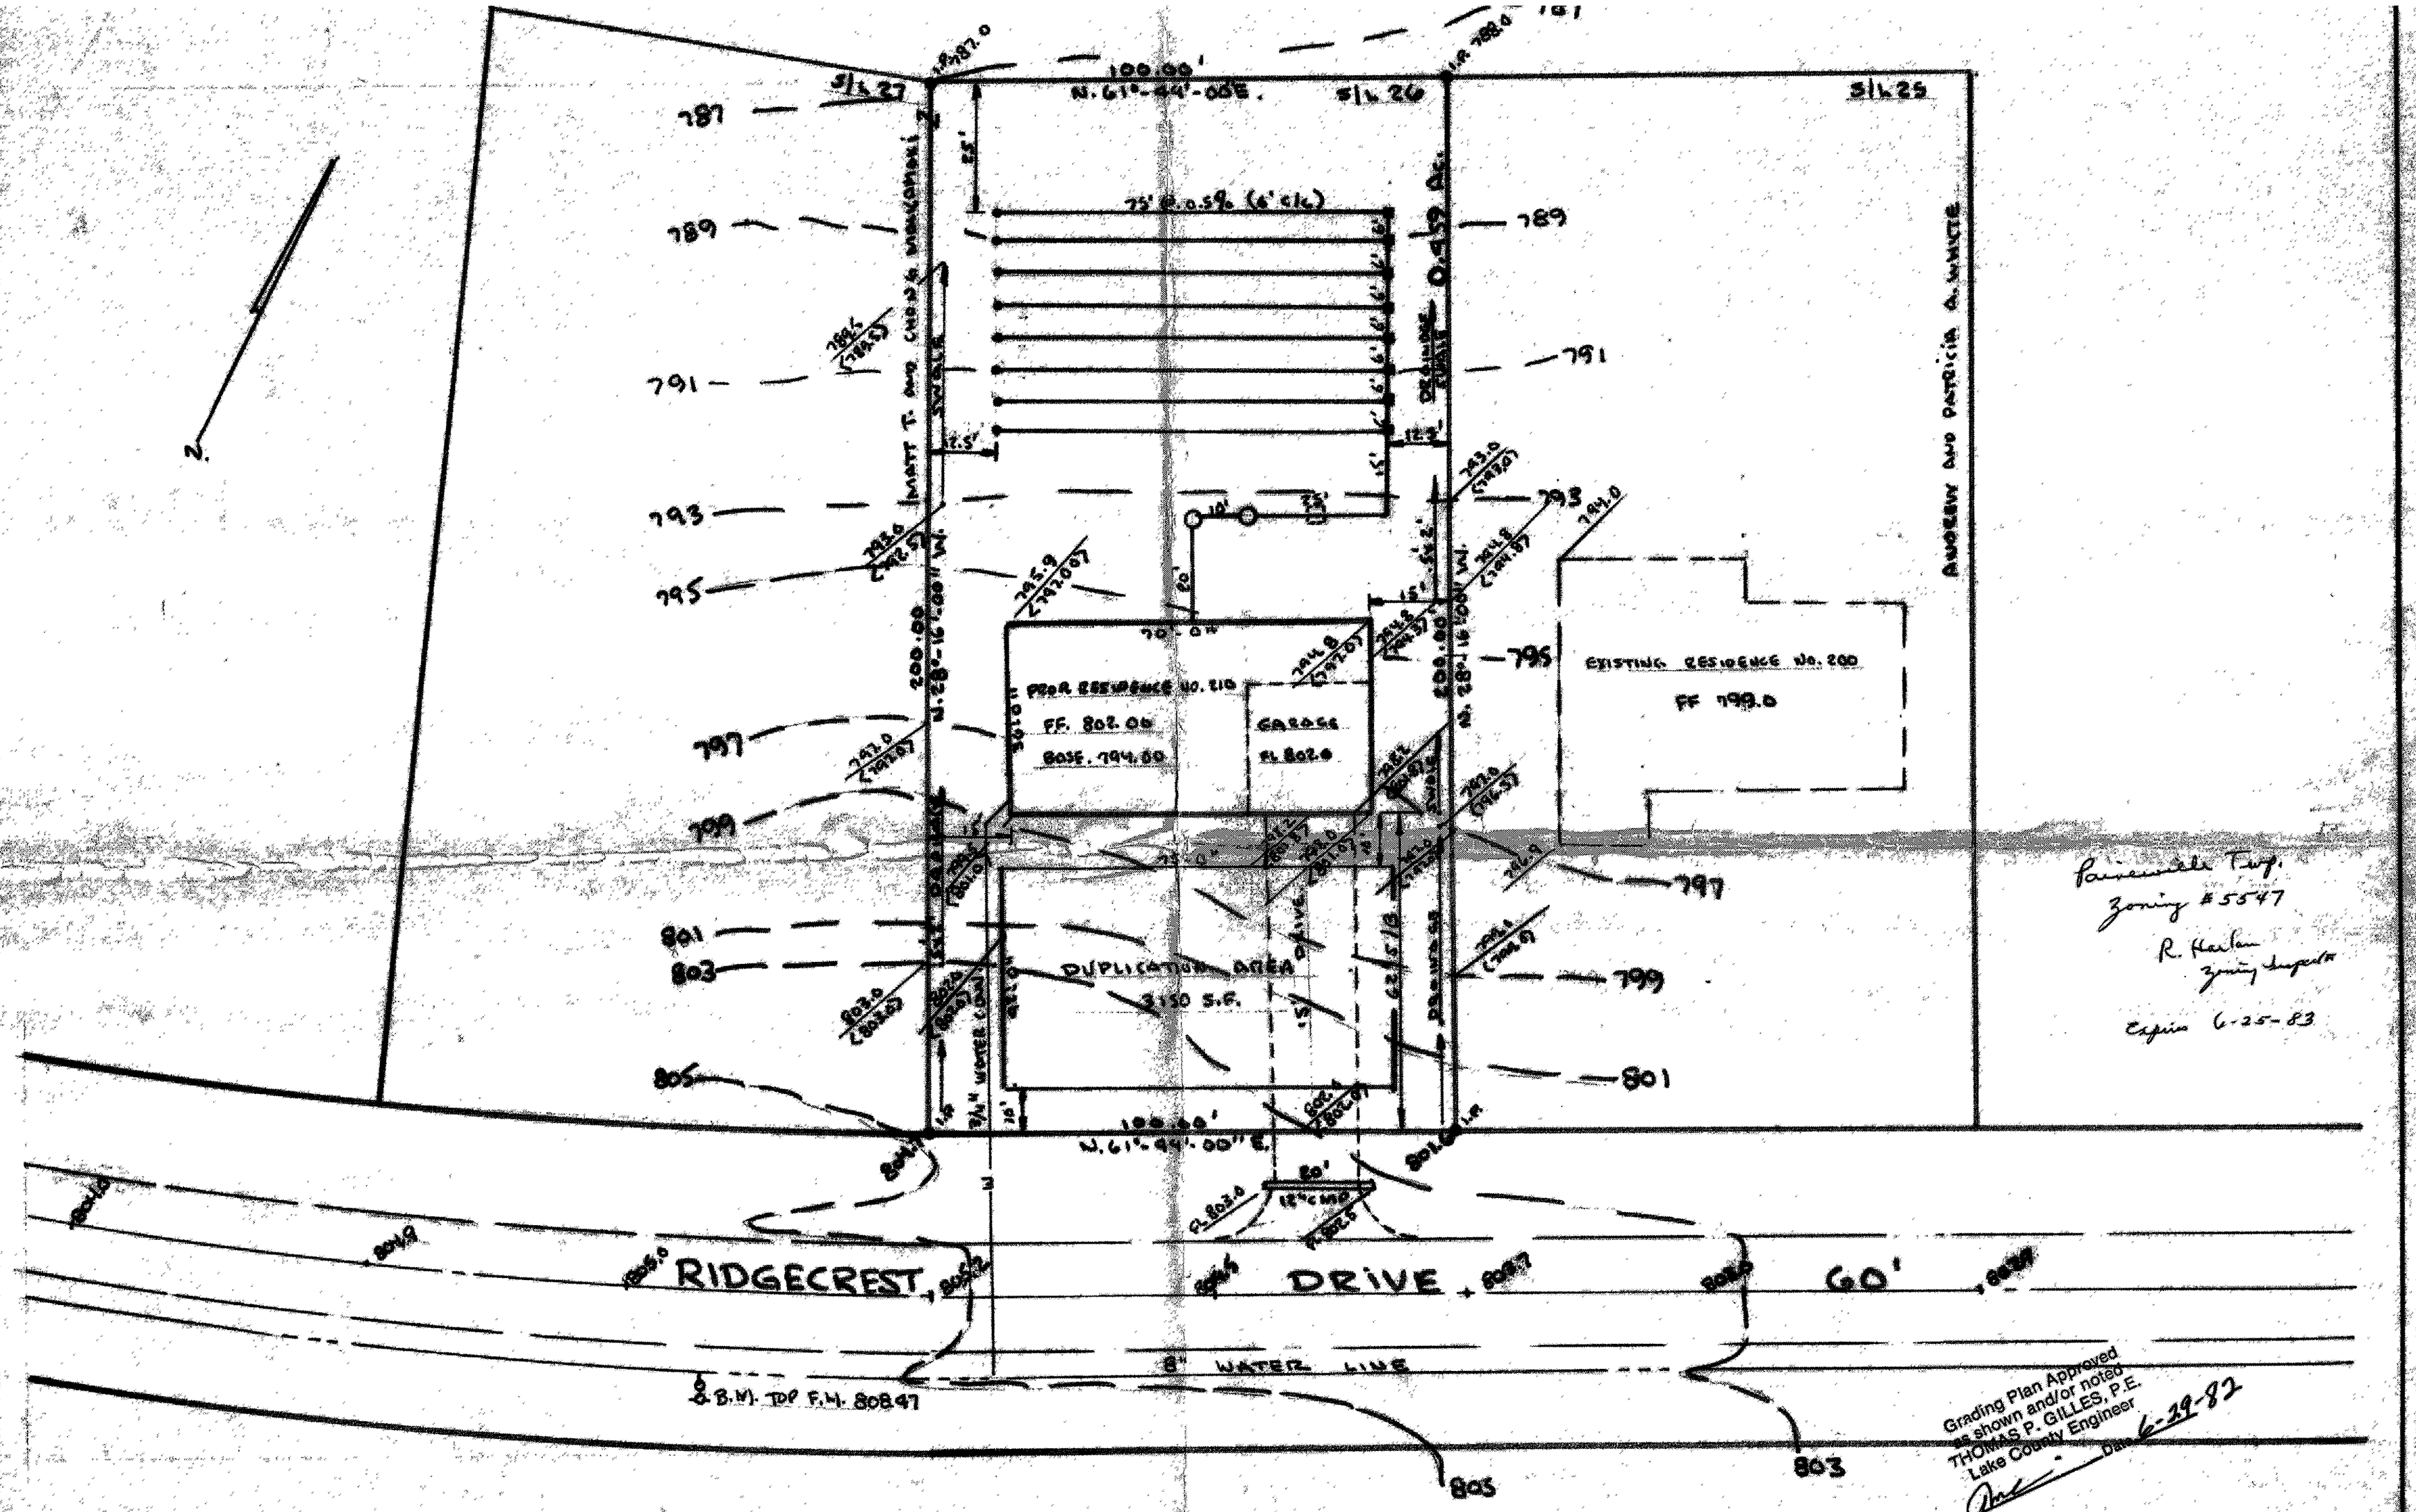

Painesville Twp.
Zoning #5547
R. Harlan
Zoning Inspector
Expires 6-25-83

Grading Plan Approved as shown and/or noted
THOMAS P. GILLES, P.E.
Lake County Engineer
By [signature] Date 6-29-82

EXIST. GR. 802.0
PROP. GR. (801.5)

STATE OF OHIO ROBERT J. ALBAN 5711 REGISTERED SURVEYOR

STATE OF OHIO ROBERT J. ALBAN 34873 REGISTERED PROFESSIONAL ENGINEER

MALKAMAKI SITE PLAN

SCALE: 1:20	APPROVED BY	DRAWN BY
DATE: 5/10/82		REVISED

S/L 26 RIDGECREST DRIVE SUBDIVISION NO. 3

PAINESVILLE TWP.; LAKE CO. OHIO

DRAWING NUMBER

OCE INDUSTRIES INC. 8310 ELLCO VEL T/P