SITE PLAN

PAINESVILLE (TOWNSHIP) LAKE COUNTY, OHIO

for THOMAS KALLAY (CLIENT, OWNER)

279 MENTOR AVE., PAINESVILLE, OHIO (ADDRESS, STREET, CITY, ZIP)

SUBDIVISION NAME / SUBLOT NO. / STREET

LOT 11 / TRACT 2 / VOLUME 768 / PAGE 278 / PERM. PARCEL # / RIVERSIDE DR. STREET

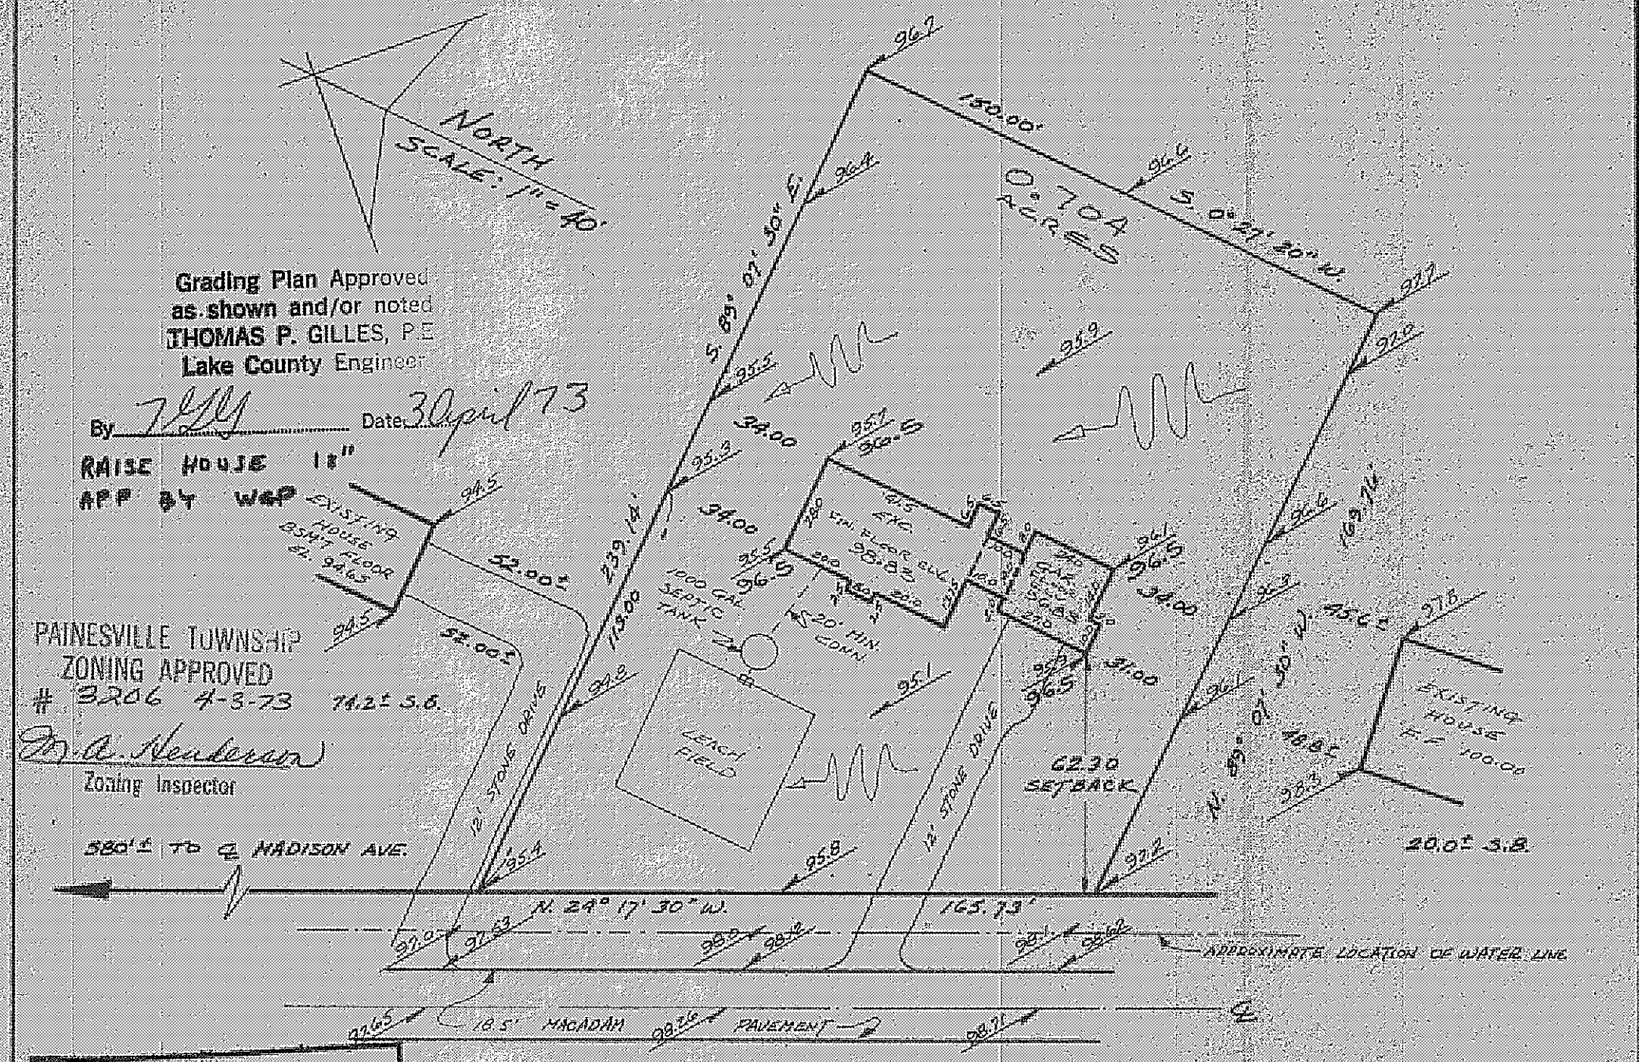

Grading Plan Approved as shown and/or noted
THOMAS P. GILLES, P.E.
Lake County Engineer

By [signature] Date 30 April 73

RAISE HOUSE 18"
APP BY WGP

PAINESVILLE TOWNSHIP
ZONING APPROVED
3206 4-3-73 74.2± S.B.
M. A. Henderson
Zoning Inspector

Reviewed and Accepted
LAKE COUNTY COMBINED GENERAL
DISTRICT DEPARTMENT OF HEALTH
Date 4-7-73
FRED C. KLUTH, M.D.
Health Commissioner
By [signature]

RIVERSIDE DRIVE 60'

"AS BUILT" CERTIFICATION

I, HEREBY CERTIFY THAT THE CIRCLED GRADES ARE EXISTING FINISH GRADES CHECKED IN FIELD ON _____ 19__ BY SURVEYING AND ARE CORRECT TO THE BEST OF MY KNOWLEDGE AND BELIEF

REGISTERED SURVEYOR REG. NO.

LEGEND

SANITARY MANHOLE
STORM MANHOLE
INLET OR CATCH BASIN
HYDRANT
EXISTING CONTOURS
PROPOSED CONTOURS
EXIST. ELEV. 100.0 / 100.0 PROP. ELEV.

WATER VALVE (GAS)
WATER METER (GAS)
AS BUILT ELEVATION 100.0
INDICATES DIRECTION OF SURFACE DRAINAGE

REMARKS

ALL BOUNDARY DATA SHOWN WAS OBTAINED FROM (DEEDS, RECORDED SUBDIVISION PLAT, OR OTHER PUBLIC RECORDS)

DESIGN CERTIFICATION

THIS PLAT WAS PREPARED BY ME, AND IS CORRECT TO THE BEST OF MY KNOWLEDGE AND BELIEF

Richard J. Dolski PS # 5244
NAME SURVEYOR REGISTRATION NO.

CHECK LIST

DIMENSIONS
BEARINGS
TIE TO NEAREST STREET
SUBLOT NO. PARCEL NO.
SURROUNDING OWNERS
BLDG DIMENSIONS FIN GR
BLDG TIES FLR GRADES
APRON TYPE WIDTH THICKNESS
SIDEWALK TYPE WIDTH THICKNESS
CULVERT TYPE DIA LENGTH

WATER MAIN SIZE LOCATION
SAN SEWER SIZE % GR LOC
SAN M.H. CAST ELEV INV ELEV
SAN CONN SIZE LOC DEPTH
STORM SEWER SIZE % GR LOC
STORM MH. CAST ELEV INV ELEV
PAVT TYPE GRADE CURBS
GAS LINE LOC SIZE PRESSURE
SEPTIC TANK SIZE LOC
WELL LOCATION

REVISIONS		
NO	DATE	BY
1		
2		
3		
4		
5		

PLAN PREPARED BY:
DEBEVEC-SALO & ASSOC, INC
NAME
130 EAST JACKSON ST, PAINESVILLE
ADDRESS

DRAWN BY JRZ	SCALE 1" = 40'	PHONE NO.
CHK'D	DATE MARCH '73	DRAWING NO. 3868
CREW CHIEF	APP'D	