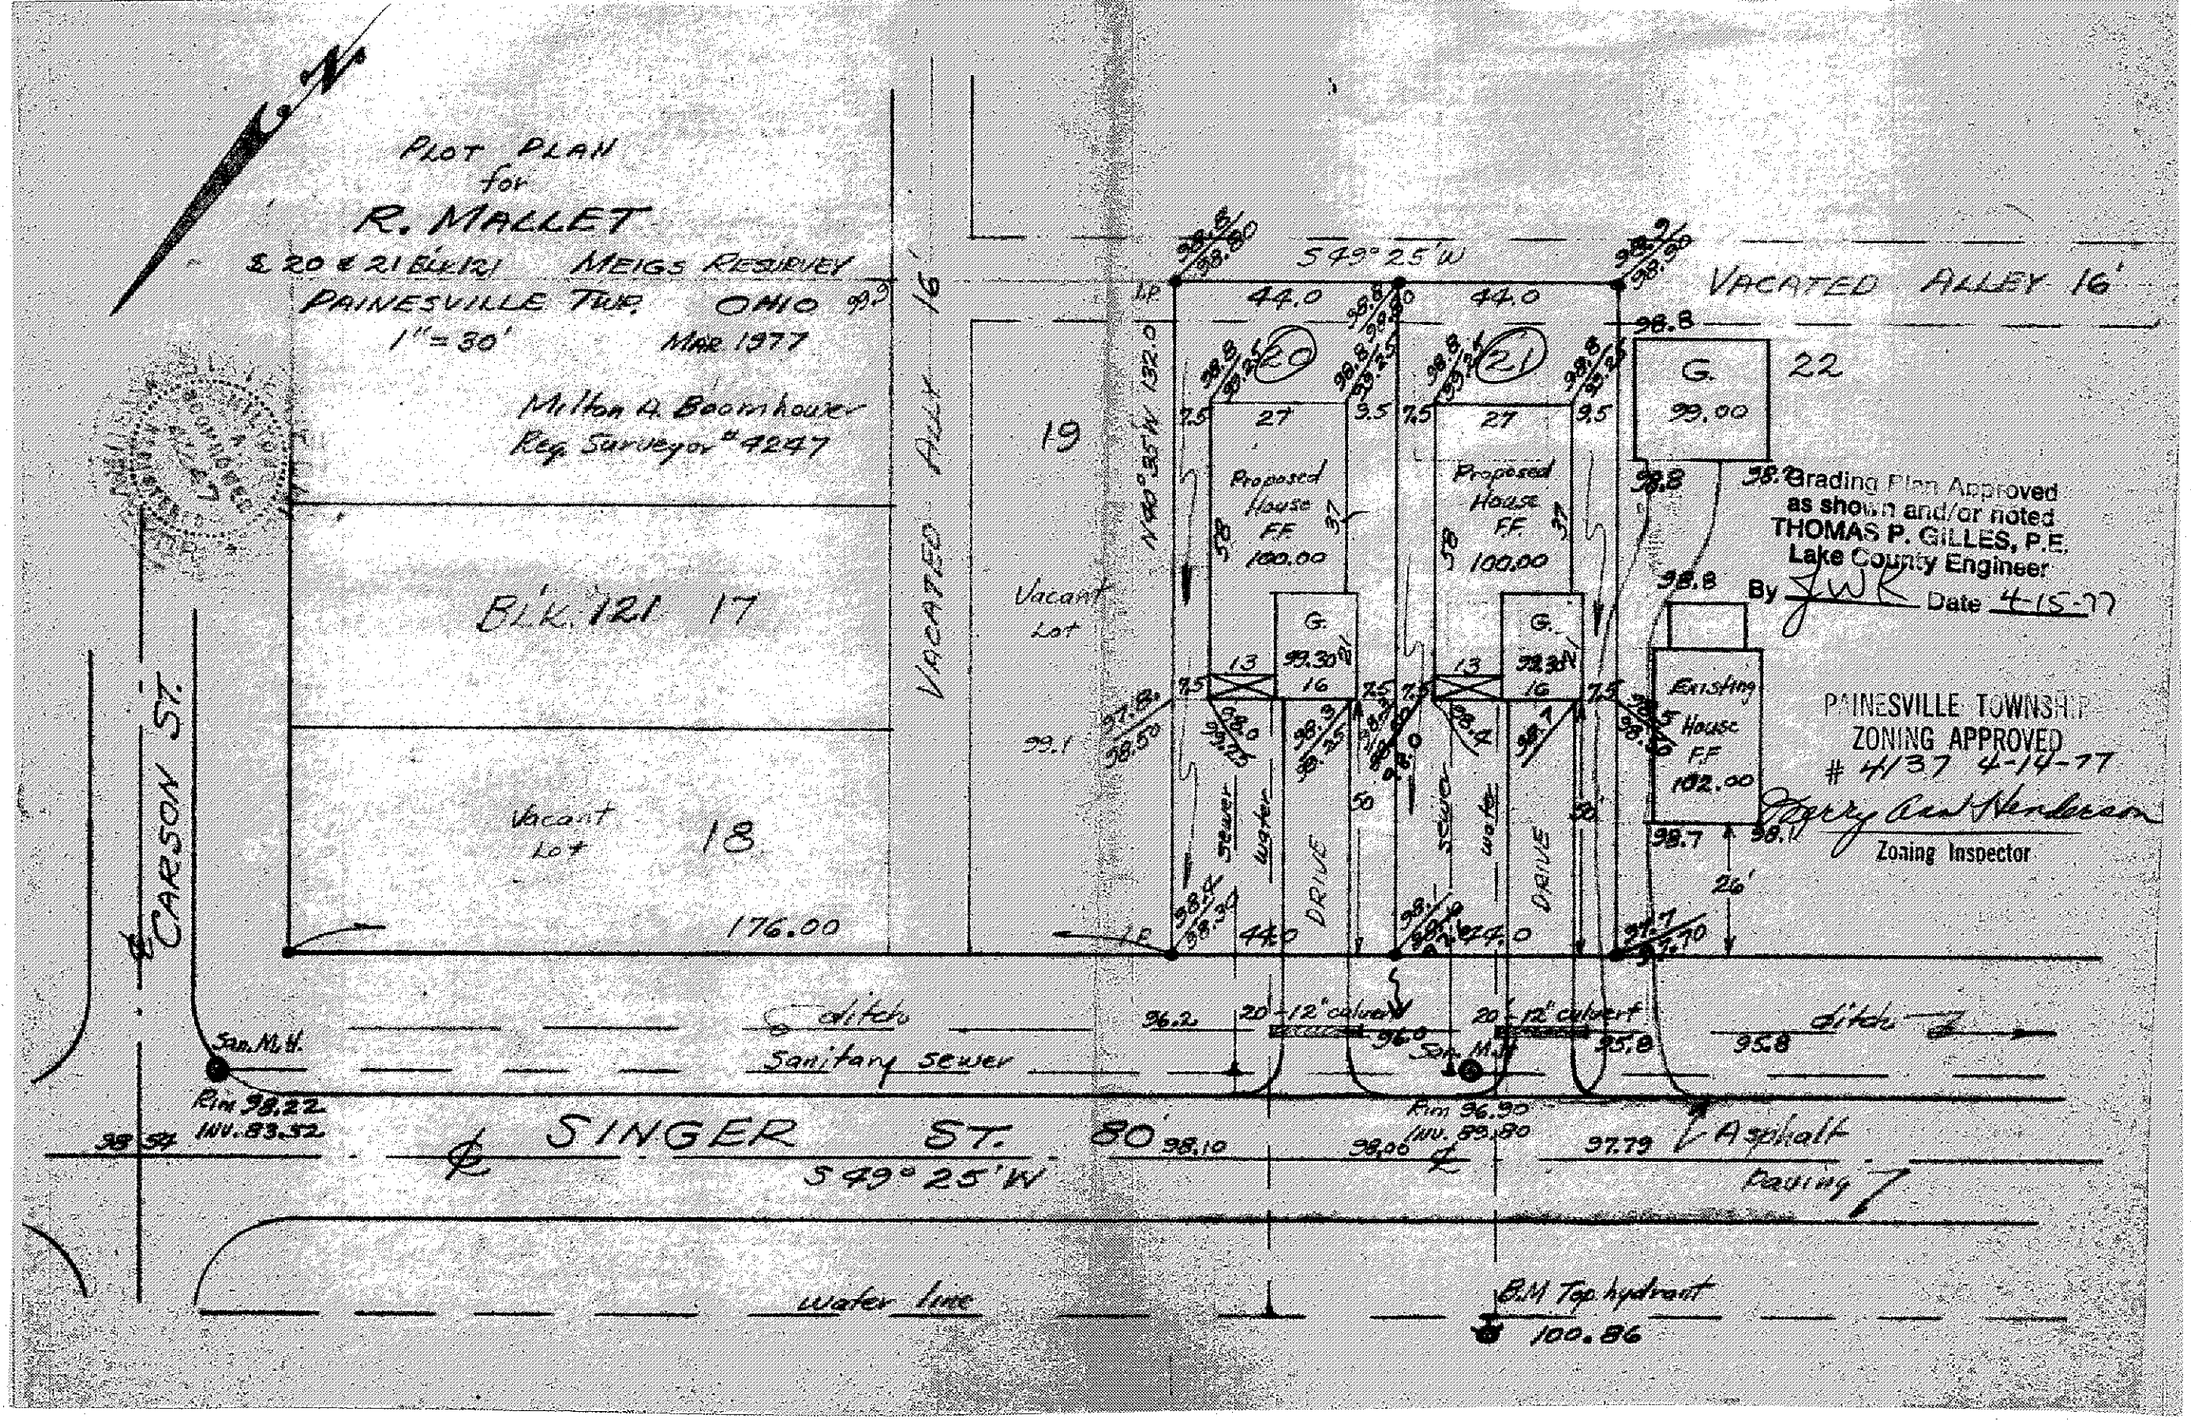
PLOT PLAN
for
R. MALLET
& 20 & 21 BLK 121 MEIGS RESURVEY
PAINESVILLE TWP. OHIO
1" = 30'
MAR 1977
Milton A. Boomhower
Reg. Surveyor #4247
N
BLK. 121
17
18
19
Vacant Lot
Vacant Lot
VACATED ALLEY 16'
VACATED ALLEY 16'
CARSON ST.
SINGER ST. 80'
S49° 25' W
N40° 35' W 132.0
176.00
99.1
44.0
44.0
44.0
44.0
27
27
Proposed House F.F. 100.00
Proposed House F.F. 100.00
Existing House F.F. 102.00
G. 99.30
G. 99.30
G. 99.00
22
20
21
16
13
7.5
3.5
9.5
26'
Grading Plan Approved as shown and/or noted
THOMAS P. GILLES, P.E.
Lake County Engineer
By JWR Date 4-15-77
PAINESVILLE TOWNSHIP
ZONING APPROVED
4137 4-14-77
Zoning Inspector
ditch
Sanitary sewer
20-12" culvert
20-12" culvert
ditch
San. M.H.
Rim 98.22
INV. 83.52
San. M.H.
Rim 96.90
INV. 89.80
Asphalt
Paving
Water line
B.M. Top hydrant
100.86
sewer
water
DRIVE
DRIVE