PAINESVILLE TOWNSHIP
ZONING O.K.
PENDING DRAINAGE

Zoning Inspector
8/3

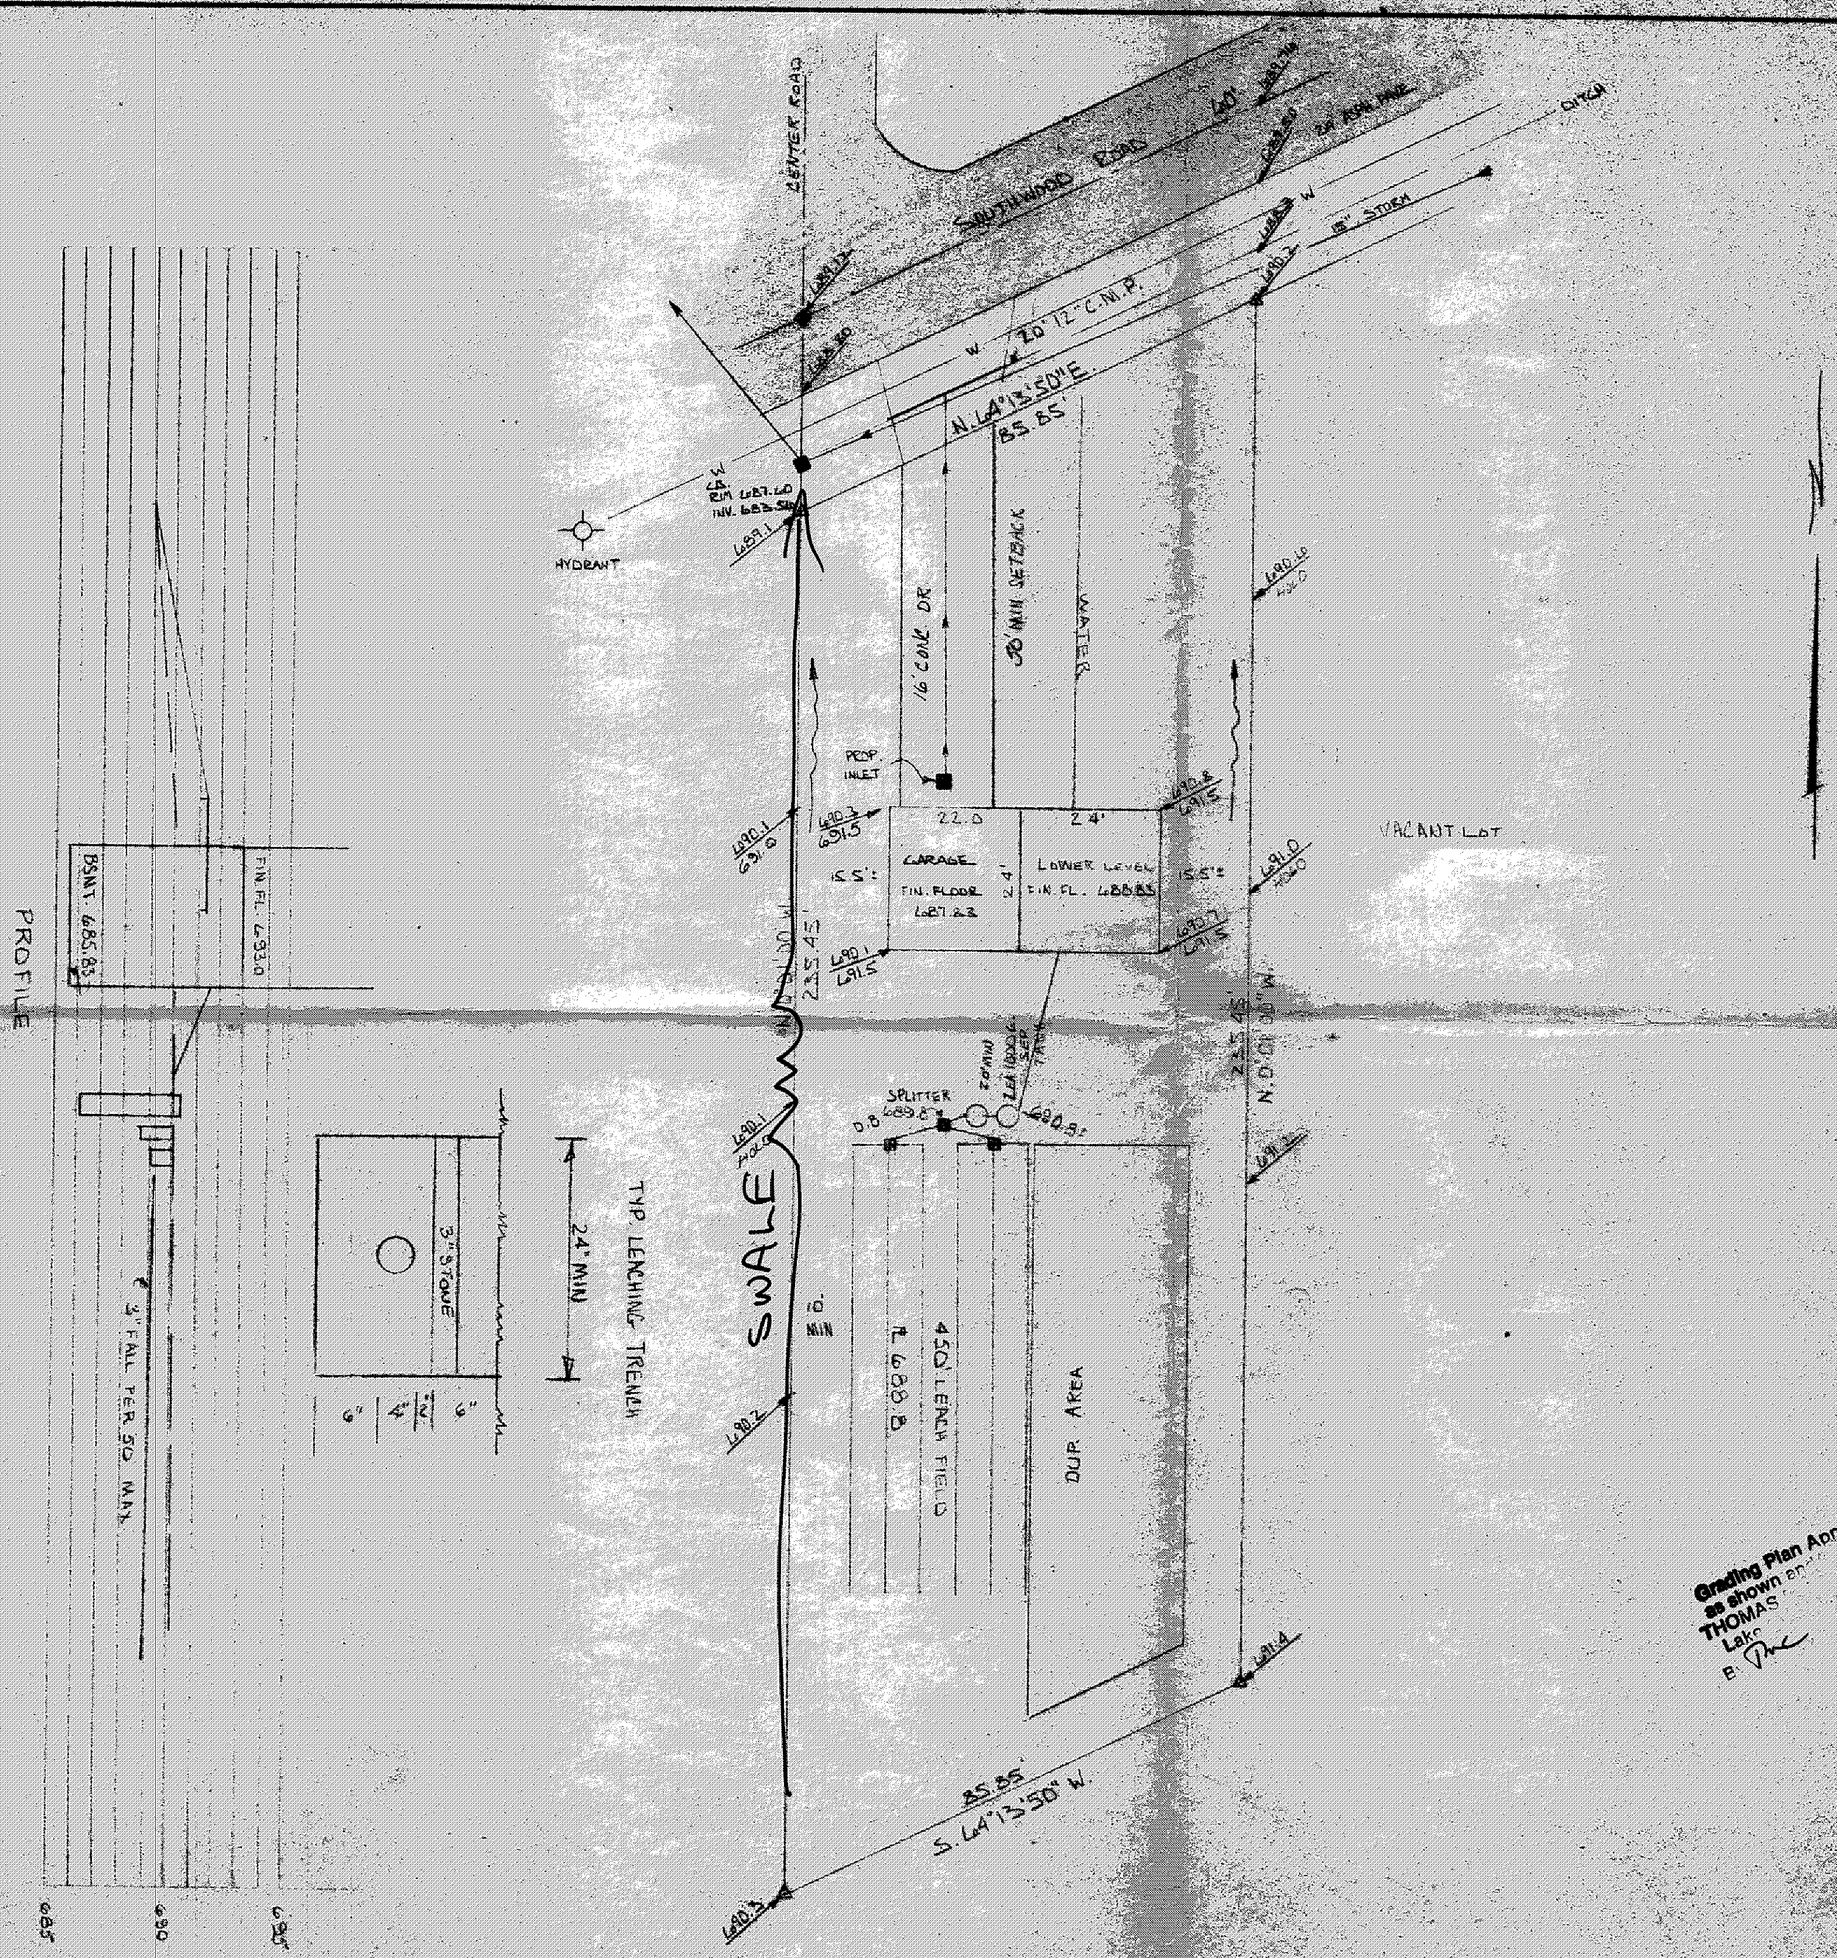


THIS PLAN WAS PREPARED BY ME AND IS CORRECT TO THE BEST OF MY KNOWLEDGE AND BELIEF.

REG SURVEYOR S-6356
7739 VIEWMOUNT DR.
CONCORD OHIO 44077
352-7742

Grading Plan Approved as shown
THOMAS
Lake
B.
9-1-78

SITE PLAN FOR
ROY SLAYTON BUILDERS

| | | |
|---|---|---|
| SCALE: 1"=20' | APPROVED BY: JCS | DRAWN BY: S.K. |
| DATE: 7-19-78 | | |
| SIL 22 SPRING LAKES SUBD. | | |
| PAINESVILLE TWP. LAKE COUNTY, OHIO | | DRAWING NUMBER: 78-223 |