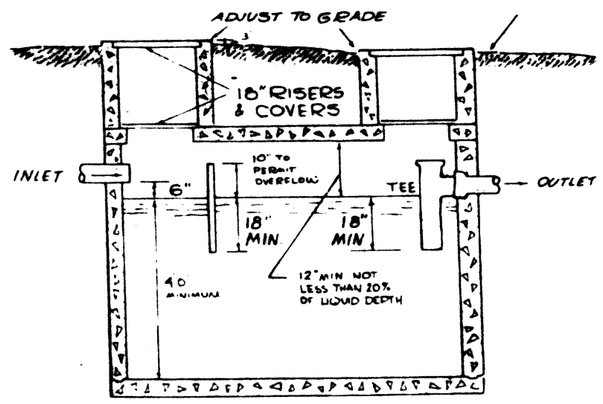

SECTION A-A

SEPTIC TANK

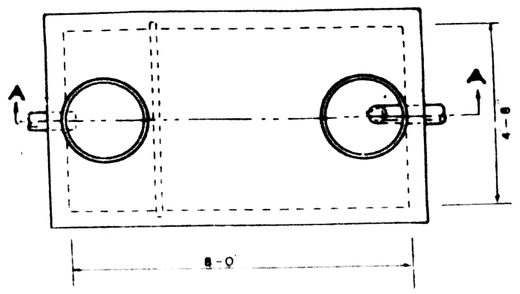

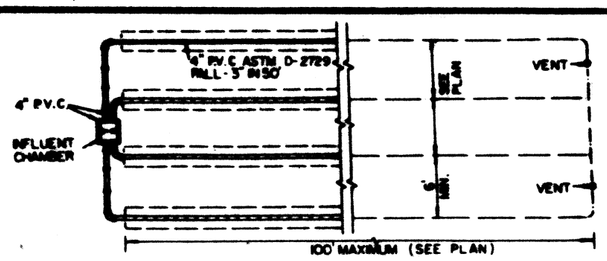

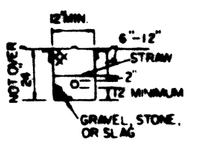

LEACHING TRENCH SECTION

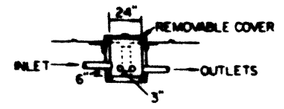

DISTRIBUTION BOX SECTION

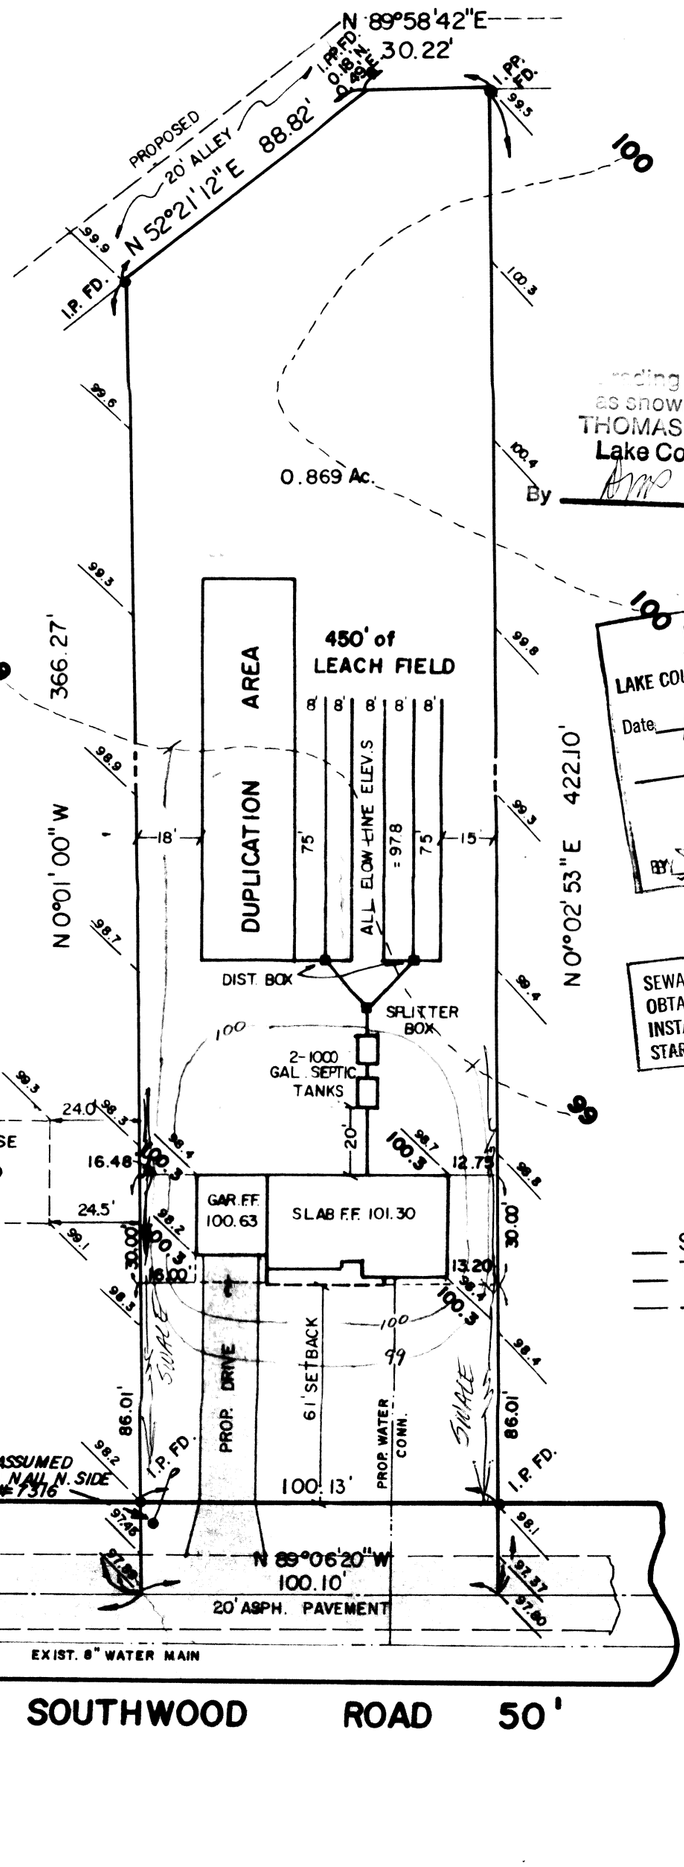

NOTES

1. DOWNSPOUTS SHOULD BE DIRECTED AWAY FROM THE SEWAGE SYSTEM.
2. NO CLAY SOIL SHOULD BE USED FOR COVER MATERIAL. TOPSOIL OR SODDING LAYED OVER THE SEWAGE SYSTEM SHOULD BE USED.

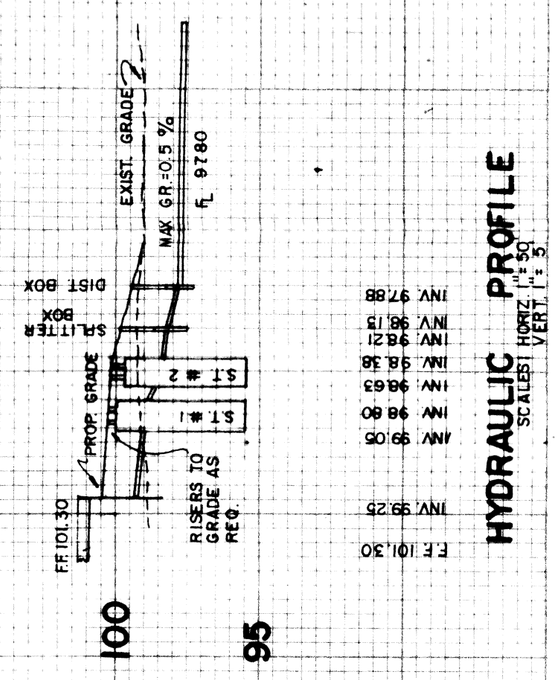

SITE PLAN

PAINESVILLE TOWNSHIP — LAKE COUNTY, OHIO

for: DONALD SPALLER (CLIENT / OWNER)

8000 DEEPWOOD BLVD. K-14, MENTOR, OH. 44060 (ADDRESS / STREET / CITY / ZIP)

SPRING LAKE EST. (PROPOSED) SUBDIVISION NAME		30 LOT	1 TRACT
		304 VOLUME	1345 PAGE
E. 1/2 26A SUBLOT NO.	VOL. - PG. SOUTHWOOD RD. STREET	11 B-34C-13 PERM. PARCEL NO.	SOUTHWOOD STREET

LEGEND

- SANITARY MANHOLE
- STORM MANHOLE
- INLET OR CATCH BASIN
- HYDRANT
- EXISTING CONTOURS
- PROPOSED CONTOURS
- EXIST. ELEV. 100.0 / 100.0 PROP. ELEV.
- WATER VALVE (GAS)
- WATER METER (GAS)
- AS BUILT ELEVATION 100.0
- INDICATES DIRECTION OF SURFACE DRAINAGE

REMARKS

ALL BOUNDARY DATA SHOWN WAS OBTAINED FROM (DEEDS, RECORDED SUBDIVISION PLAT OR OTHER PUBLIC RECORDS)

LOCATIONS AS SHOWN OF ADJACENT WELLS AND SEPTIC TANKS OBTAINED FROM LAKE COUNTY HEALTH DEPARTMENT

Grading Plan Approved as shown and/or noted
THOMAS P. GILLES, P.E.
Lake County Engineer
By _____ Date 10-14-87

Reviewed and Accepted
LAKE COUNTY GENERAL HEALTH DISTRICT
Date 10-14-87
JOEL LUCIA R. S., M. P. H.
Health Commissioner
By Derek B. Morris

STATE OF OHIO — BERNARD D. WESTFALL 6634 REGISTERED LAND SURVEYOR

DESIGN CERTIFICATION

THIS PLAT WAS PREPARED BY ME, AND IS CORRECT TO THE BEST OF MY KNOWLEDGE AND BELIEF.

Bernard D. Westfall 6634
NAME SURVEYOR REGISTRATION NO.

CHECK LIST

NO. OF BEDROOMS
DIMENSIONS
BEARINGS
TIE TO NEAREST STREET
SUBLOT NO. PARCEL NO.
SURROUNDING OWNERS
BLDG. DIMENSIONS FIN. GR.
BLDG. TIES FL'R. GRADES
APRON TYPE WIDTH THICKNESS
SIDEWALK TYPE WIDTH THICKNESS
CULVERT TYPE DIA., LENGTH
ROCK OUTCROPPINGS
WATER MAIN SIZE, LOCATION
SAN. SEWER SIZE % GR. LOC.
SAN. MH. CAST. ELEV. INV. ELEV.
SAN. CONN. SIZE, LOC. DEPTH
STORM SEWER SIZE % GR. LOC
STORM MH. CAST ELEV. INV. ELEV.
PAV'T TYPE GRADE CURBS
GAS LINE LOC. SIZE PRESSURE
SEPTIC TANK LOCATION & DUPLICATION AREA
WELL LOCATION
ISOLATION RADIUS FROM WELL

SEWAGE DISPOSAL PERMIT MUST BE OBTAINED BY A LAKE COUNTY LICENSED INSTALLER BEFORE INSTALLATION IS STARTED.

LOW YIELD WATER FIXTURES REQUIRED ON ALL:
___ Shower Head
___ Toilet
___ _____

REVISIONS		
NO.	DATE	BY
1		
2		
3		
4		
5		

PLAN PREPARED BY:
A'TERRA ENGINEERING & SURVEYING
170 N. ST. CLAIR PAINESVILLE, OHIO

DRAWN BY R.T	SCALE 1" = 40'	PHONE NO. 352-9250
CHK'D.	DATE OCT 1987	DRAWING NO. 870107-00
CREW CHIEF G.G. & E.W.	APP'D.	

"AS BUILT" CERTIFICATION

I, HEREBY CERTIFY THAT THE CIRCLED GRADES ARE EXISTING FINISH GRADES CHECKED IN THE FIELD ON _____, 19____ AND ARE CORRECT TO THE BEST OF MY KNOWLEDGE AND BELIEF.

REGISTERED SURVEYOR REG. NO.

A. To be brought to finished grade
   1. Septic tank manhole covers
   2. Splitter box cover
   3. Distribution box cover
   4. Vent Pipes
B. No footer drains or downspouts to be discharged into septic tanks
C. All waste water to be discharged into septic tanks

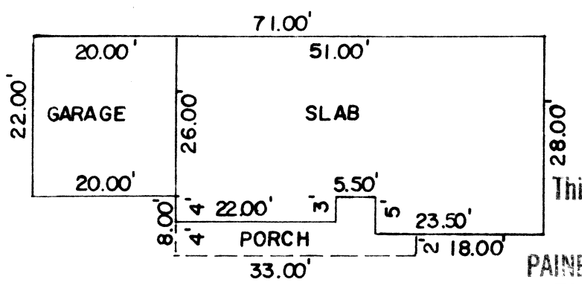

FOUNDATION DETAIL
SCALE 1"=20'

This Permit Expires 10-14-88

PAINESVILLE TOWNSHIP ZONING APPROVED # 6814
W. E. Messenger Zoning Inspector 10/14/87