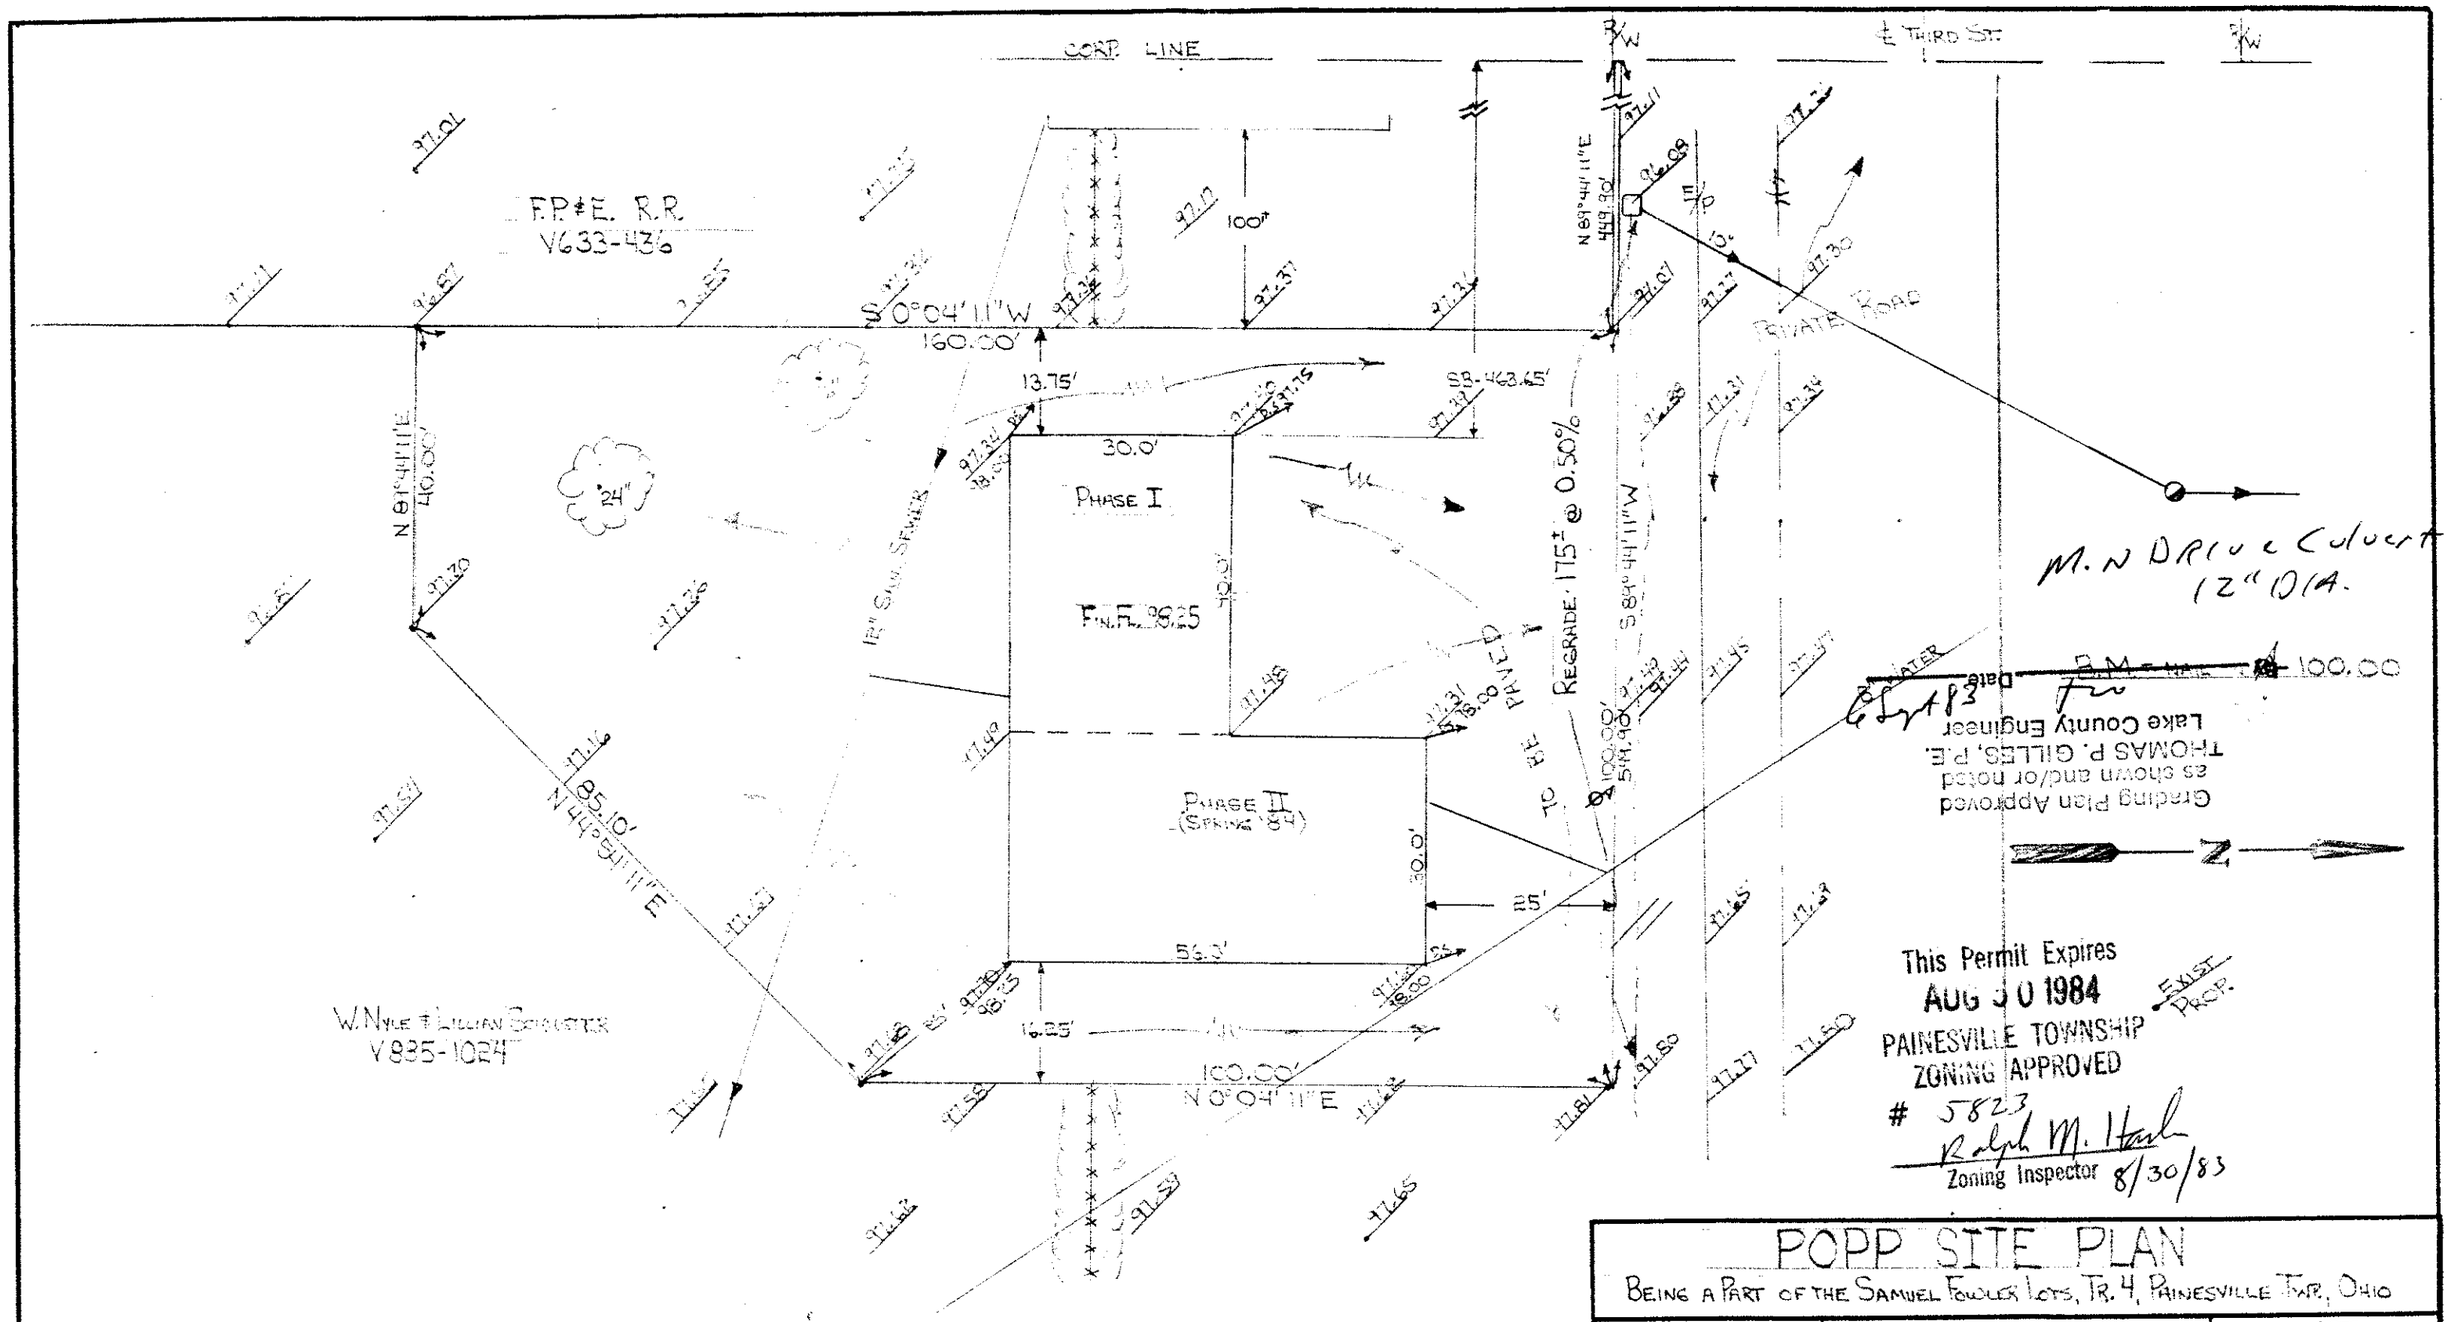


# POPP SITE PLAN

BEING A PART OF THE SAMUEL FOWLER LOTS, TR. 4, PAINESVILLE TWP., OHIO

| | | |
|---|---|---|
| SCALE: 1" = 20' | APPROVED BY M | DRAWN BY M |
| DATE: AUG. 21, 1983 | | |

THIS PLAT WAS PREPARED BY ME AND IS ACCURATE TO THE BEST OF MY KNOWLEDGE AND BELIEF.

Thomas M. Coleman #7857
REG. SURVEYOR

DRAWING NUMBER
831601