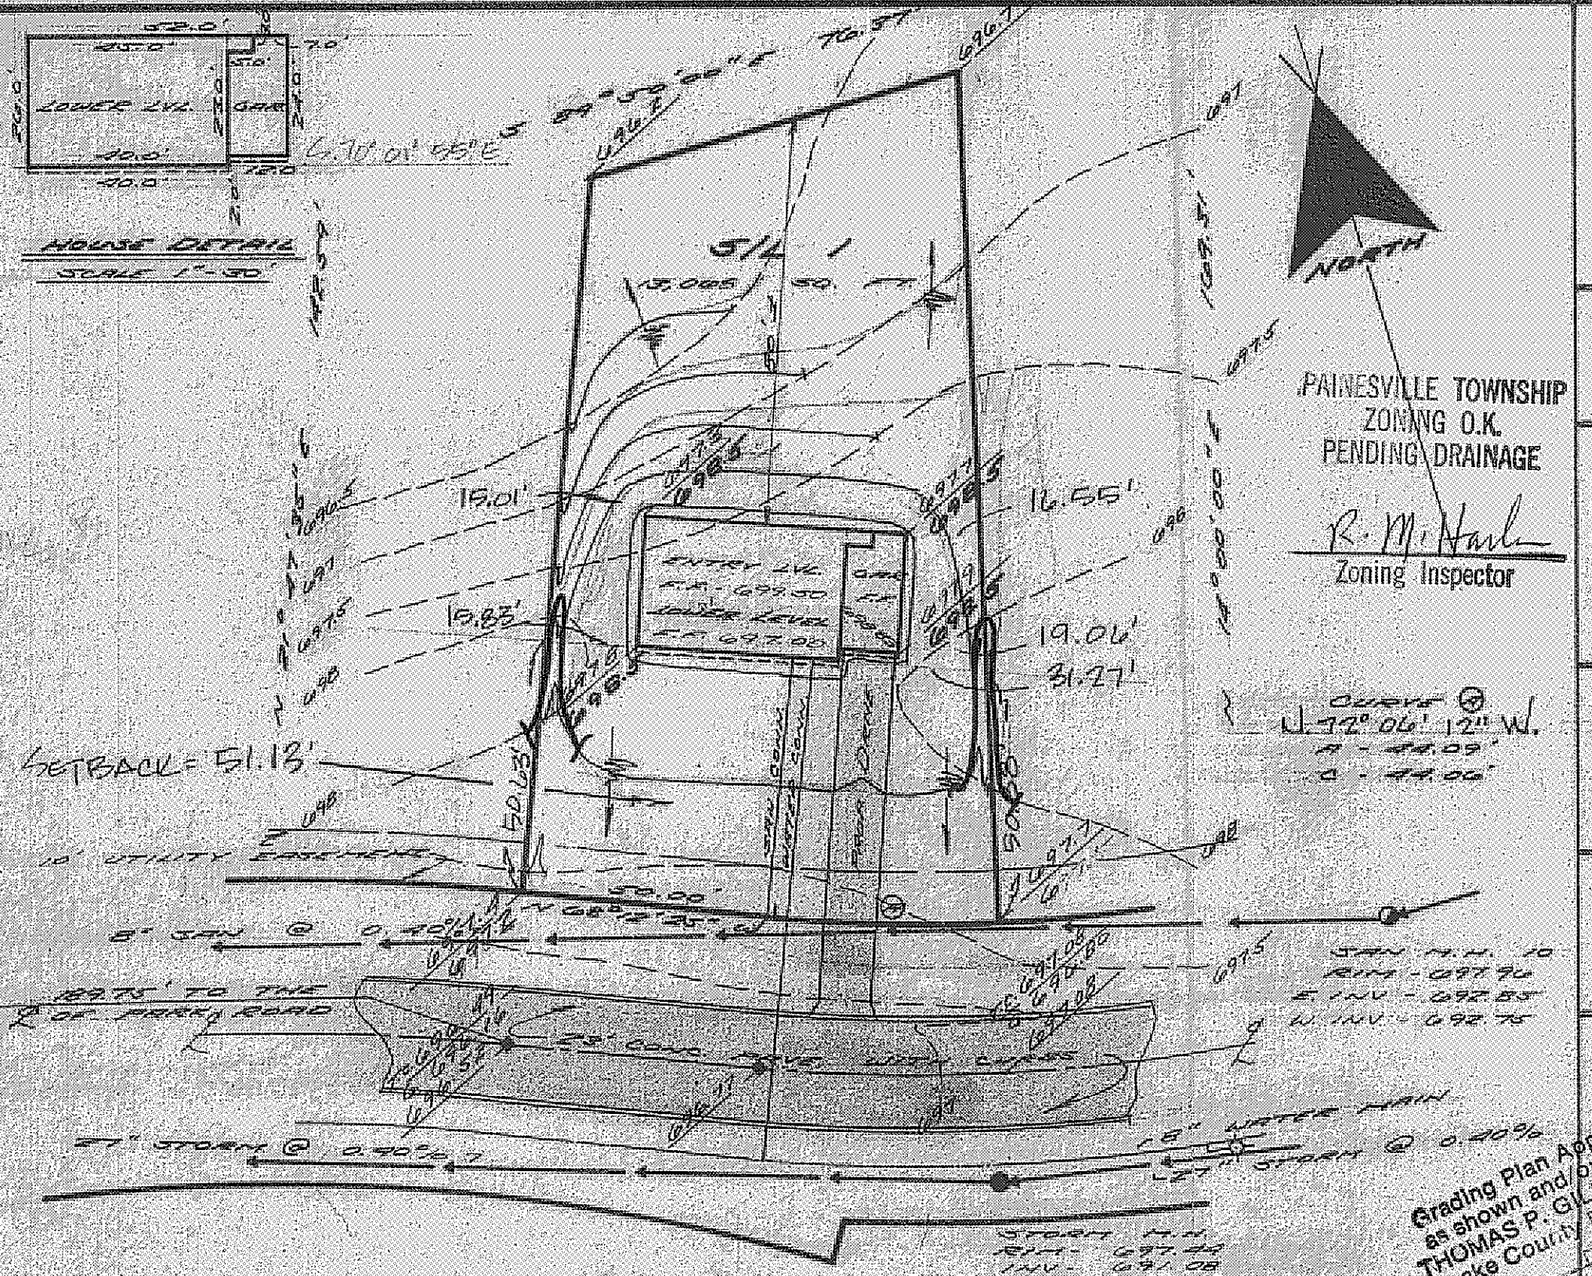


PAINESVILLE TOWNSHIP
ZONING O.K.
PENDING DRAINAGE

R. M. Harle
Zoning Inspector

Grading Plan Approved as shown and/or
THOMAS P. GILL
Lake County
By

T.B.M. - RIM OF MON. BOX AT INTERSECTION OF TROTTER LANE & BRIDLE PATH AVENUES.
ELEV. 698.45

"AS BUILT" CERTIFICATION

I, HEREBY CERTIFY THAT THE CIRCLED GRADES ARE EXISTING FINISH GRADES CHECKED IN THE FIELD ON _____, 19__ AND ARE CORRECT TO THE BEST OF MY KNOWLEDGE AND BELIEF.

REGISTERED SURVEYOR _____ REG. NO. _____

# SITE PLAN

PAINESVILLE TOWNSHIP — LAKE COUNTY, OHIO

for: RYAN HOMES
CLIENT — OWNER

ADDRESS — STREET — CITY — ZIP

SIERRA SUBD.
SUBDIVISION — NAME
VOL. - PG.
1 — TROTTER LANE
SUBLOT NO. — STREET

LOT — TRACT
VOLUME — PAGE
PERM. PARCEL NO. — STREET

## LEGEND

SANITARY MANHOLE
STORM MANHOLE
INLET OR CATCH BASIN
HYDRANT
EXISTING CONTOURS
PROPOSED CONTOURS
EXIST. ELEV. 100.0 / 100.0 PROP. ELEV.

WATER VALVE (GAS)
WATER METER (GAS)
AS BUILT ELEVATION 100.0
INDICATES DIRECTION OF SURFACE DRAINAGE

## REMARKS

ALL BOUNDARY DATA SHOWN WAS OBTAINED FROM (DEEDS, RECORDED SUBDIVISION PLAT OR OTHER PUBLIC RECORDS)

LOCATIONS AS SHOWN OF ADJACENT WELLS AND SEPTIC TANKS OBTAINED FROM LAKE COUNTY HEALTH DEPARTMENT

## DESIGN CERTIFICATION

THIS PLAT WAS PREPARED BY ME, AND IS CORRECT TO THE BEST OF MY KNOWLEDGE AND BELIEF.

[signature] PS # 6528
NAME — SURVEYOR — REGISTRATION NO.

## CHECK LIST

NO. OF BEDROOMS
DIMENSIONS
BEARINGS
TIE TO NEAREST STREET
SUBLOT NO. PARCEL NO.
SURROUNDING OWNERS
BLDG. DIMENSIONS FIN. GR.
BLDG. TIES FL.R. GRADES
APRON TYPE WIDTH THICKNESS
SIDEWALK TYPE WIDTH THICKNESS
CULVERT TYPE DIA., LENGTH
ROCK OUTCROPPINGS

WATER MAIN SIZE, LOCATION
SAN. SEWER SIZE % GR. LOC.
SAN. MH. CAST. ELEV. INV. ELEV.
SAN. CONN. SIZE, LOC. DEPTH
STORM SEWER SIZE % GR. LOC.
STORM MH. CAST ELEV. INV. ELEV.
PAV'T TYPE GRADE CURBS
GAS LINE LOC. SIZE PRESSURE
SEPTIC TANK LOCATION & DUPLICATION AREA
WELL LOCATION
ISOLATION RADIUS FROM WELL

| REVISIONS | | |
|---|---|---|
| NO. | DATE | BY |
| 1 | | |
| 2 | | |
| 3 | | |
| 4 | | |
| 5 | | |

PLAN PREPARED BY:

DEBEVEC • SALO & ASSOCIATES, INC.
125 E. ERIE ST. PAINESVILLE, OHIO
JAN 29 1979

| DRAWN BY | SCALE | PHONE NO. |
|---|---|---|
| L.L. | 1" = 30' | 352-9250 |
| CHK'D. | DATE 1/26/79 | DRAWING NO. |
| CREW CHIEF | APP'D. | 5014-1 |