4278 10-18-77
PAINESVILLE TOWNSHIP
ZONING APPROVED
# Bird Box Appeals
Zoning Inspector

**Grading Plan Approved as shown and/or noted**
**THOMAS P. GILLES, P.E**
**Lake County Engineer**
By TPG Date 26 Oct 77

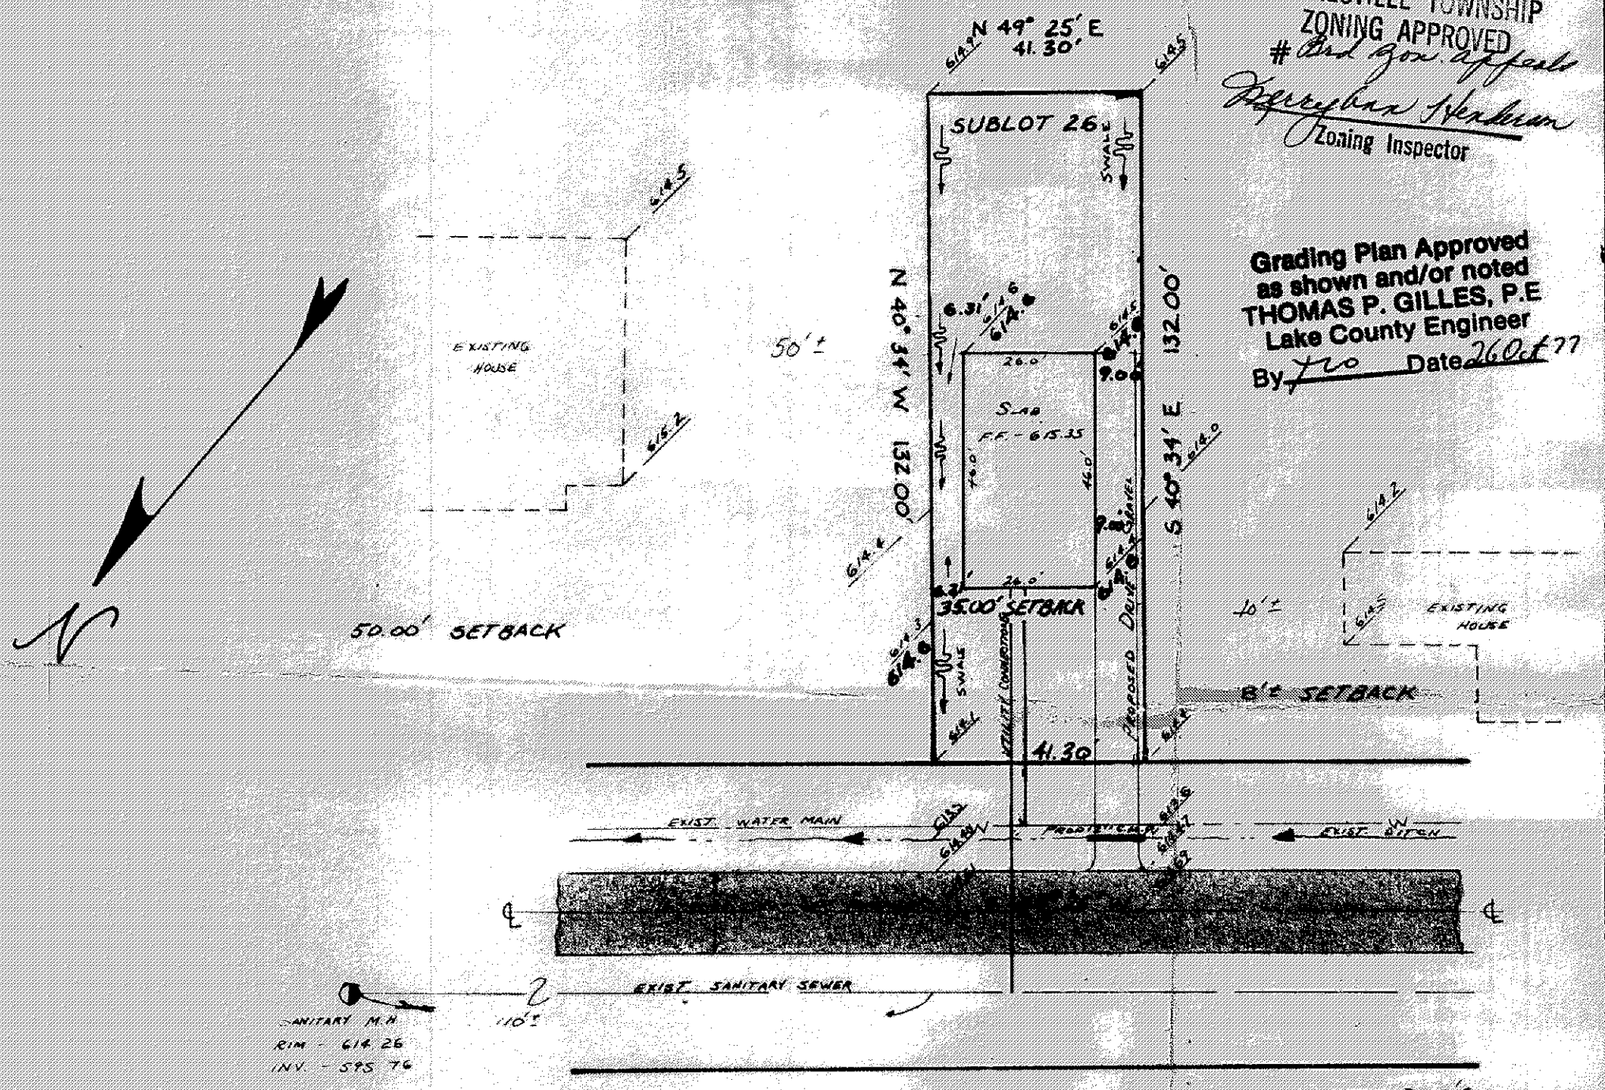


# SITE PLAN

PAINESVILLE TOWNSHIP — LAKE COUNTY, OHIO

**for:** BILL BARBIS (CLIENT / OWNER)

ADDRESS — STREET — CITY — ZIP

| | |
|---|---|
| J. FRANK POLLOCK SUBD. (SUBDIVISION) | LOT / TRACT |
| H - 121 (VOL. - PG.) | VOLUME / PAGE |
| 26 (SUBLOT NO.) | WETMORE (STREET) |
| PERM. PARCEL NO. | STREET |

## LEGEND

| | |
|---|---|
| SANITARY MANHOLE | WATER VALVE (GAS) |
| STORM MANHOLE | WATER METER (GAS) |
| INLET OR CATCH BASIN | AS BUILT ELEVATION (100.0) |
| HYDRANT | INDICATES DIRECTION OF SURFACE DRAINAGE |
| EXISTING CONTOURS | |
| PROPOSED CONTOURS | |
| EXIST. ELEV. 100.0 / 100.0 PROP. ELEV. | |

## REMARKS

ALL BOUNDARY DATA SHOWN WAS OBTAINED FROM (DEEDS, RECORDED SUBDIVISION PLAT OR OTHER PUBLIC RECORDS)

LOCATIONS AS SHOW OF ADJACENT WELLS AND SEPTIC TANKS OBTAINED FROM LAKE COUNTY HEALTH DEPARTMENT

## DESIGN CERTIFICATION

THIS PLAT WAS PREPARED BY ME, AND IS CORRECT TO THE BEST OF MY KNOWLEDGE AND BELIEF.

NAME — SURVEYOR — REGISTRATION NO. 4593

## CHECK LIST

- NO. OF BEDROOMS
- DIMENSIONS
- BEARINGS
- TIE TO NEAREST STREET
- SUBLOT NO. PARCEL NO.
- SURROUNDING OWNERS
- BLDG. DIMENSIONS FIN. GR.
- BLDG. TIES FL'R. GRADES
- APRON TYPE WIDTH THICKNESS
- SIDEWALK TYPE WIDTH THICKNESS
- CULVERT TYPE DIA., LENGTH
- ROCK OUTCROPPINGS
- WATER MAIN SIZE, LOCATION
- SAN. SEWER SIZE % GR. LOC.
- SAN. MH. CAST. ELEV. INV. ELEV.
- SAN. CONN. SIZE, LOC. DEPTH
- STORM SEWER SIZE % GR. LOC.
- STORM MH. CAST ELEV. INV. ELEV.
- PAV'T TYPE GRADE CURBS
- GAS LINE LOC. SIZE PRESSURE
- SEPTIC TANK LOCATION & DUPLICATION AREA
- WELL LOCATION
- ISOLATION RADIUS FROM WELL

## "AS BUILT" CERTIFICATION

I, HEREBY CERTIFY THAT THE CIRCLED GRADES ARE EXISTING FINISH GRADES CHECKED IN FIELD ON ____ 19 ____ BY ____ SURVEYING AND ARE CORRECT TO THE BEST OF MY KNOWLEDGE AND BELIEF.

REGISTERED SURVEYOR — REG. NO.

| REVISIONS | | |
|---|---|---|
| NO. | DATE | BY |
| 1 | 9-9-77 | L.L. |
| 2 | | |
| 3 | | |
| 4 | | |
| 5 | | |

**PLAN PREPARED BY:**

DEBEVEC · SALO & ASSOCIATES, INC.

130 EAST JACKSON ST. PAINESVILLE, OHIO

| | | |
|---|---|---|
| DRAWN BY L.L. | SCALE 1" = 30' | PHONE NO. 352-9250 |
| CHK'D. | DATE 8-17-77 | DRAWING NO. 4957-26 |
| CREW CHIEF | APP'D. | |